


AR Architecture, LLC.

7700 CONGRESS AVE., SUITE #1117  
BOCA RATON, FLORIDA 33487  
PH. 561.241.6376 CELL: 305.519.1178  
adam@ar-architecturefirm.com

ALL DRAWINGS, SPECIFICATIONS AND RELATED DOCUMENTS ARE THE COPYRIGHT PROPERTY OF THE ARCHITECT AND MUST BE RETURNED UPON REQUEST. REPRODUCTION OF DRAWINGS, SPECIFICATIONS AND RELATED DOCUMENTS IN PART OR WHOLE IS FORBIDDEN WITHOUT THE ARCHITECT'S WRITTEN PERMISSION.

CONTRACTOR MUST CHECK AND VERIFY ALL DIMENSIONS AND FIELD CONDITIONS AND NOTIFY ARCHITECT/ENGINEER IMMEDIATELY OF ANY DISCREPANCIES.

NO.	DATE	REVISION

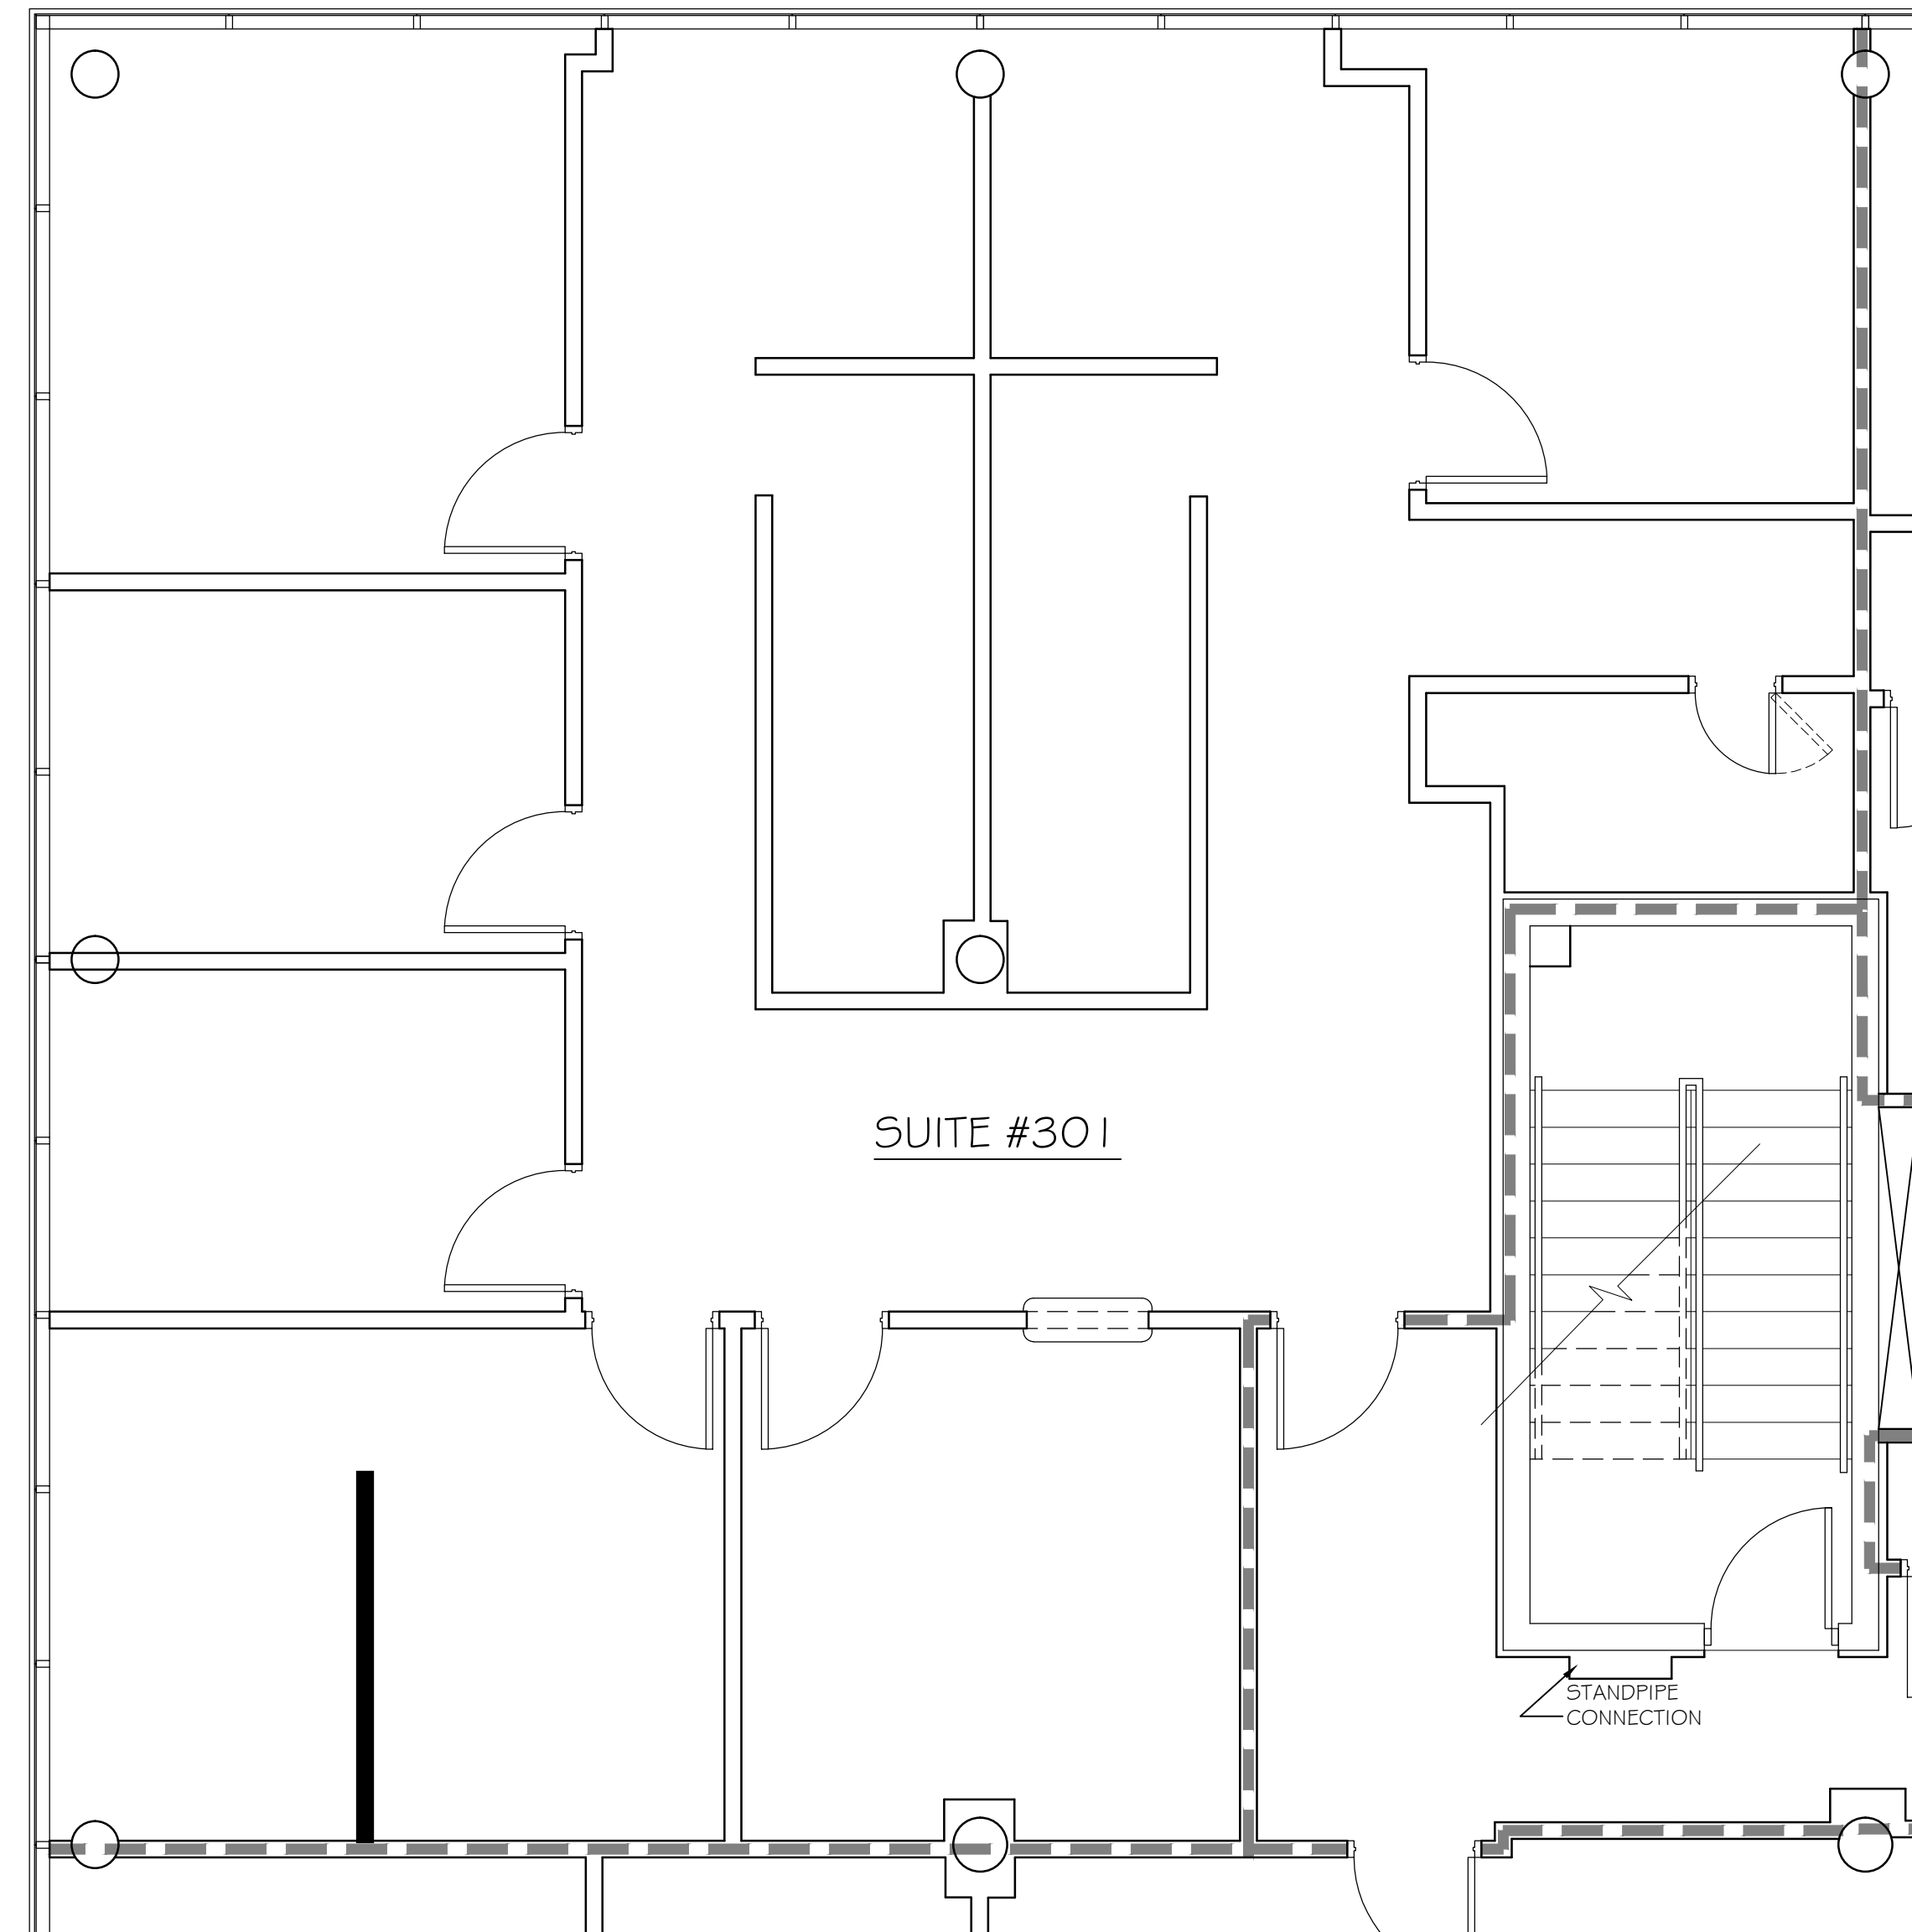

**AS-BUILTS**  
*Existing Conditions*  
 2151 W. Hillsboro Blvd.  
 3rd Floor  
 Deerfield Beach, Florida 33442

DIRECTION:	ADAM RYDZEWSKI FLORIDA REGISTERED ARCHITECT REGISTRATION NO. AR0066193
SEAL:	

ISSUED DATE:	2021-07-23	DRAWN BY:	T.S.
--------------	------------	-----------	------

DATE PRINTED:	2021-08-11	CHECKED BY:	A.R.
---------------	------------	-------------	------

SCALE:	AS NOTED	PROJECT NO.:	21-159
--------	----------	--------------	--------

TITLE:  
 EXISTING  
 FLOOR PLAN  
 - SUITE #301

DRAWING NO.  
**A-3.2**