


# 641 LEXINGTON AVENUE

RUDIN

**Floor 28  
As Built Plan**

**6,690 Sq. Ft.  
Entire Floor Available  
December 1, 2026**

**Asking \$75 per RSF**

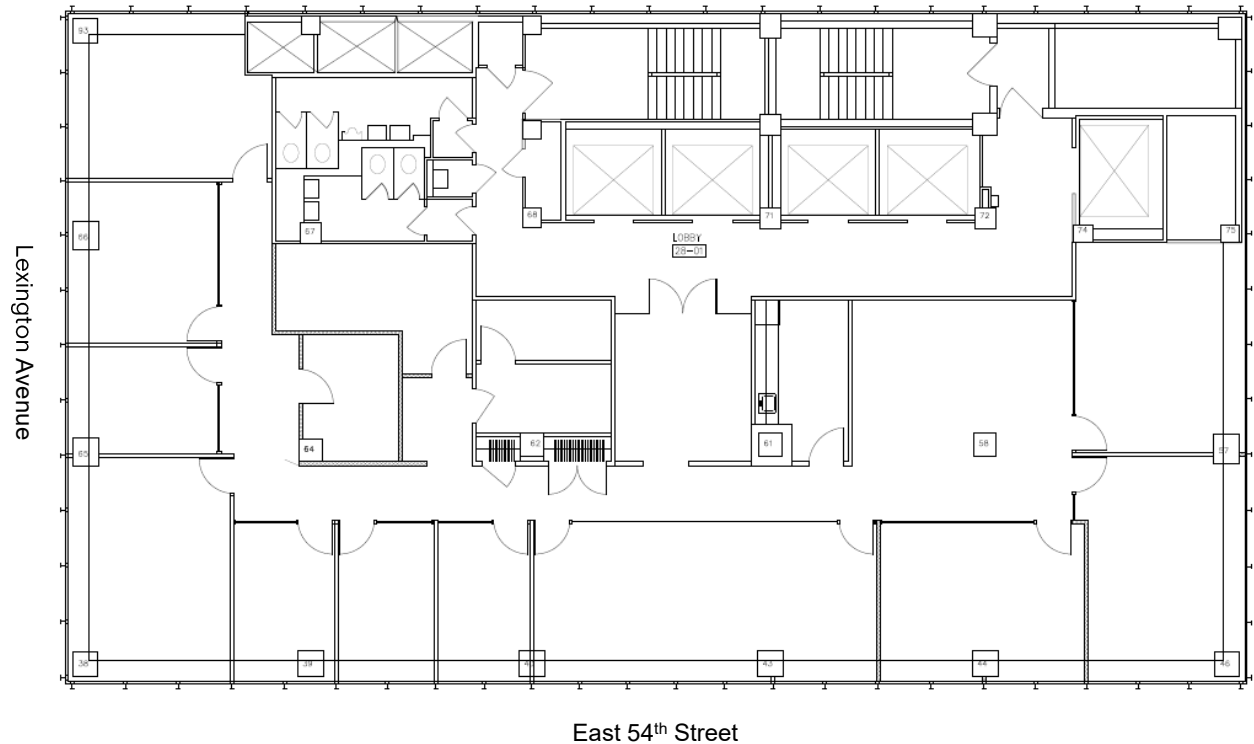

**Robert Steinman**

212.407.2490  
rsteinman@rudin.com

[rudin.com](http://rudin.com)


# 641 LEXINGTON AVENUE

RUDIN

**Floor 28  
Core and Shell Plan**

**6,690 Sq. Ft.  
Entire Floor Available  
December 1, 2026**

**Asking \$75 per RSF**

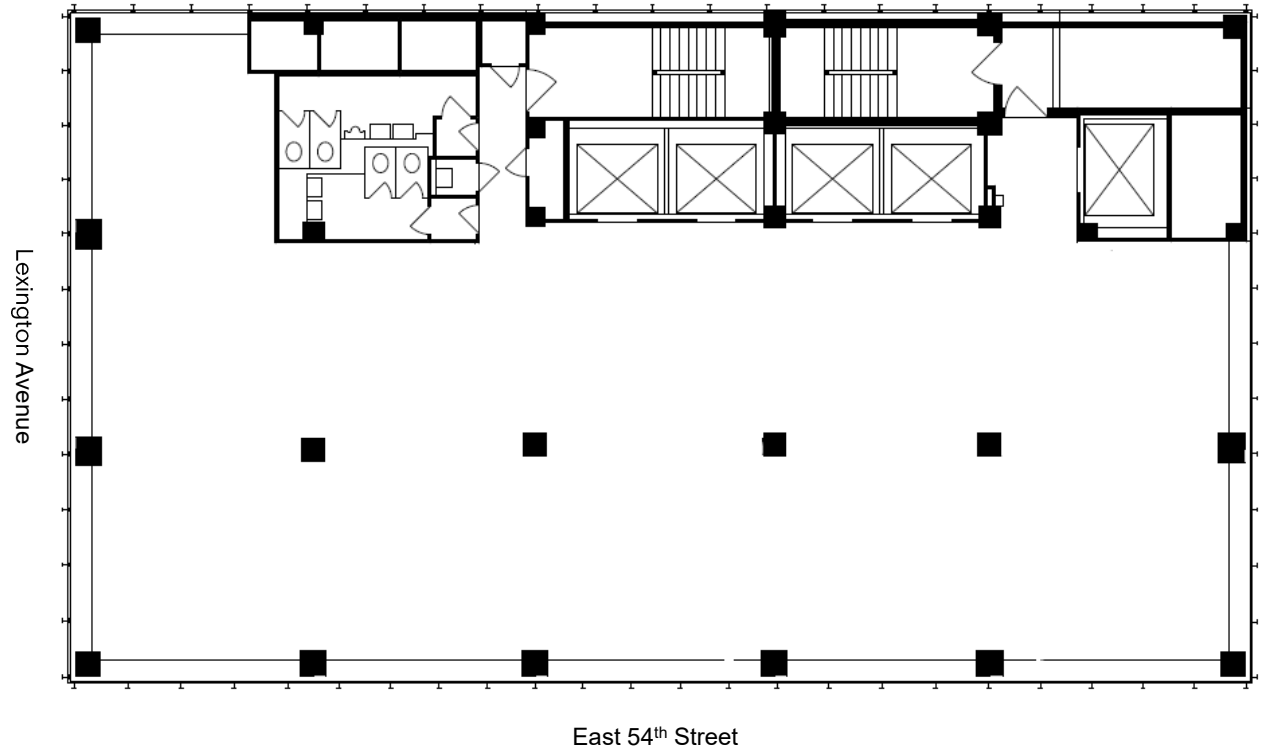

**Robert Steinman**

212.407.2490  
rsteinman@rudin.com

[rudin.com](http://rudin.com)