
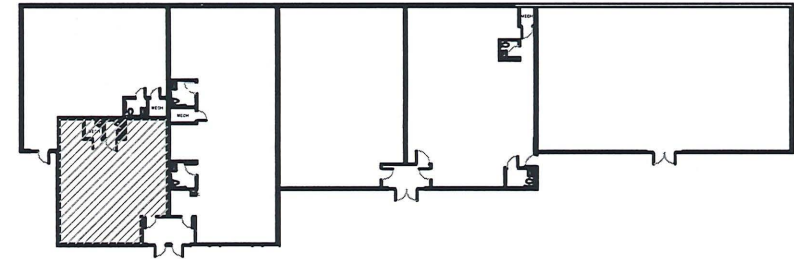


Davis Enterprises

5000 Sagemore Drive, Marlton, NJ 08053

05/15/19

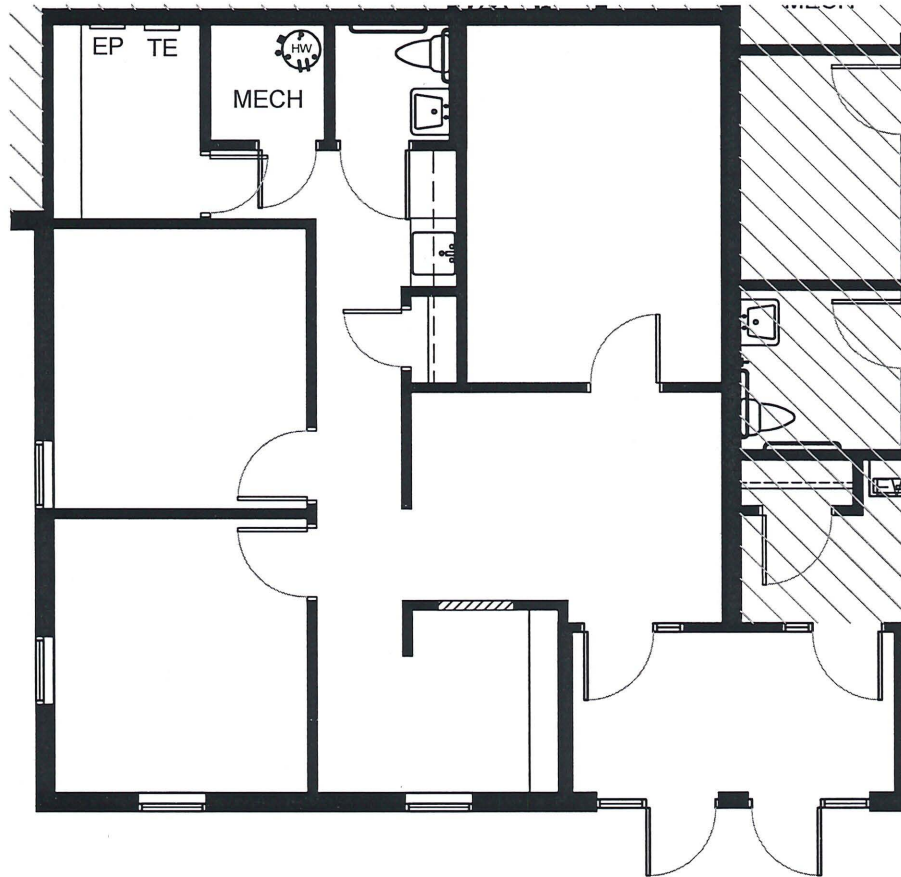

Key Plan
Not to Scale

Record Drawing

Scale: 1/8" = 1'-0"

EXHIBIT 'A' & 'B'

PRELIMINARY - NOT FOR CONSTRUCTION

RD1
/01 **Suite 201**
19.19033.05 / LSK

NELSON

NELSONworldwide.com