
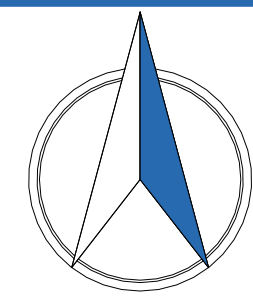


Property Key

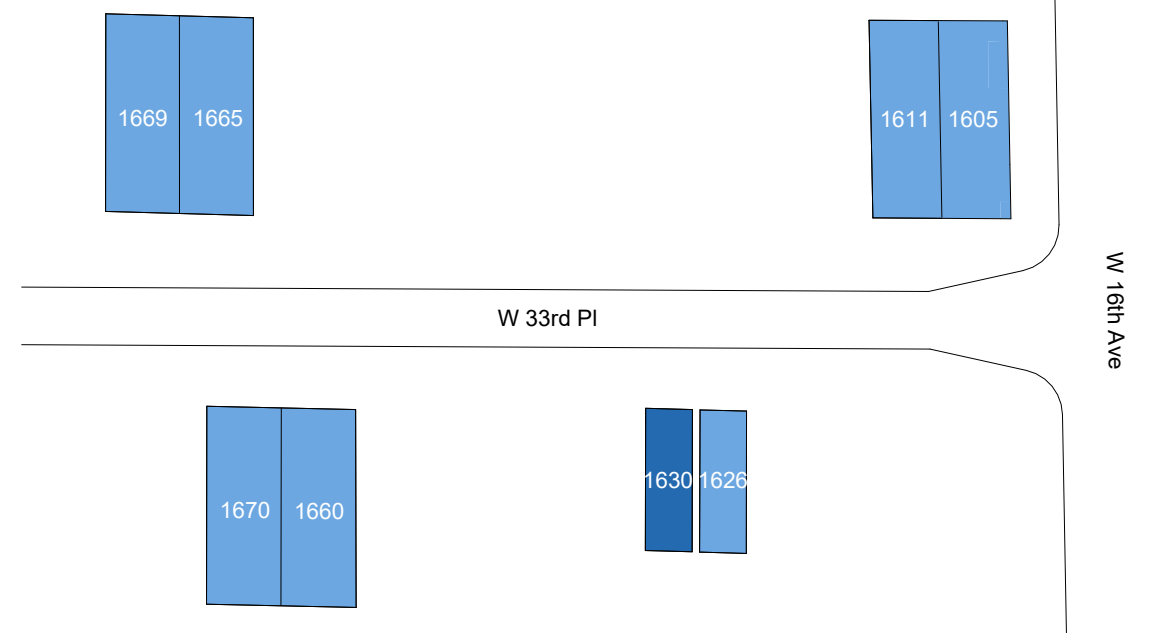


Hialeah Buildings

1630 W 33rd St, Hialeah, FL 33012

Building: 18

Suite: 1630

Sheet **E1**

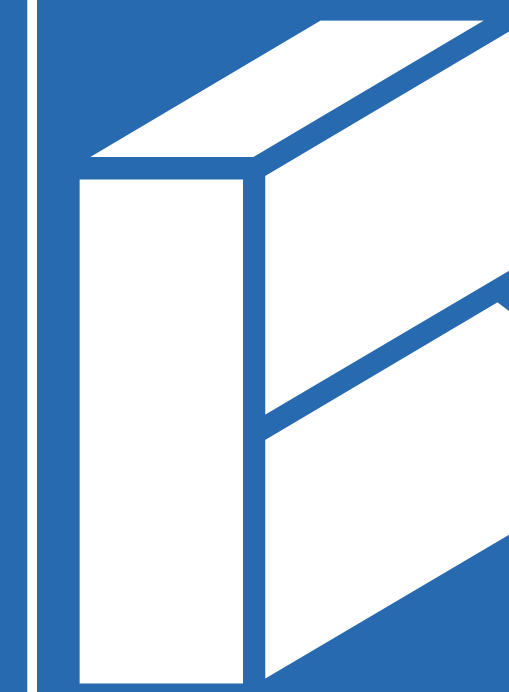

BAY SPACE


Scale: Not to Scale
Sheet Size: 42" x 30"
Not For Construction

Usable Square Foot Analysis

	SQFT	BUILDING PERCENTAGE
Office Area	0	0%
Warehouse Area	0	0%
Total Area	0	

Building Information

Deck Height:	14' - 9 1/4"
Clear Height:	12' - 5 1/4"
Ceiling Height:	7' - 7 3/4"
Sprinklered:	<input type="checkbox"/> Yes <input checked="" type="checkbox"/> No
Mechanical Area:	0 SQFT

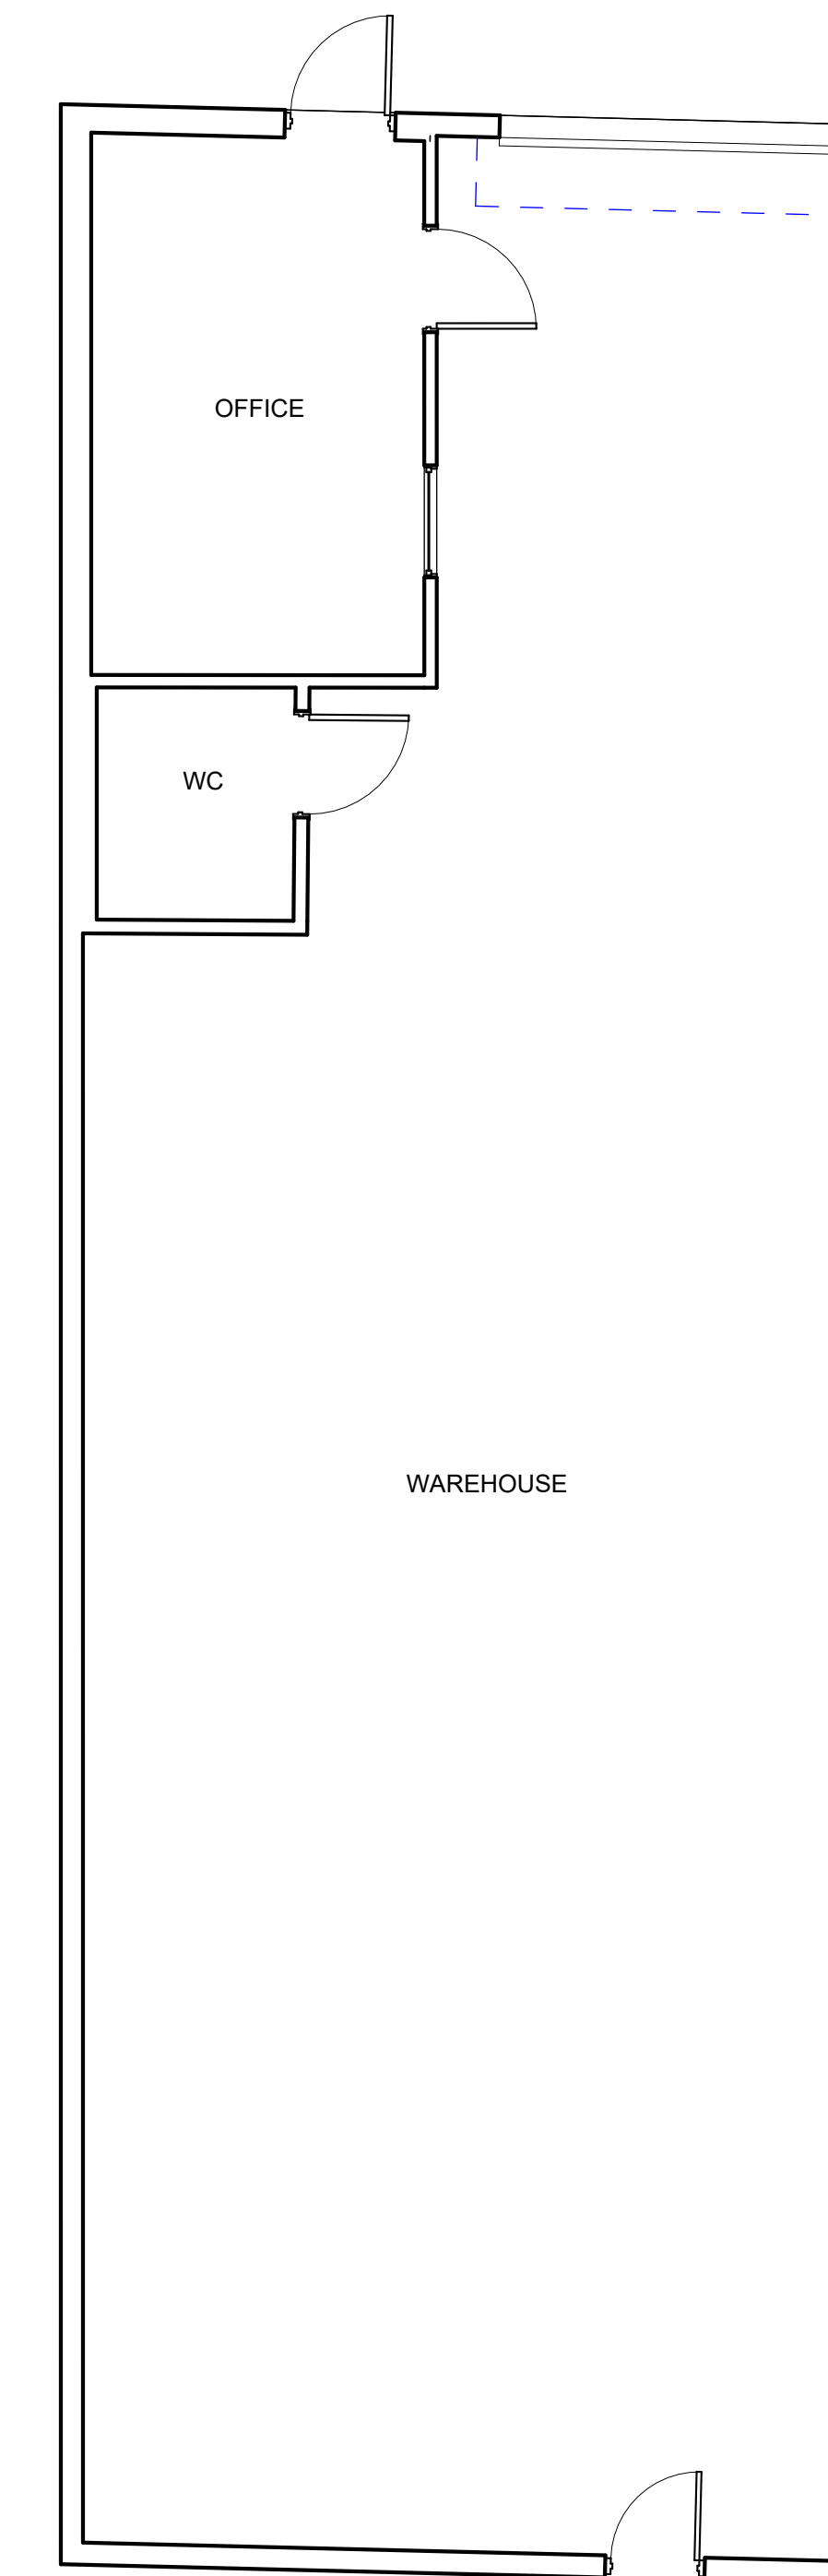

① 1630
3/16" = 1'-0"

As Built Floor Plan for Marketing

