


9/3/2026 7:15:22 PM

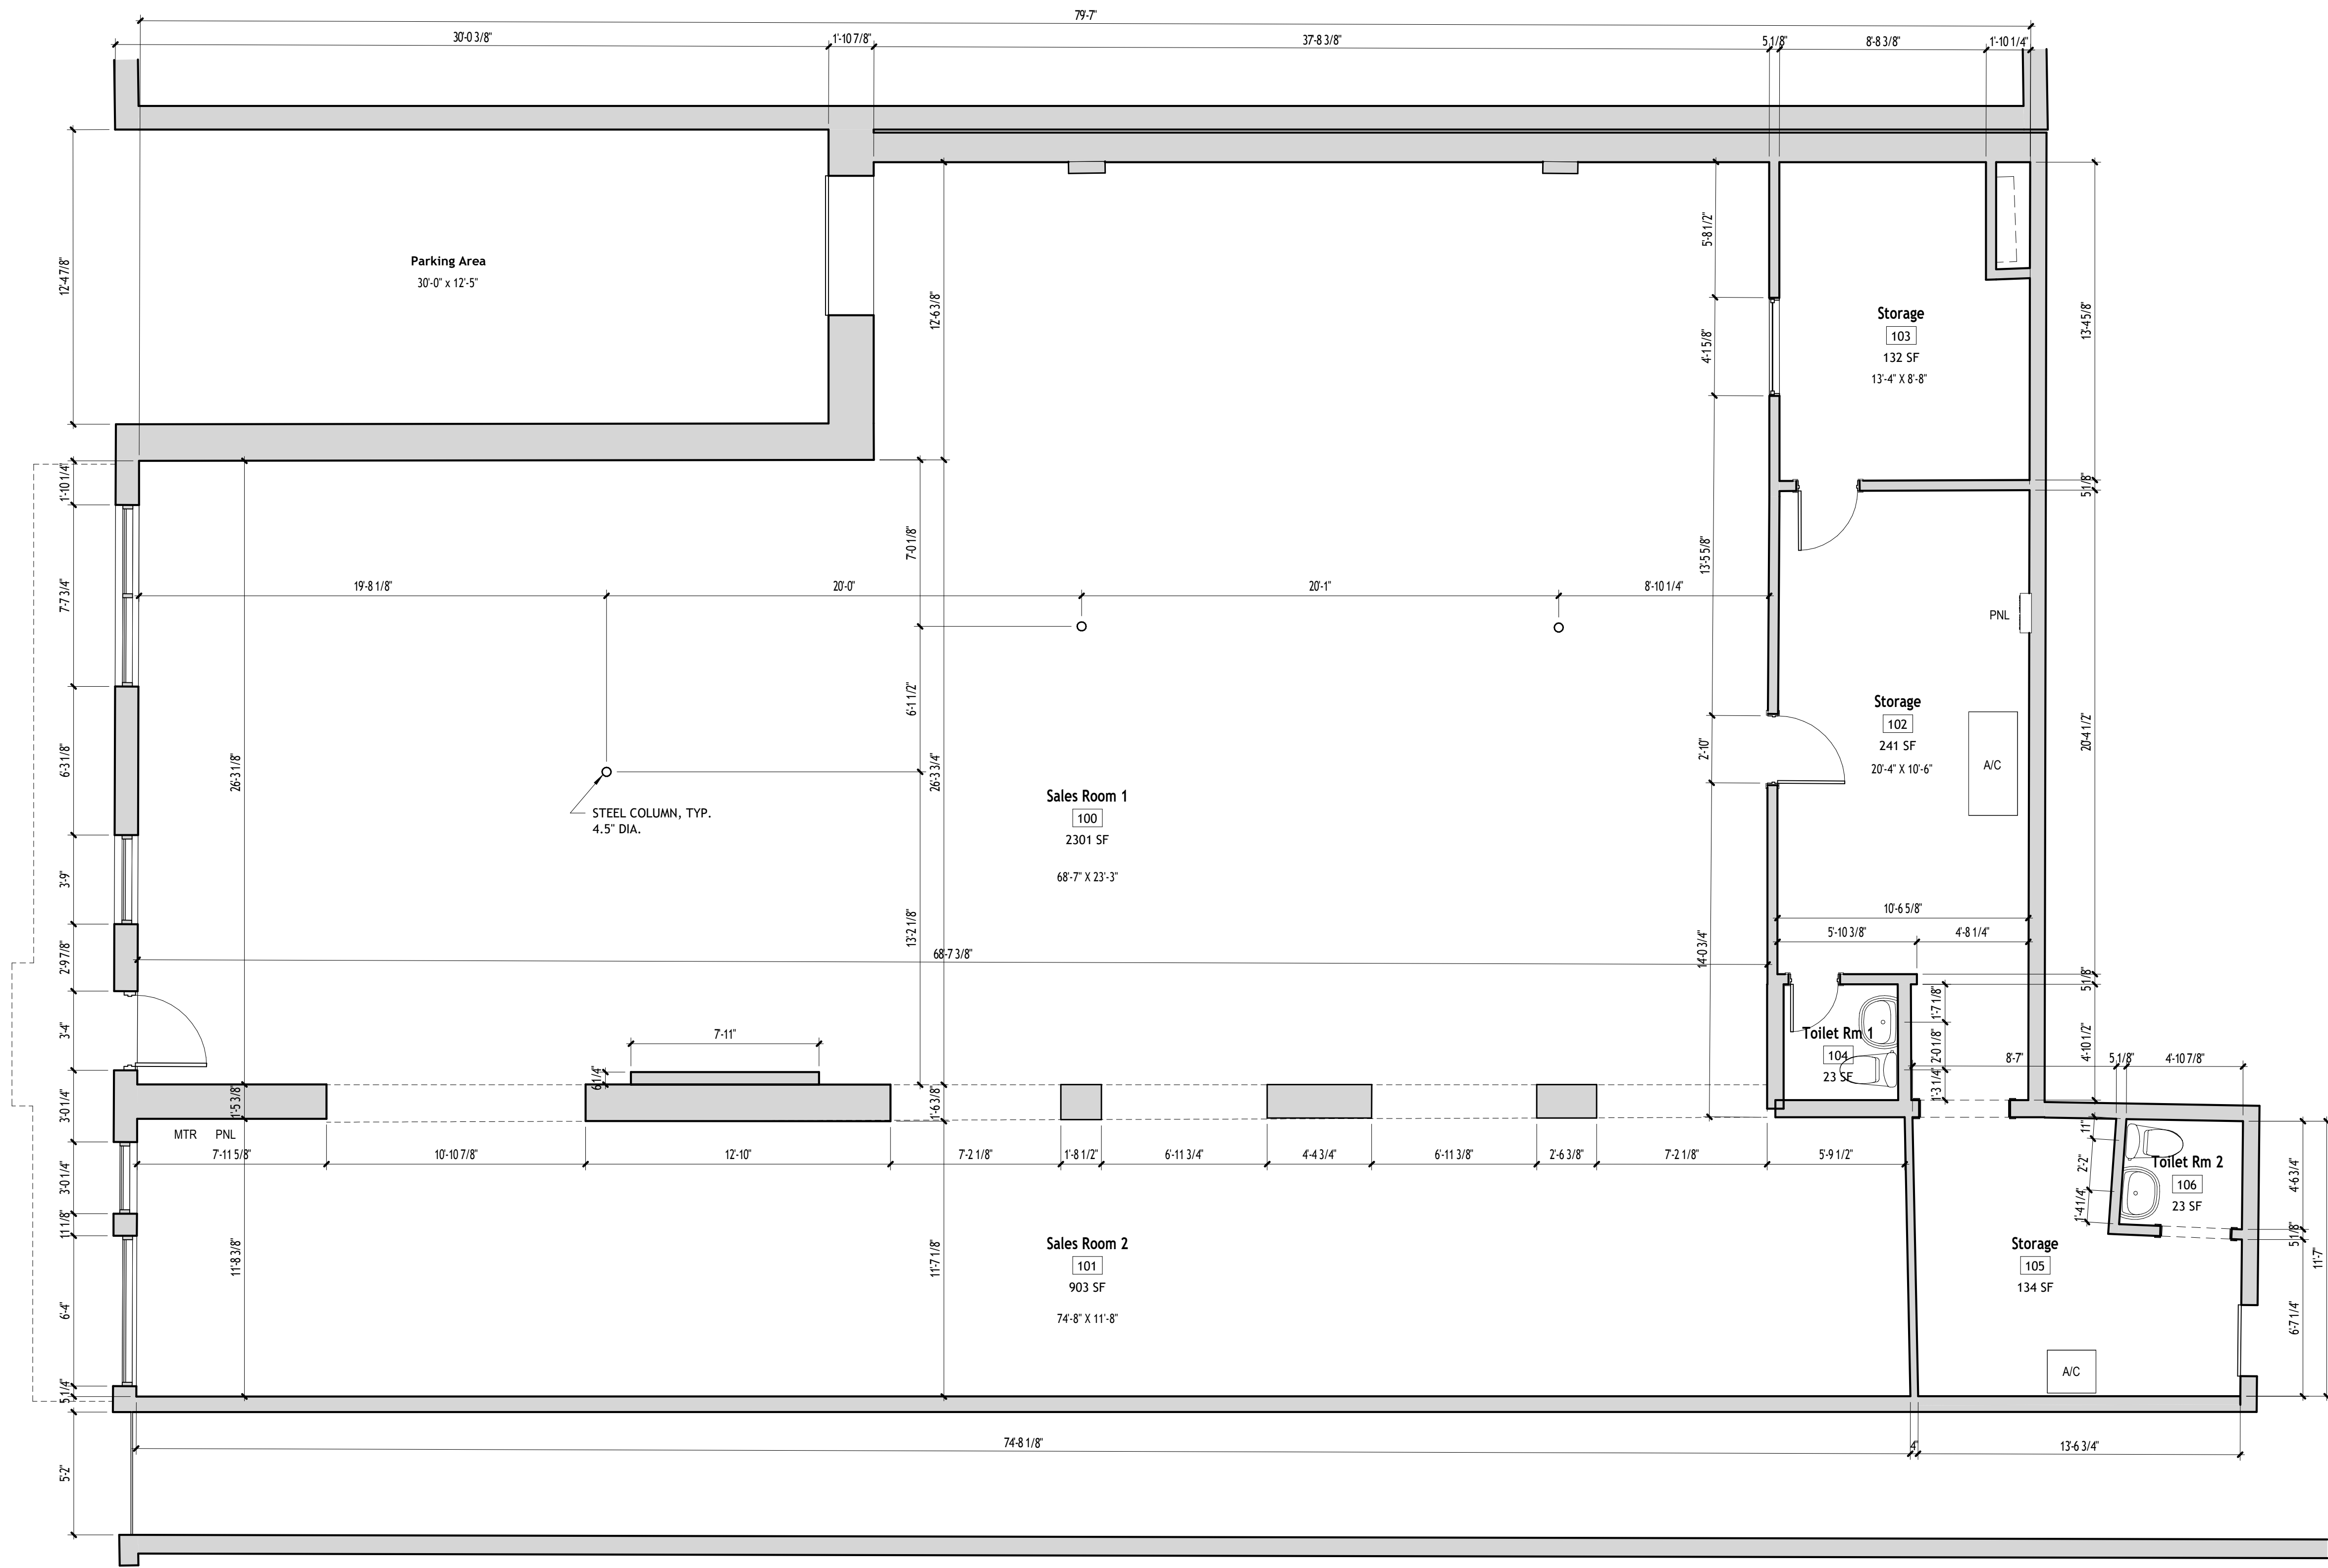

1 First Floor Plan
A101 1/4" = 1'-0"

Room Finish Schedule			
Room Number	Room Name	Area	Comments
100	Sales Room 1	2301 SF	
101	Sales Room 2	903 SF	
102	Storage	241 SF	
103	Storage	132 SF	
104	Toilet Rm 1	23 SF	
105	Storage	134 SF	
106	Toilet Rm 2	23 SF	
Grand total: 7		3758 SF	

NOTES

AS-BUILT ARCHITECTURAL DRAWING SET

NOT FOR CONSTRUCTION.

USE: This document may be used for building appraisal and coordination of engineering, general contractors and building suppliers. This document includes existing conditions limited to the elements identified and does not include any proposed construction.

Where discrepancies occur in architecture drawings and existing conditions, consult architect for clarification. If dimensions can not be obtained based on the drawing information or in field, consult the architect for clarification. Do not scale the drawings.

All drawings, details, renderings, sketches, ideas, business material, specifications and documentation contained in this document are the Intellectual Property of Architecture Experience Inc. Do not use or reproduce any part of this document without architect's consent.

ARCHITECT
Architecture Experience Inc.
Matthew Ostrowski, FL #AR100035
20945 Bay Ct #135, Aventura, FL 33180
miami.archxo.com | info@archxo.com
Tel: (786) 589-0294

PROJECT TITLE
2525 NW 5th Ave As Built

ADDRESS
2525 NW 5th Ave
Miami, FL 33127

CLIENT
Client

PROJECT NO.
260825-4

DATE
9/3/2026

DRAWN BY
MO


CHECKED BY
MO

A101
Dimensioned Floor Plan

SCALE
1/4" = 1'-0"

9/3/2026 7:15:22 PM



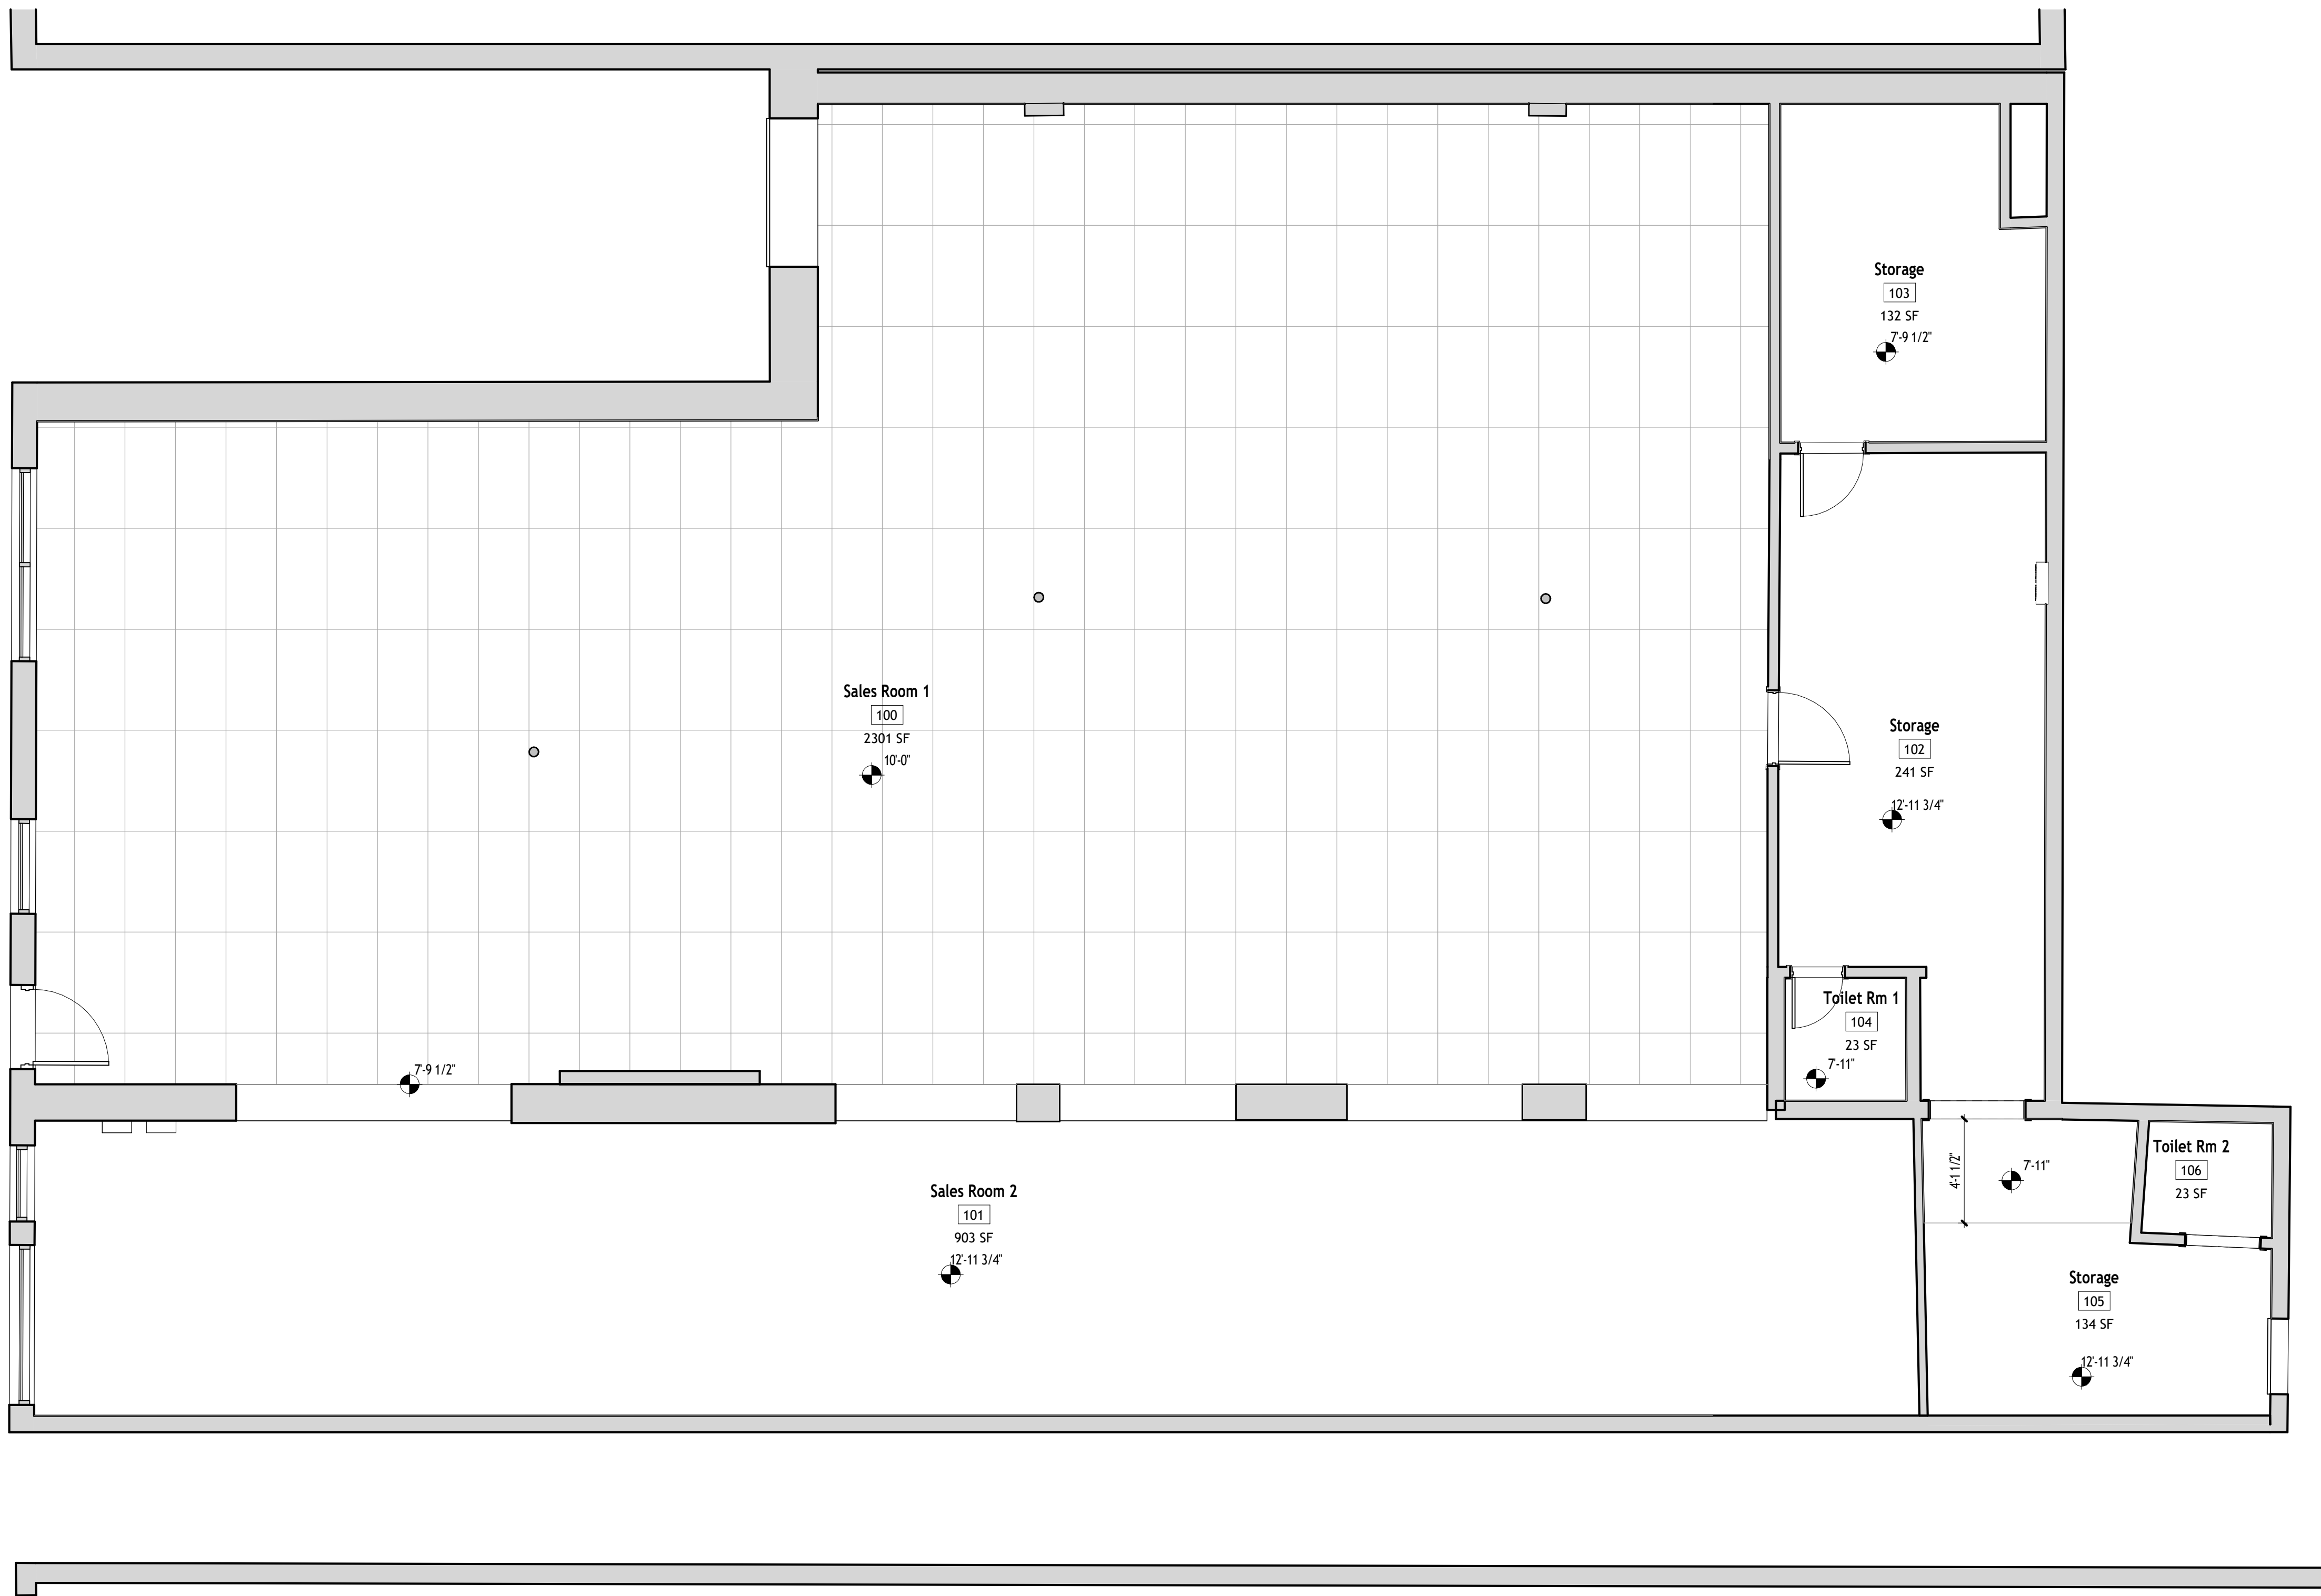

1 First Floor Architectural Ceiling Plan
A102 1/4" = 1'-0"

NOTES

AS-BUILT ARCHITECTURAL DRAWING SET

NOT FOR CONSTRUCTION.

USE: This document may be used for building appraisal and coordination of engineering, general contractors and building suppliers. This document includes existing conditions limited to the elements identified and does not include any proposed construction.

Where discrepancies occur in architecture drawings and existing conditions, consult architect for clarification. If dimensions can not be obtained based on the drawing information or in field, consult the architect for clarification. Do not scale the drawings.

All drawings, details, renderings, sketches, ideas, business material, specifications and documentation contained in this document are the Intellectual Property of Architecture Experience Inc. Do not use or reproduce any part of this document without architect's consent.

Rev #	Date	Description	Issued by	Issued to

ARCHITECT

Architecture Experience Inc.
Matthew Ostrowski, FL #AR100035
20945 Bay Ct #135, Aventura, FL 33180
miami.archxo.com | info@archxo.com
Tel: (786) 589-0294

PROJECT TITLE

2525 NW 5th Ave As Built

ADDRESS

2525 NW 5th Ave
Miami, FL 33127

CLIENT

Client

PROJECT NO.

260825-4

DATE

9/3/2026

DRAWN BY

MO

CHECKED BY


MO

A102

Reflected Ceiling Plan

SCALE

1/4" = 1'-0"

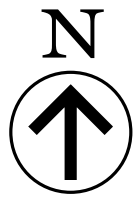

9/3/2026 7:15:23 PM