


Property Key

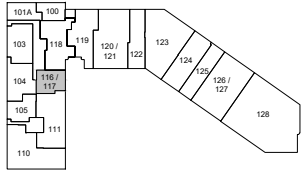

Cross Bayou As Built Marketing Package

11701 Belcher Road, Largo, FL 33773

Building: 11701
Suites: 116-117
Sheet: A-8


Scale: Not to Scale
Sheet Size: 8.5" x 11"
Not For Construction



Total Area - 1,603 SF

Building Information

DECK HEIGHT:	N/A
CEILING HEIGHT:	8'-11"
CLEAR HEIGHT:	8'-11"
SPRINKLERED:	Yes

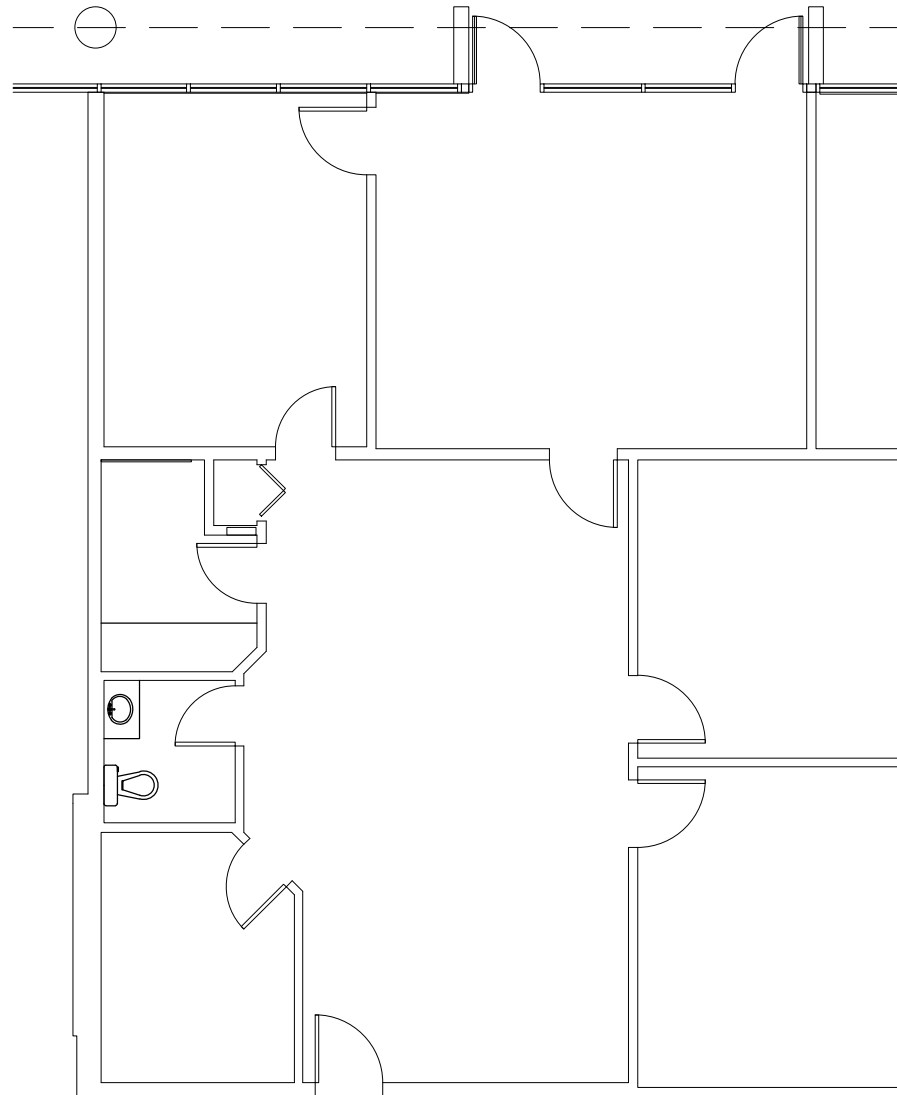

HALLWAY

As Built Floor Plan for Marketing

