
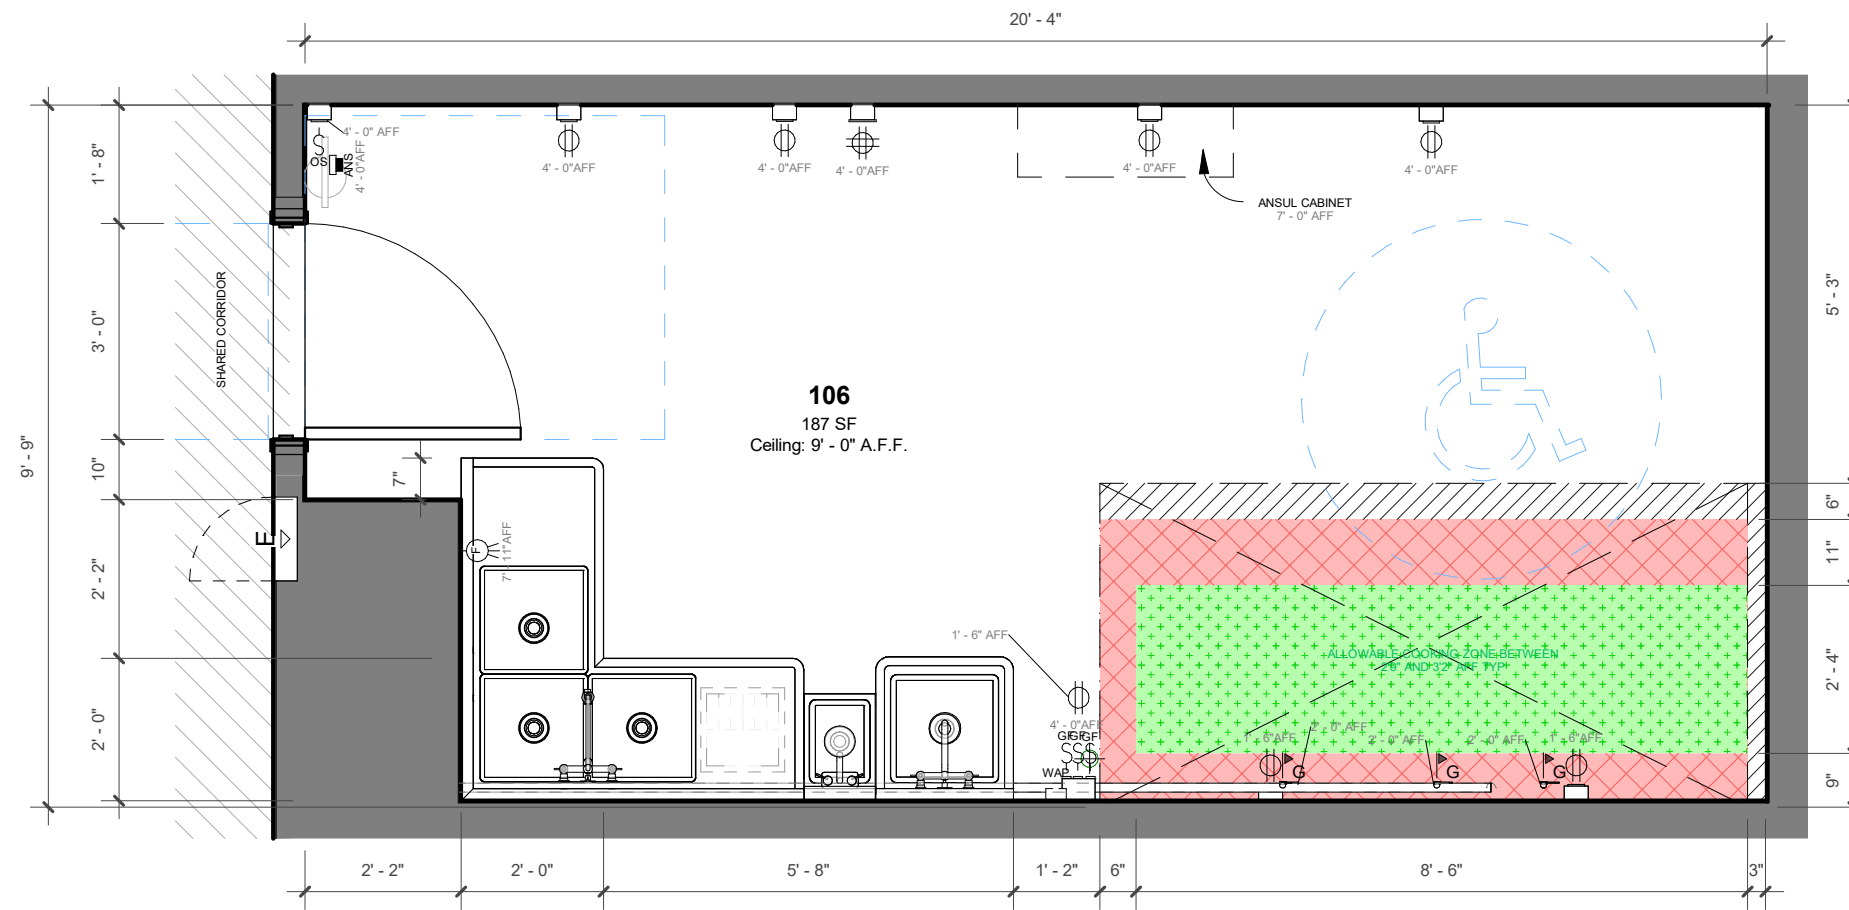


KITCHEN OUTLINE DRAWING

KEY PLAN:

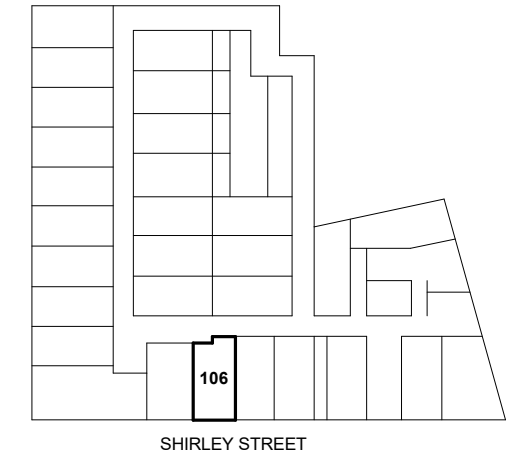

	Coverage Zone		ADA Door Clearance
	Modification Review Req'd		Unverified in Field
	No Coverage Zone		Electrical Panel
	Duplex Outlet		Ansul Pull
	Quad Outlet		Fire Alarm Pull
	High-Voltage Outlet		Fire Strobe
	Junction Box (Blank Plate)		Fire Extinguisher
	Duplex Outlet (Ceiling)		BMS Sensor
	Light Switch		Data Port
	GFCI Power Switch		Wireless Access Point with Data Port
	Floor Sink		Floor Drain
	Gas Connection		Gas Connection w Tee
	Water Line - Domestic		Water Line - Hot Water
	Ceiling Mounted Camera		Wall Mounted Camera
	AFF = Above Finish Floor		RR = Runner Rack

REVISION HISTORY:

NO.	DESCRIPTION	DATE
2	PRE-CON PLAN	08/03/2021
3	UPDATE TO V4 GRAPHICS	02/17/2022
4	AS-BUILT r0	8/26/2022
5	AS-BUILT r1	1/24/2024

1 106-KITCHEN 3/8" = 1'-0"

GENERAL NOTES:

- MINOR VARIATIONS MAY EXIST IN FINAL BUILT CONDITION.
- DEVICES, AND CONNECTIONS ARE SHOWN IN APPROXIMATE LOCATIONS.
- ANSUL SYSTEM AND MECHANICAL HOOD IS EXISTING TO REMAIN PER ORIGINAL FACILITY PERMIT DRAWINGS.
- ALL UTILITIES ARE EXISTING UNLESS OTHERWISE NOTED.
- EXISTING PLUMBING AND SINKS ARE TO REMAIN PER ORIGINAL FACILITY PERMIT DRAWINGS UNLESS OTHERWISE NOTED.
- ALL EQUIPMENT SHALL DRAIN TO EXISTING FLOOR SINKS IN A MANNER THAT IS COMPLIANT WITH LOCAL REGULATIONS AND CODES
- ALL FINISHES ARE EXISTING TO REMAIN.
- SPLASH GUARDS TO BE INSTALLED AS REQUIRED TO BE IN COMPLIANCE WITH ALL LOCAL REGULATIONS AND BUILDING CODES, TYP.

DRAWN BY: JWD CHECKED BY: -

KITCHEN (106)

94 Shirley St, Boston, MA

K-106