


OWNER:
MARINA
SHOPPING LLC
9902-9912 E 21st St,
Tulsa, OK 74129

REV.	
DATE:	12/09/2020
SHEET	
RECORD DRAWINGS	

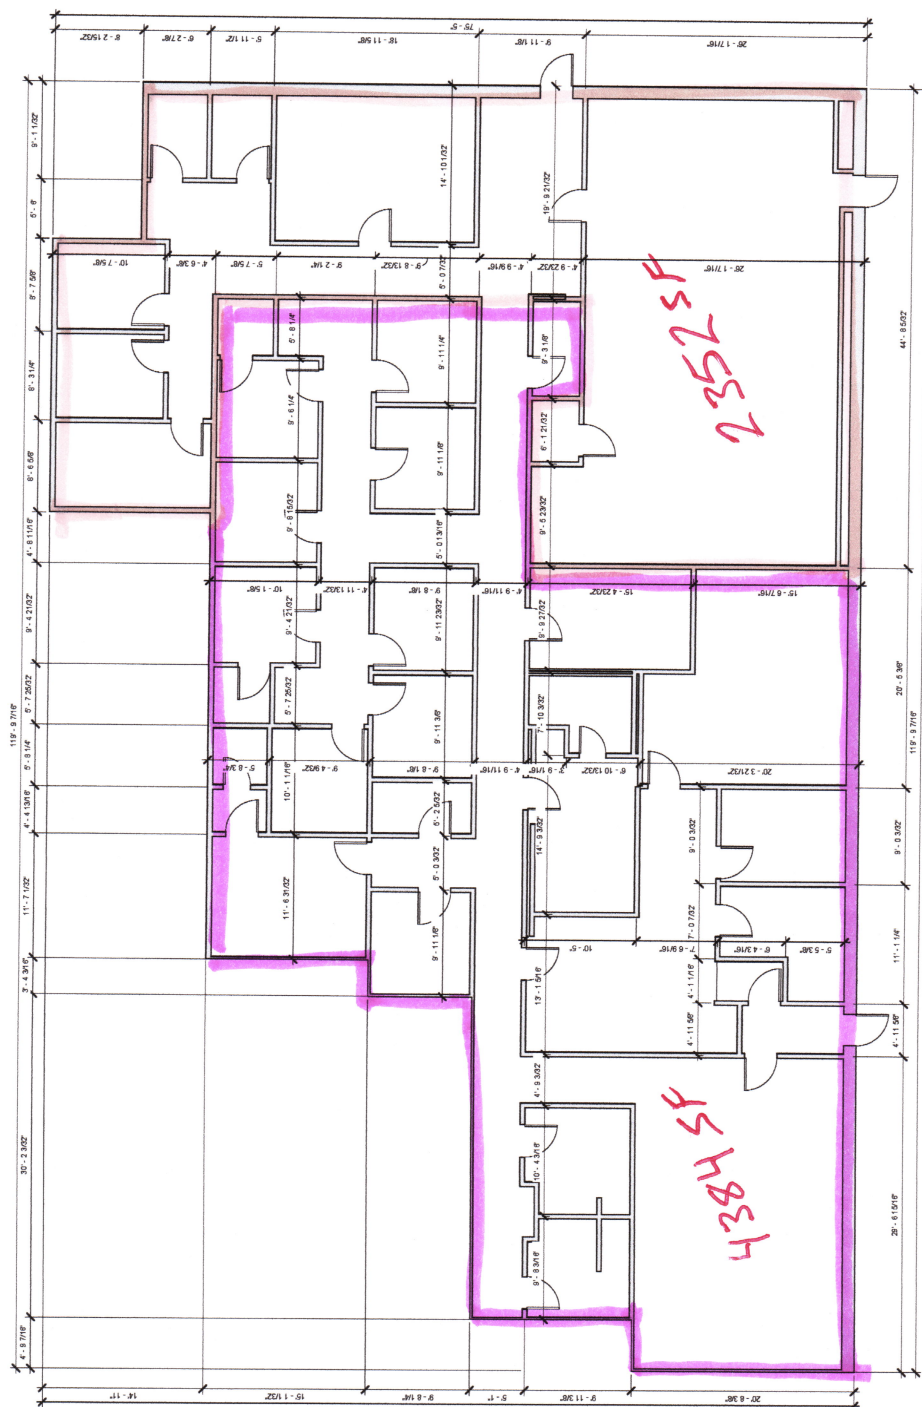

① Level 1 - Tentant Space
3/16" = 1'-0"

GENERAL NOTES
TOTAL SQFT: 6,736

