
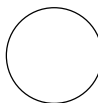


FOR DESIGN INTENT ONLY

FIELD VERIFY ALL  
MEASUREMENTS

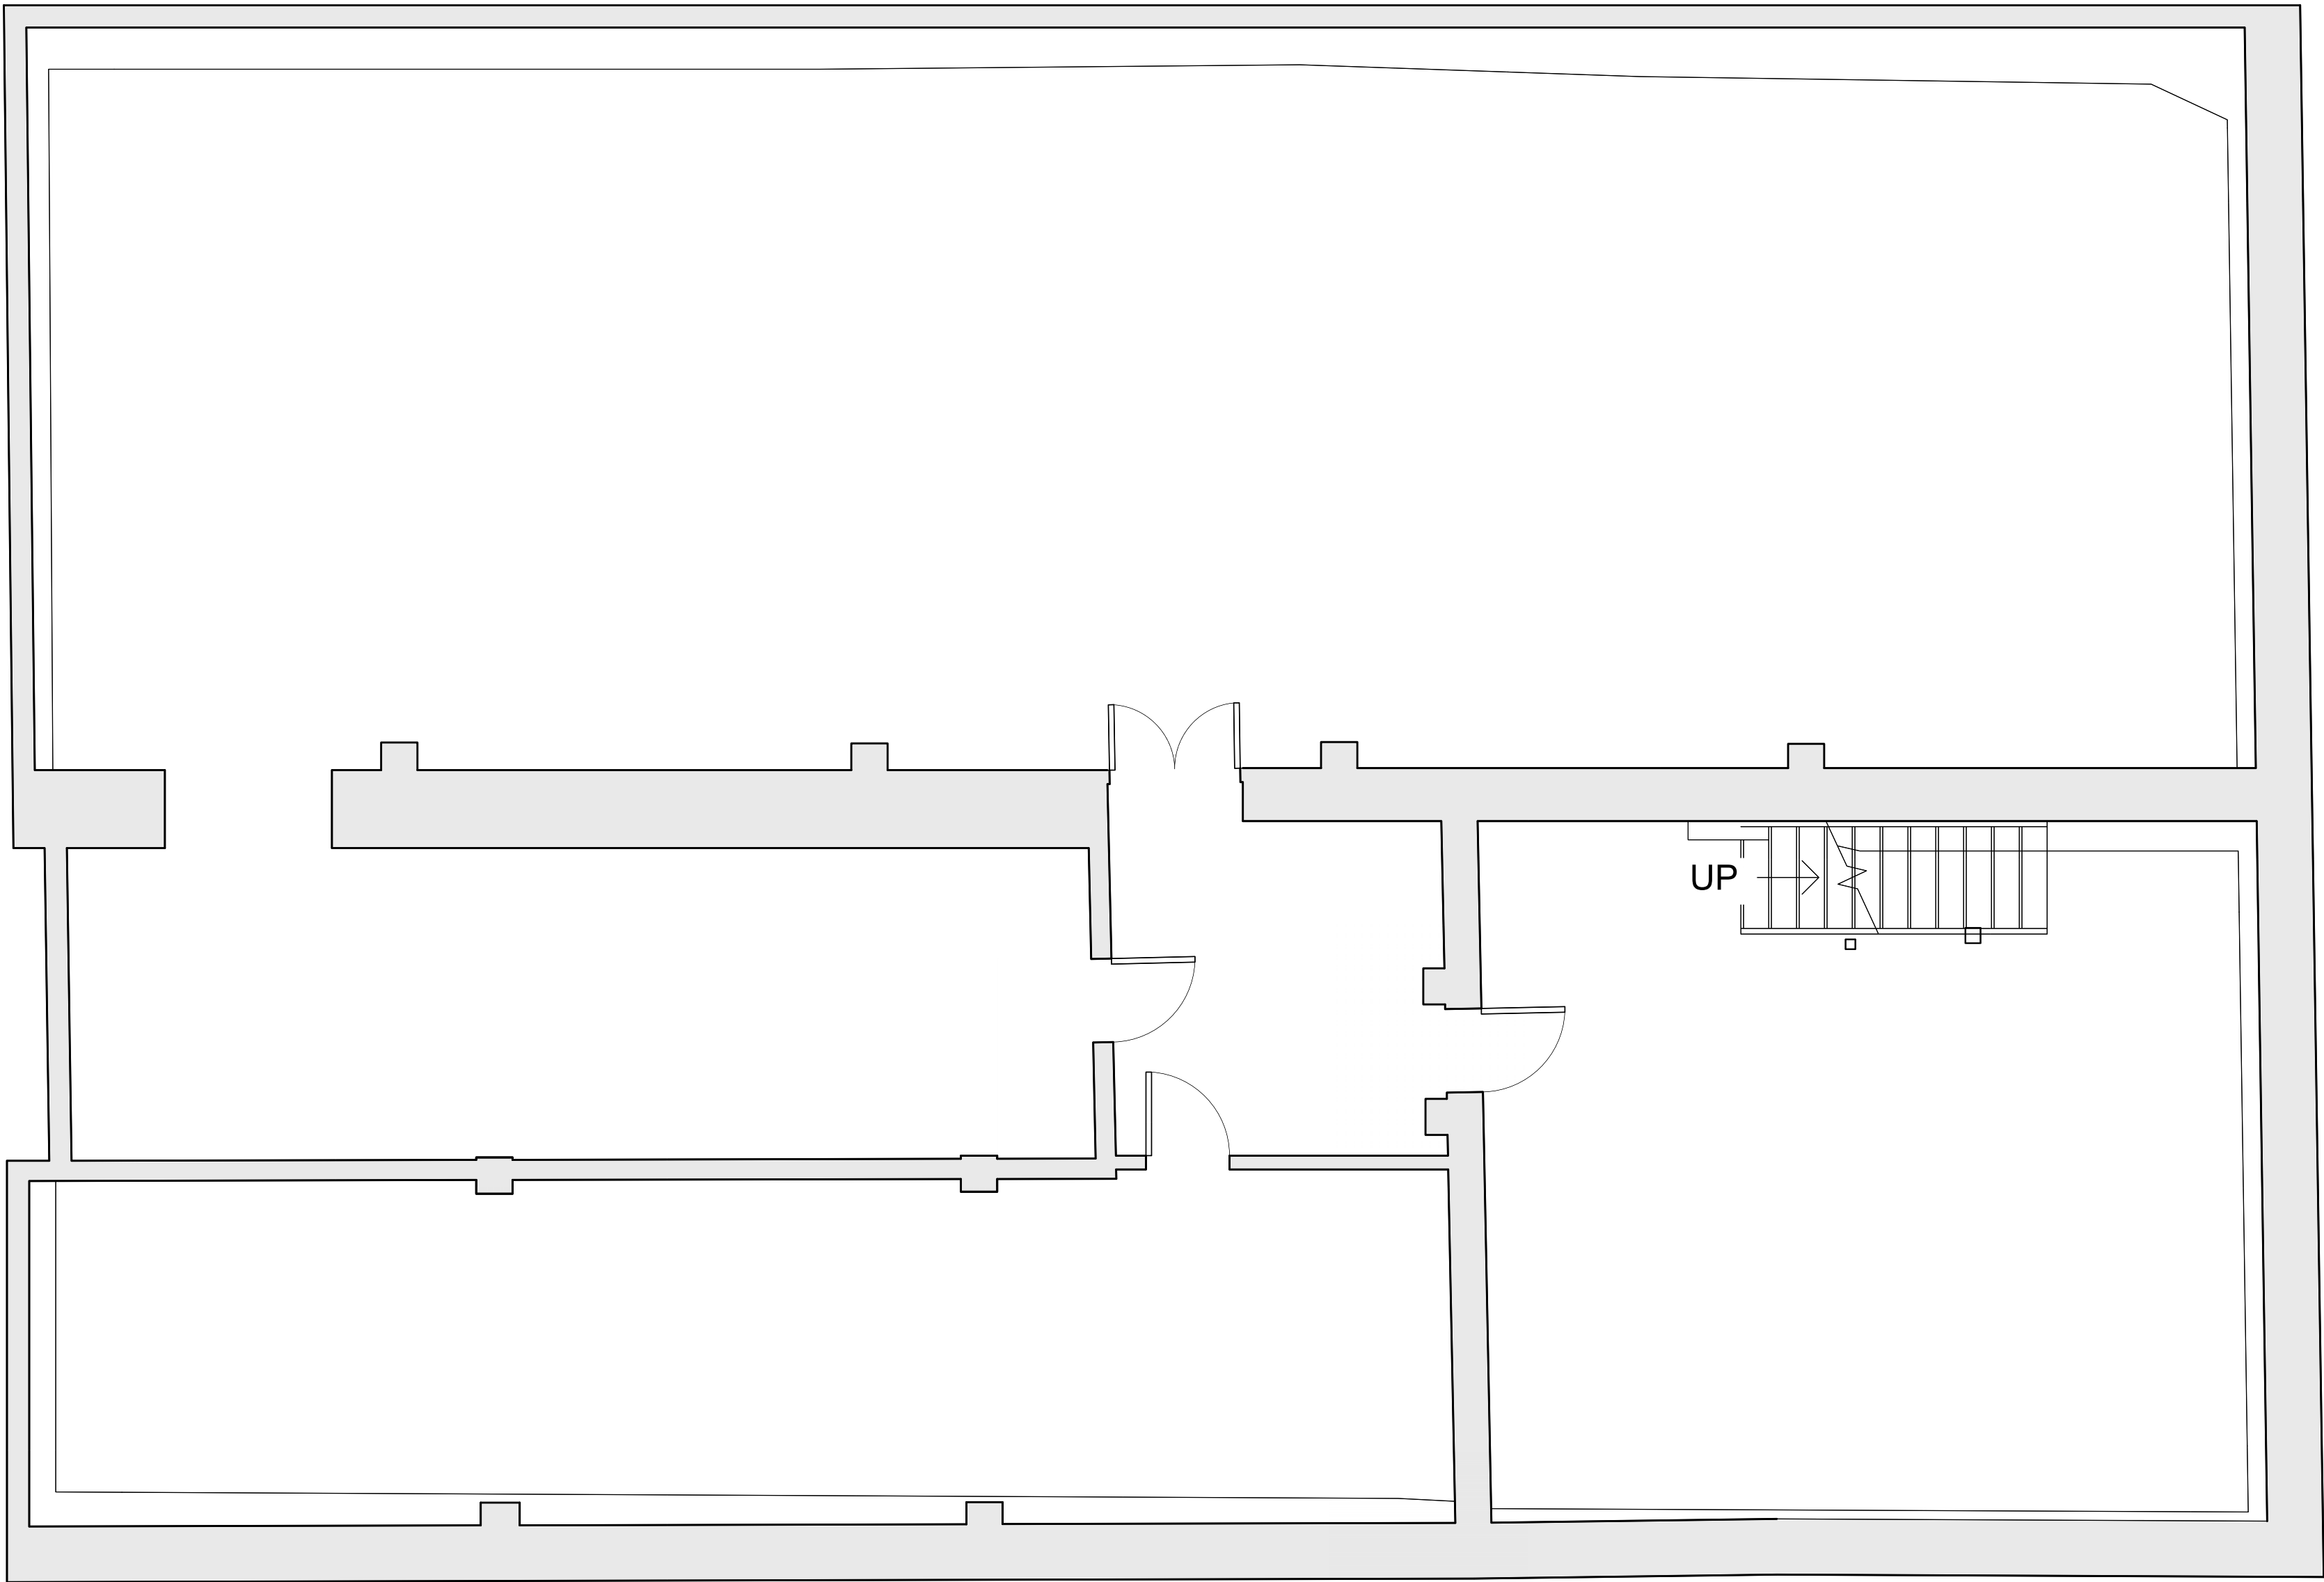

AS-BUILT BASEMENT FLOOR PLAN

SCALE:  $\frac{1}{4}$ " = 1'-0"

OWNER



CHRIS SALLY  
CSALLY@DI-KC.COM  
816-808-9848

ARCHITECT



ROBERT RICCARDI  
ROBERT@DRAWARCH.COM

HAMMER OUT DESIGN

JOHN O'BRIEN  
JOHN@HAMMEROUTDESIGN.COM  
816-914-6234

JUSTIN GAINAN  
J.GAINAN@GMAIL.COM  
361-765-4058

BRENNEN HALL  
BRENNENDAVIDHALL@GMAIL.COM  
314-703-3264

## SEIDENS FUR BUILDING

935 BROADWAY  
KANSAS CITY, MO 64105

DRAWING TITLE:

AS-BUILT BASEMENT FLOOR PLAN

# F1



DRAWN BY  
DATE

BH  
04/24/2025



FOR DESIGN INTENT ONLY

FIELD VERIFY ALL  
MEASUREMENTS

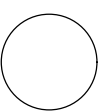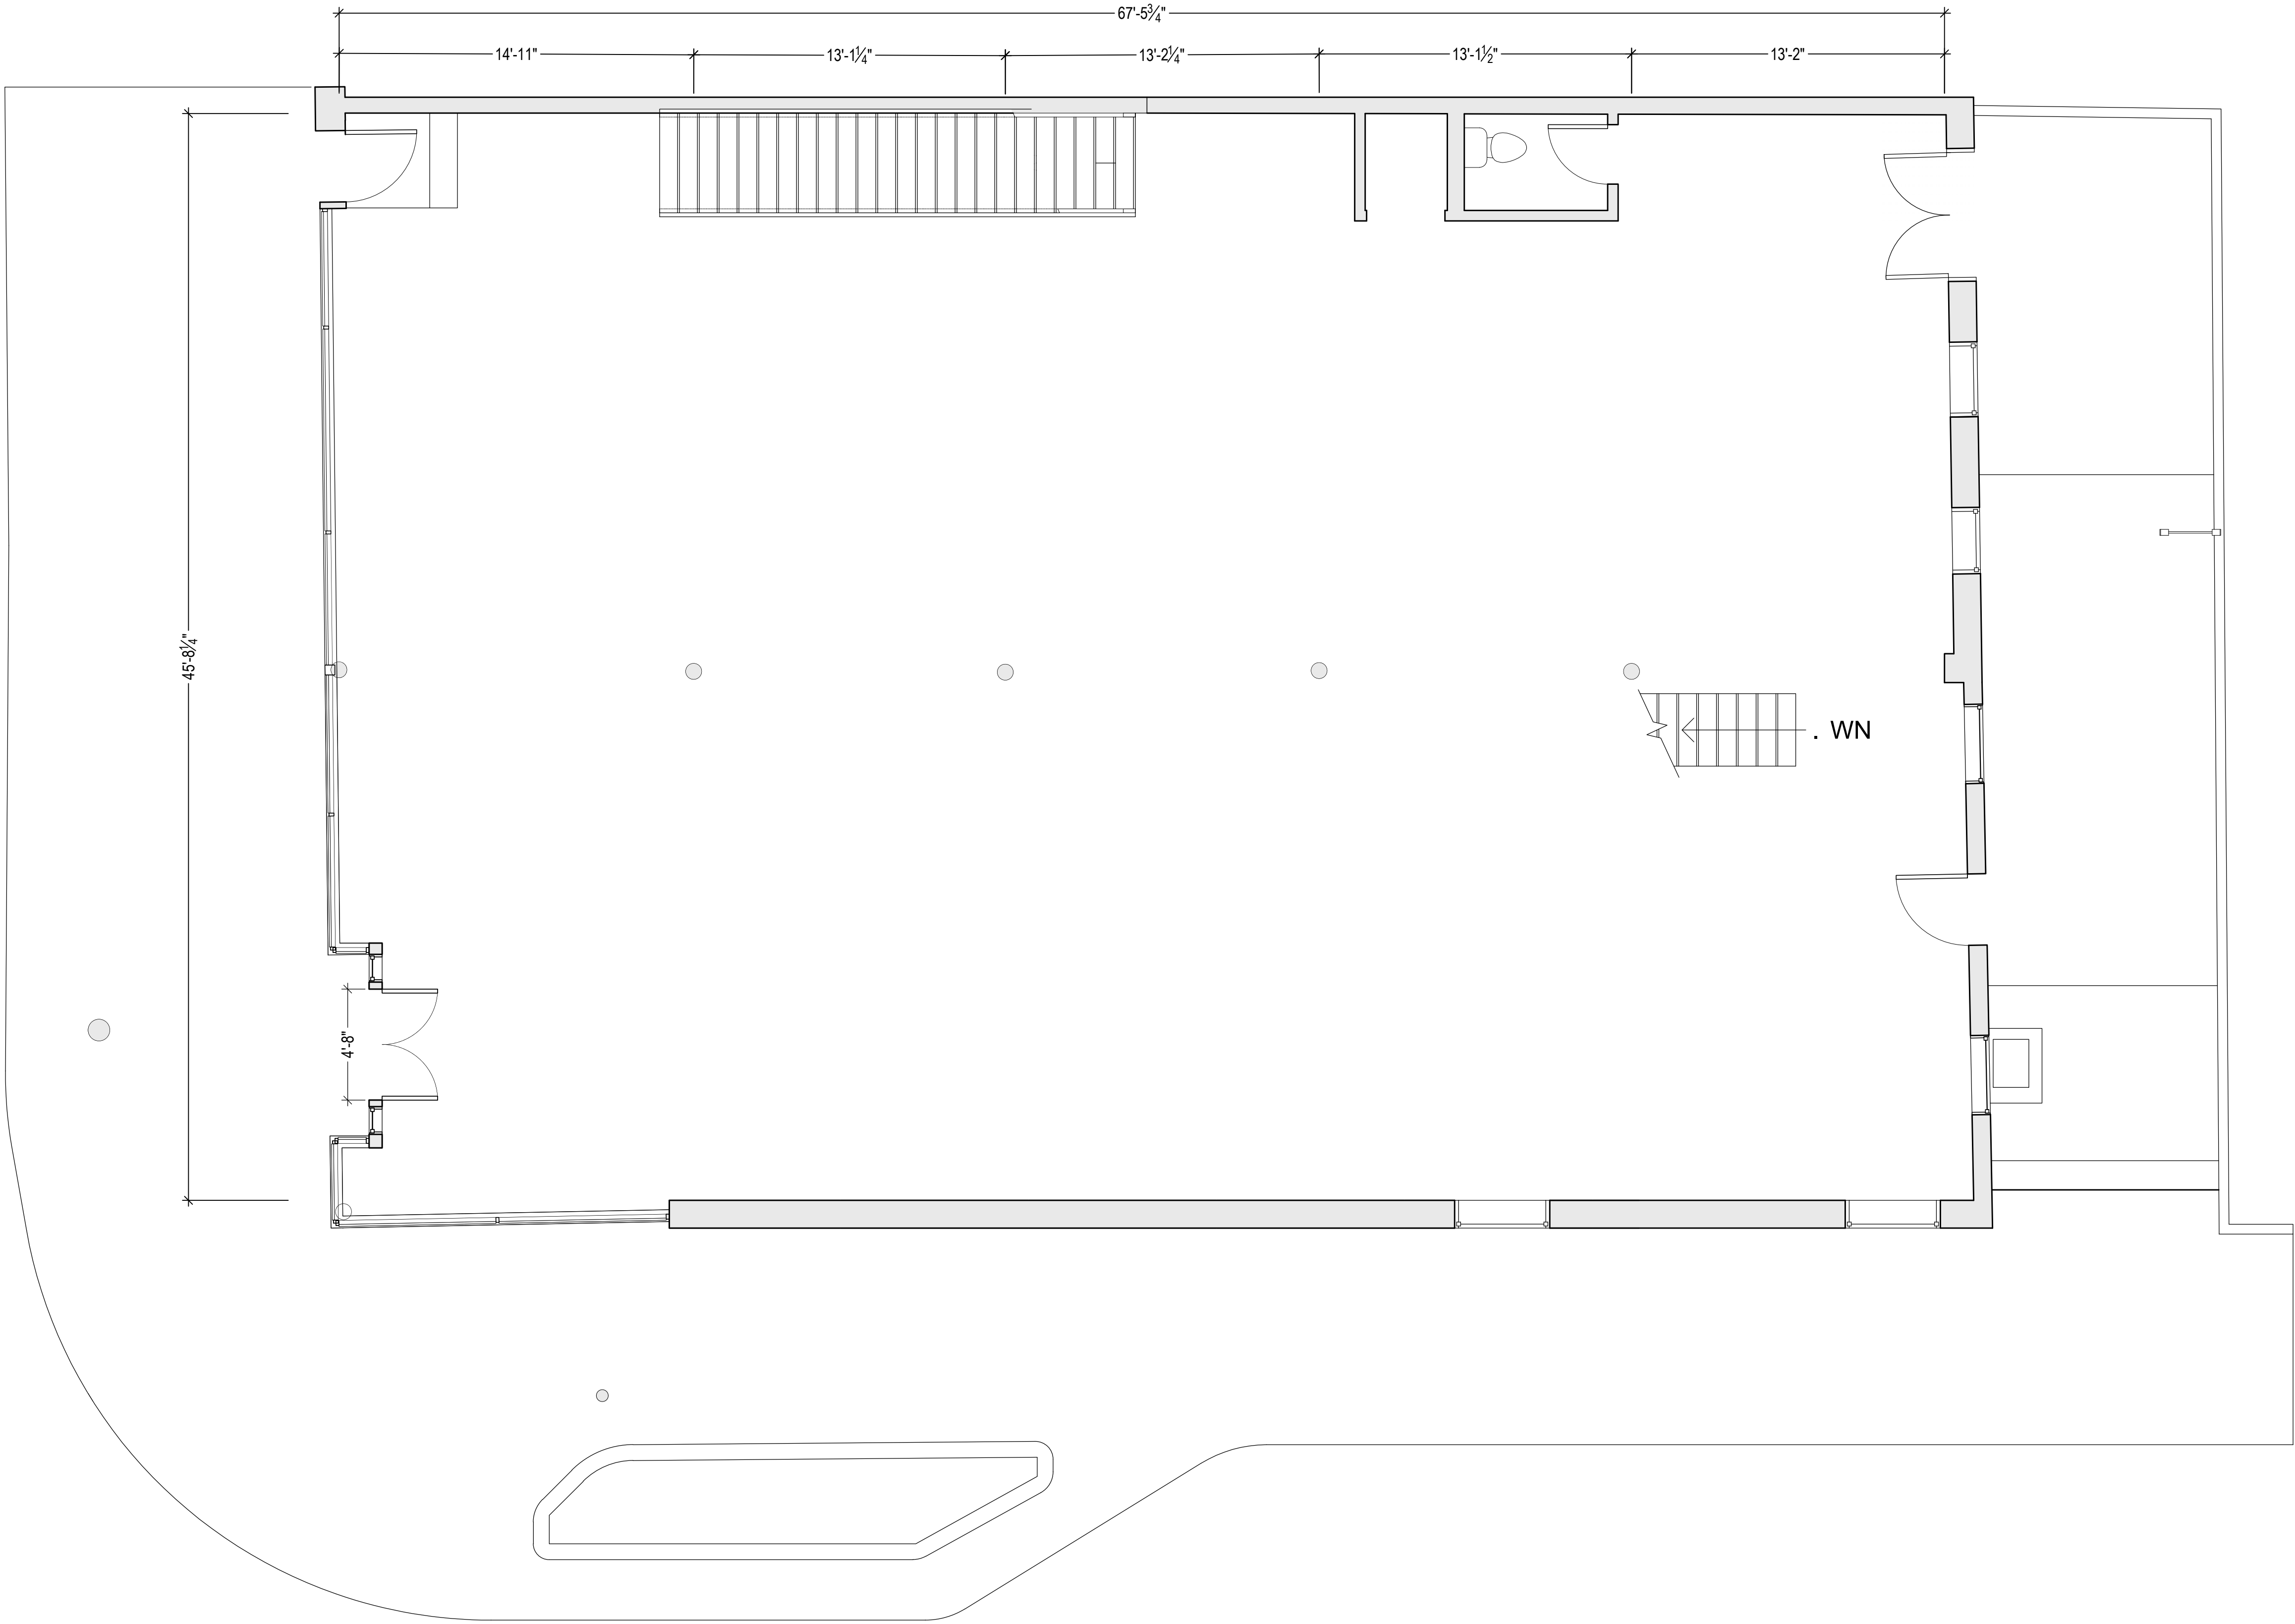

AS-BUILT FIRST FLOOR PLAN

SCALE:  $\frac{1}{4}$ " = 1'-0"

OWNER



CHRIS SALLY  
CSALLY@DI-KC.COM  
816-808-9848

ARCHITECT



ROBERT RICCARDI  
ROBERT@DRAWARCH.COM

HAMMER OUT DESIGN

JOHN O'BRIEN  
JOHN@HAMMEROUTDESIGN.COM  
816-914-6234

JUSTIN GAINAN  
J.GAINAN@GMAIL.COM  
361-765-4058

BRENNEN HALL  
BRENNENDAVIDHALL@GMAIL.COM  
314-703-3264

## SEIDENS FUR BUILDING

935 BROADWAY  
KANSAS CITY, MO 64105

DRAWING TITLE:

AS-BUILT FIRST FLOOR PLAN

# F2


DRAWN BY  
DATE

BH  
04/24/2025



FOR DESIGN INTENT ONLY

FIELD VERIFY ALL  
MEASUREMENTS

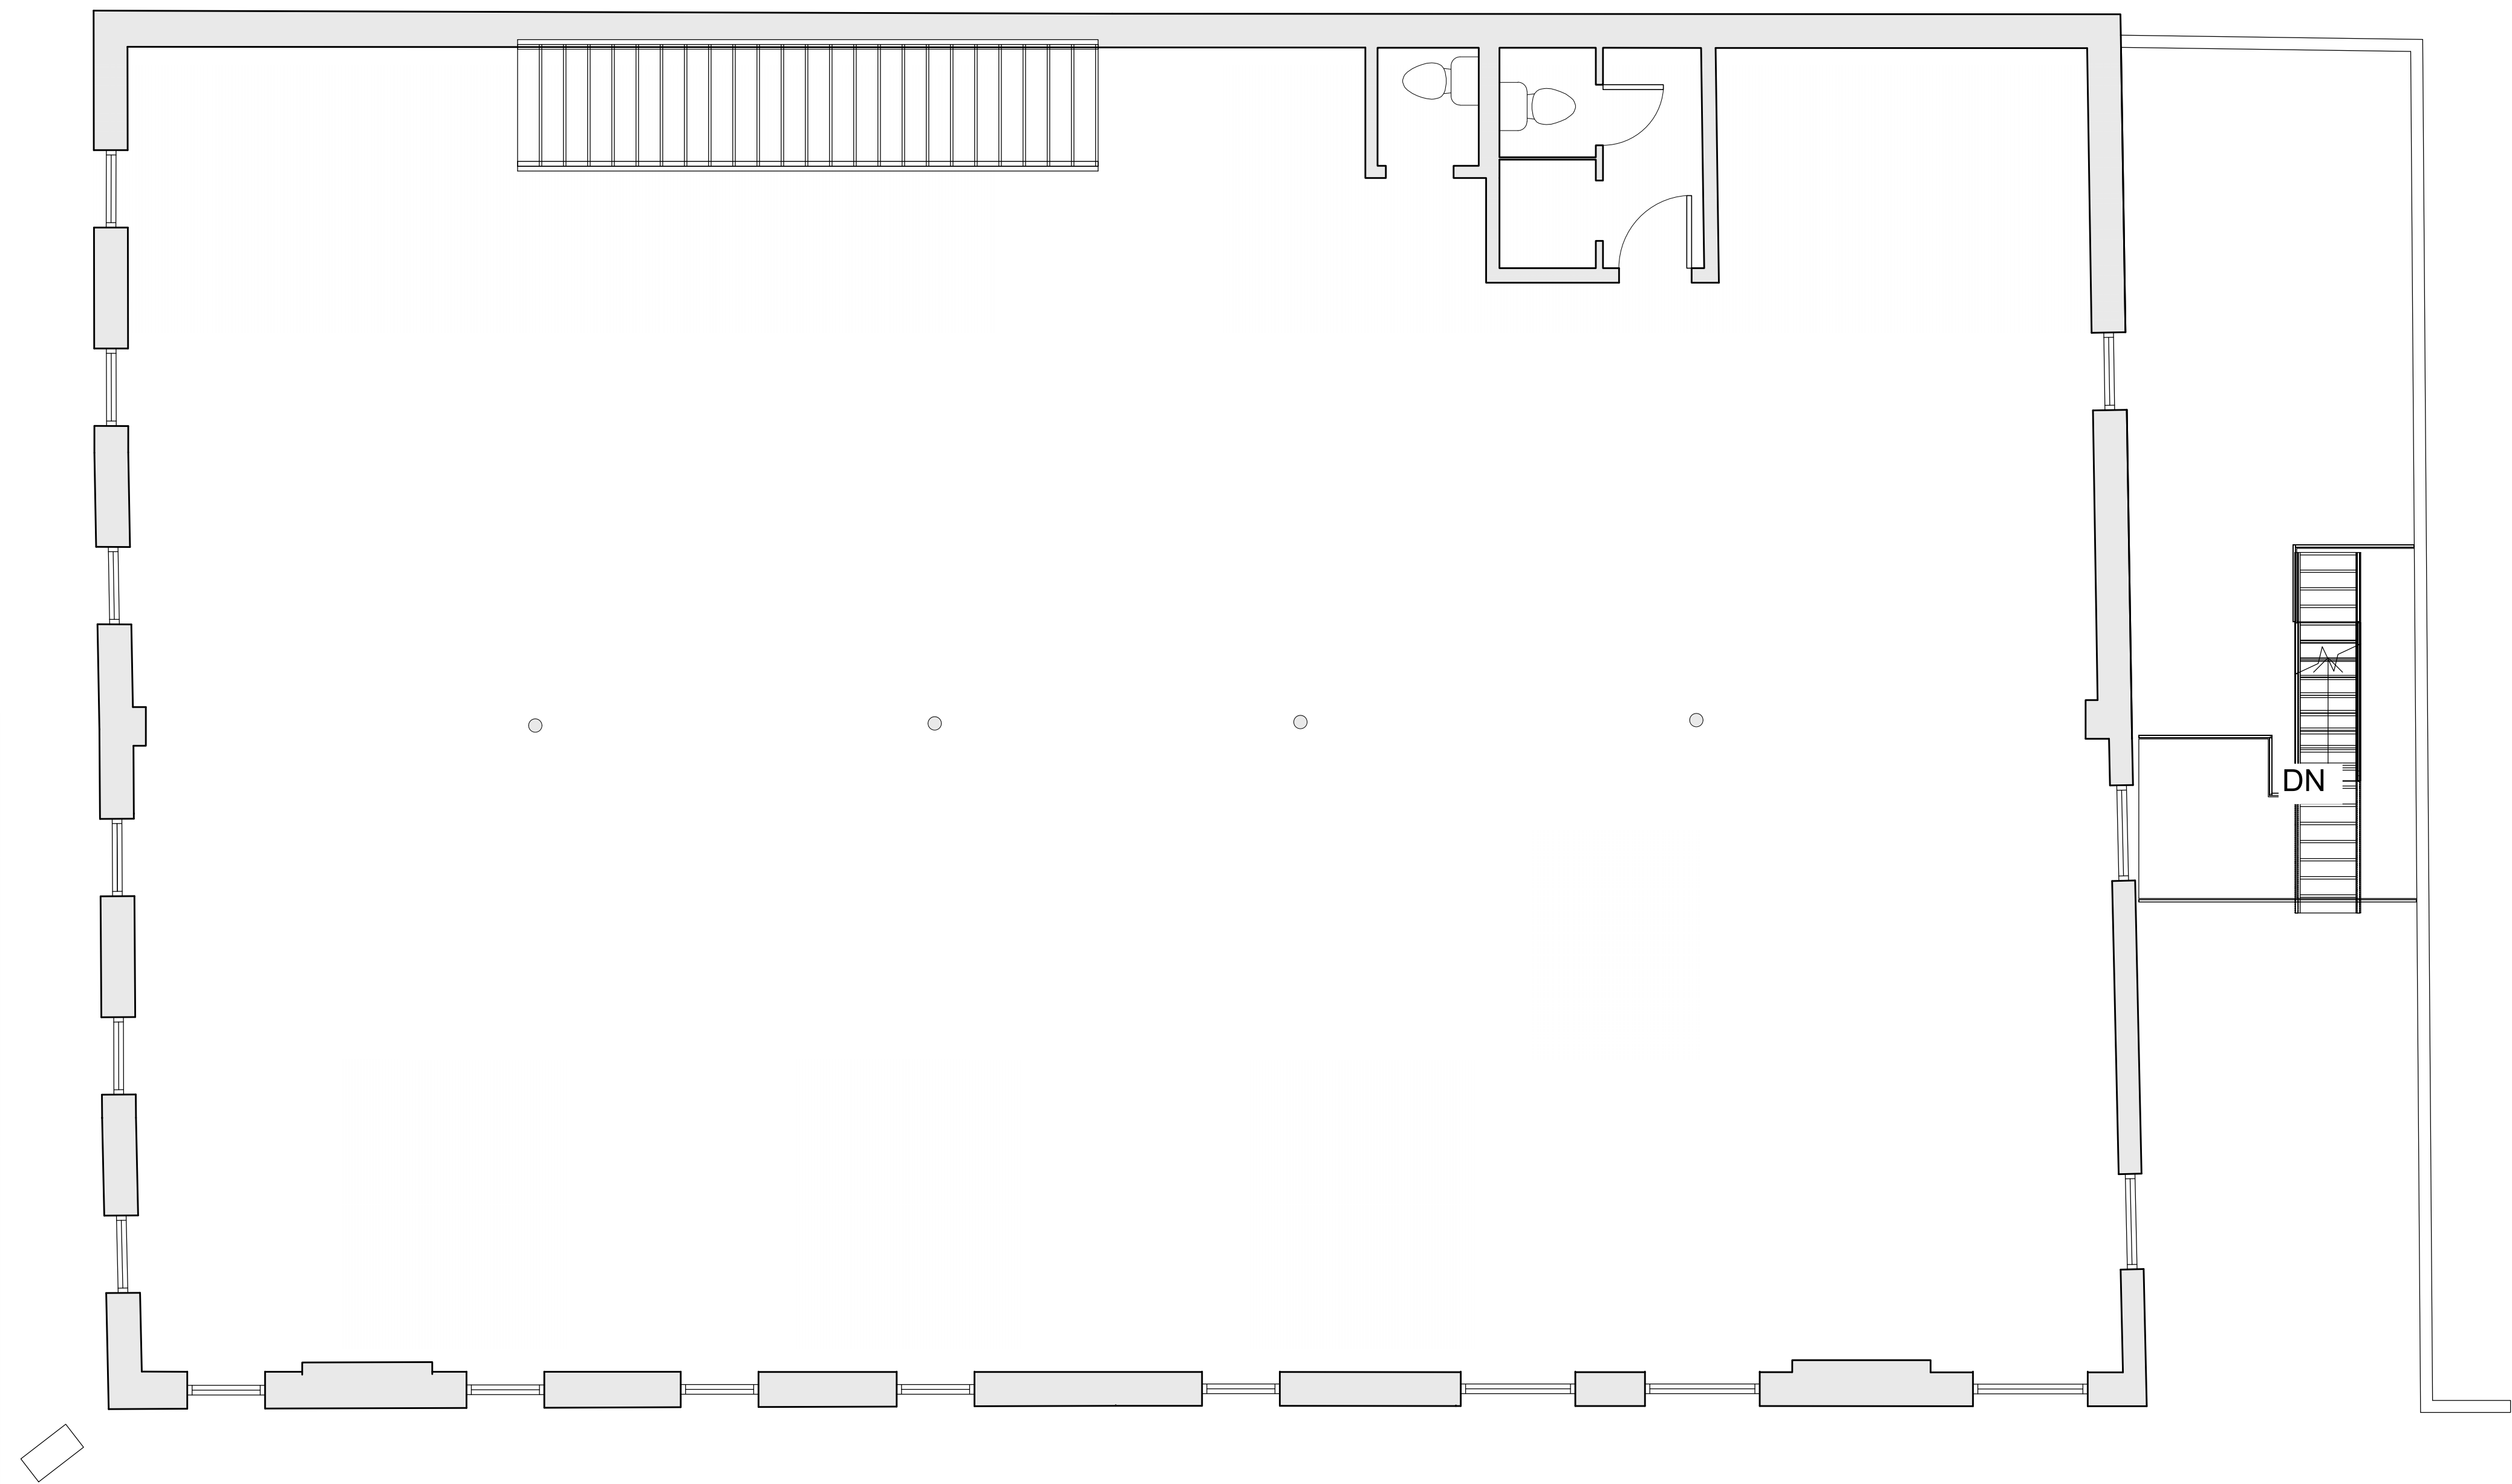

AS-BUILT SECOND FLOOR PLAN

SCALE:  $\frac{1}{4}$ " = 1'-0"

OWNER



CHRIS SALLY  
CSALLY@DI-KC.COM  
816-808-9848

ARCHITECT

**DRAW**  
architecture + urban design

ROBERT RICCARDI  
ROBERT@DRAWARCH.COM

HAMMER OUT DESIGN

JOHN O'BRIEN  
JOHN@HAMMEROUTDESIGN.COM  
816-914-6234

JUSTIN GAINAN  
J.GAINAN@GMAIL.COM  
361-765-4058

BRENNEN HALL  
BRENNENDAVIDHALL@GMAIL.COM  
314-703-3264

## SEIDENS FUR BUILDING

935 BROADWAY  
KANSAS CITY, MO 64105

DRAWING TITLE:


AS-BUILT SECOND FLOOR PLAN

F3

DRAWN BY  
DATE

BH  
04/24/2025



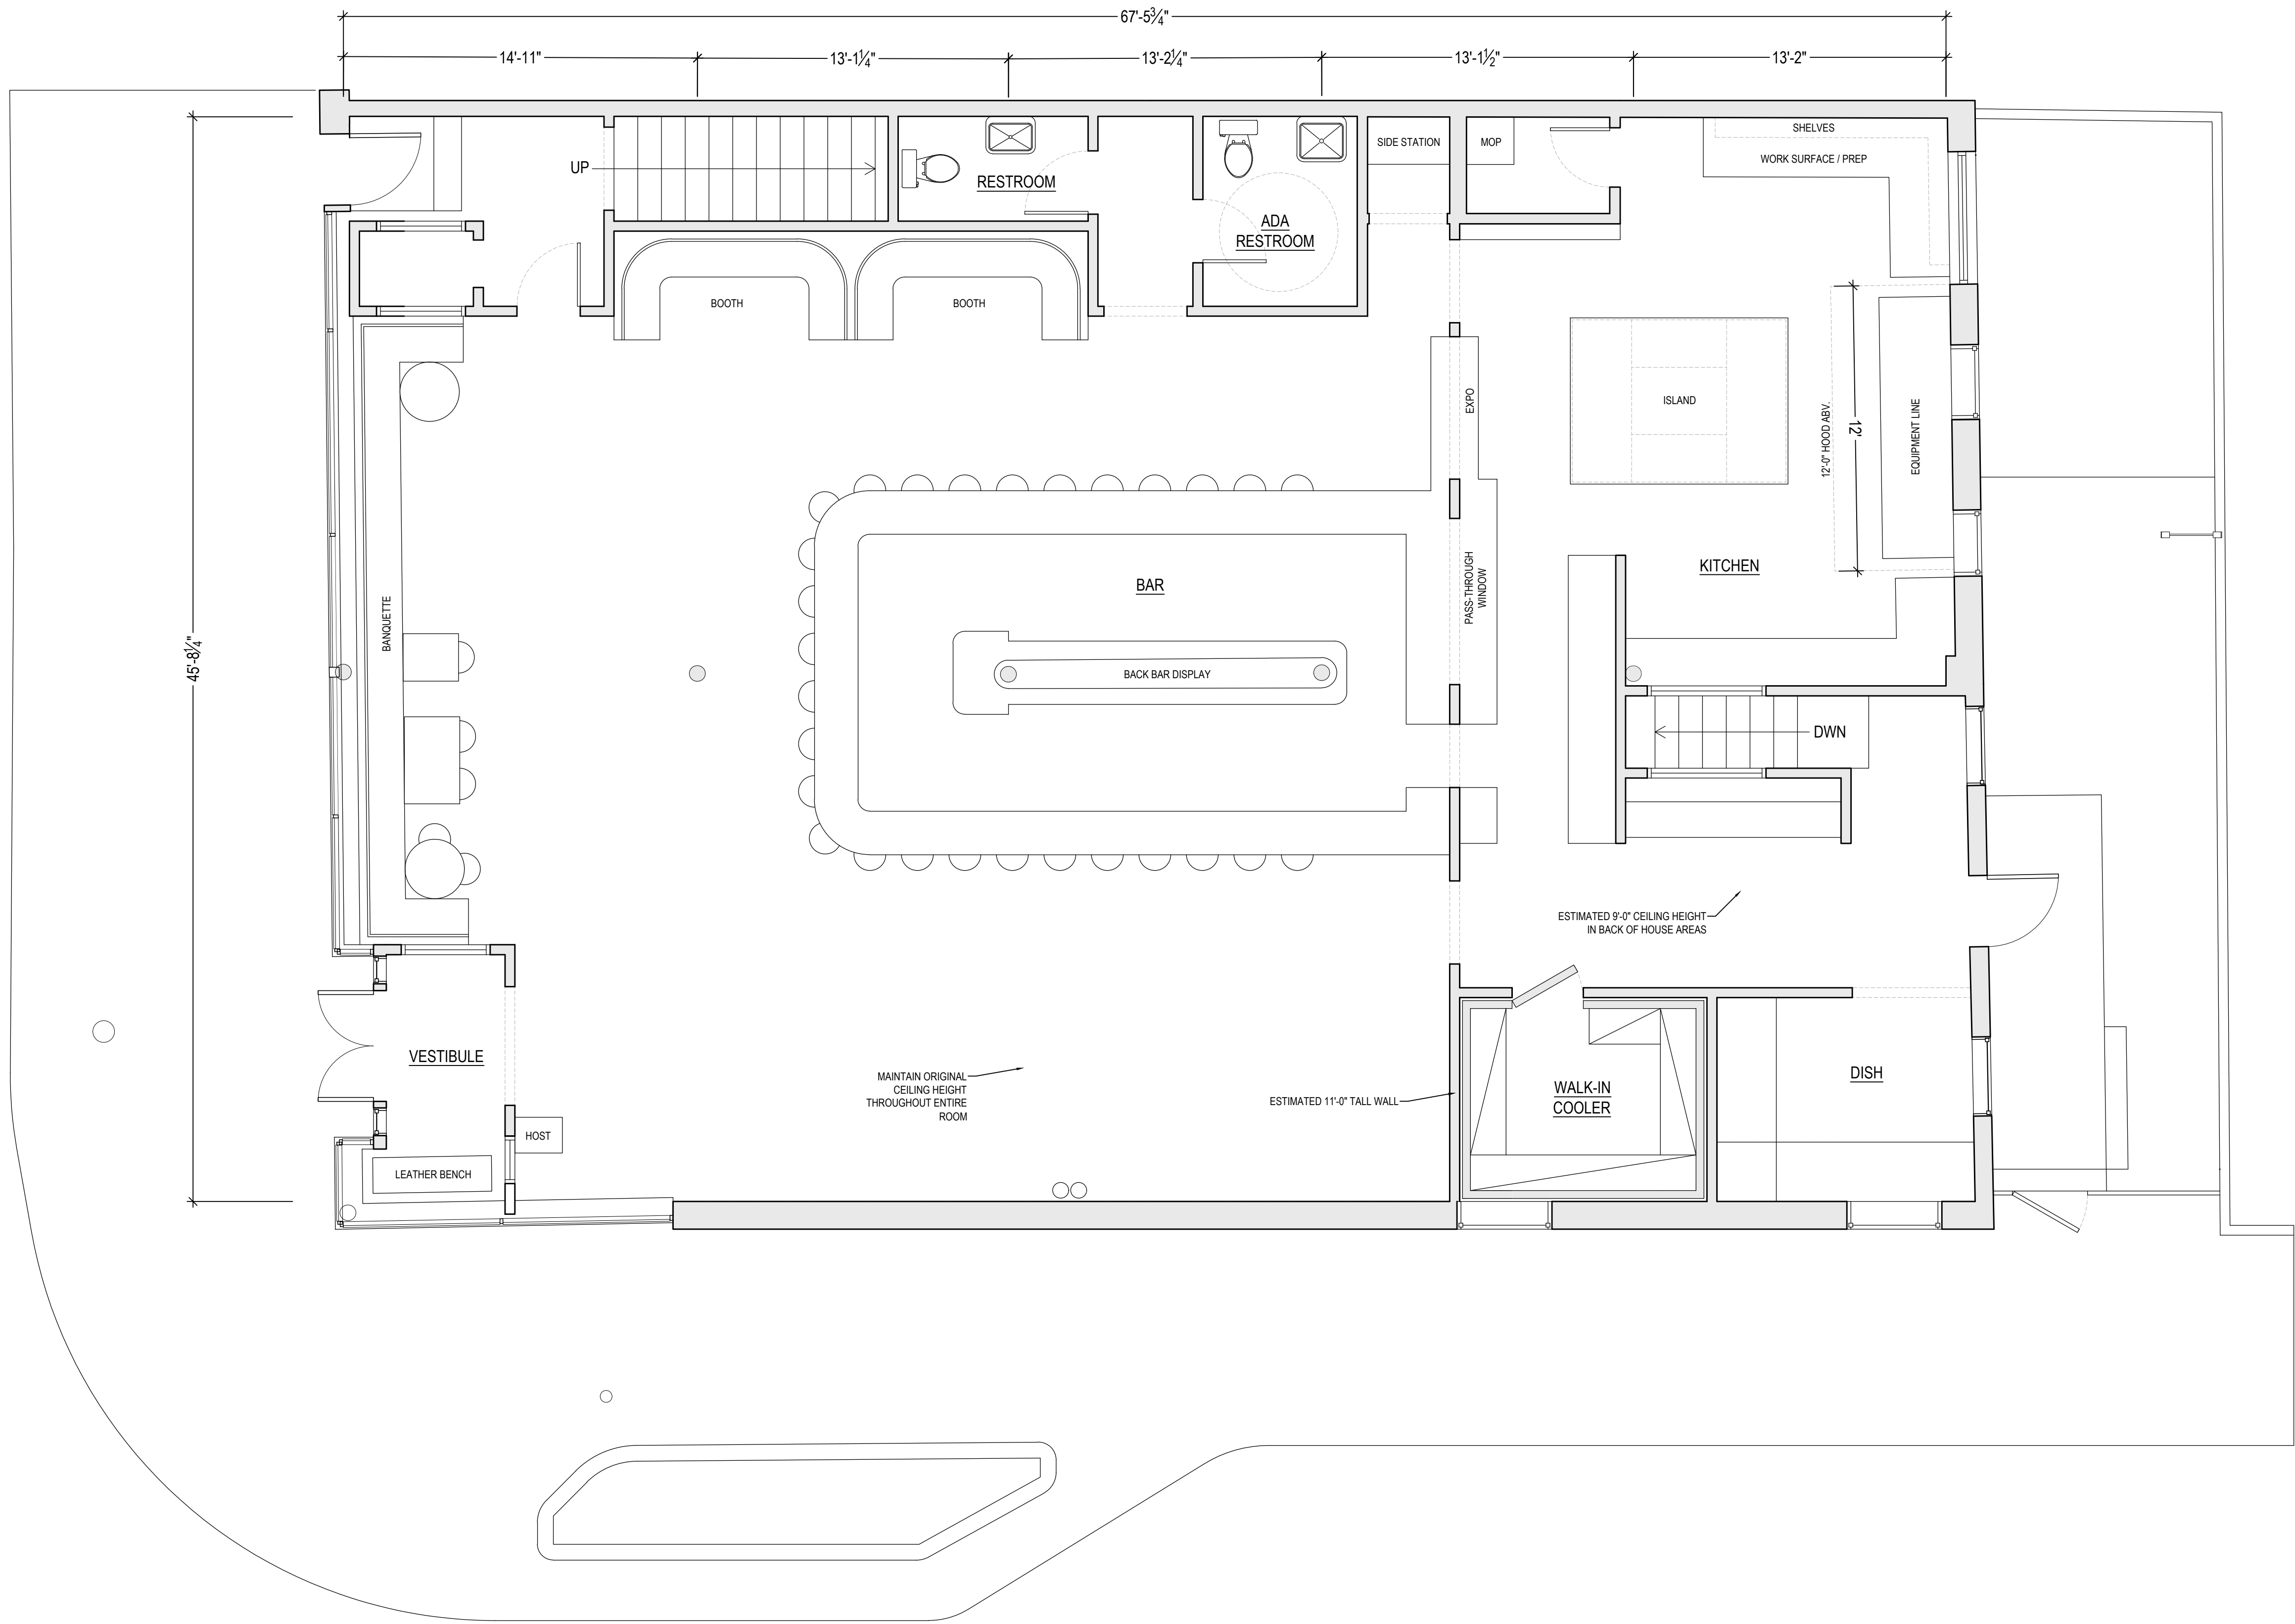

FIRST FLOOR PLAN  
SCALE:  $\frac{1}{4}" = 1'-0"$

OWNER



CHRIS SALLY  
CSALLY@DI-KC.COM  
816-808-9848

ARCHITECT



ROBERT RICCARDI  
ROBERT@DRAWARCH.COM

HAMMER OUT DESIGN

JOHN O'BRIEN  
JOHN@HAMMEROUTDESIGN.COM  
816-914-6234

JUSTIN GAINAN  
J.GAINAN@GMAIL.COM  
361-765-4058

BRENNEN HALL  
BRENNENDAVIDHALL@GMAIL.COM  
314-703-3264

## SEIDENS FUR BUILDING

935 BROADWAY  
KANSAS CITY, MO 64105

DRAWING TITLE:

FIRST FLOOR PLAN

# F4

DRAWN BY  
DATE

BH  
04/24/2025