


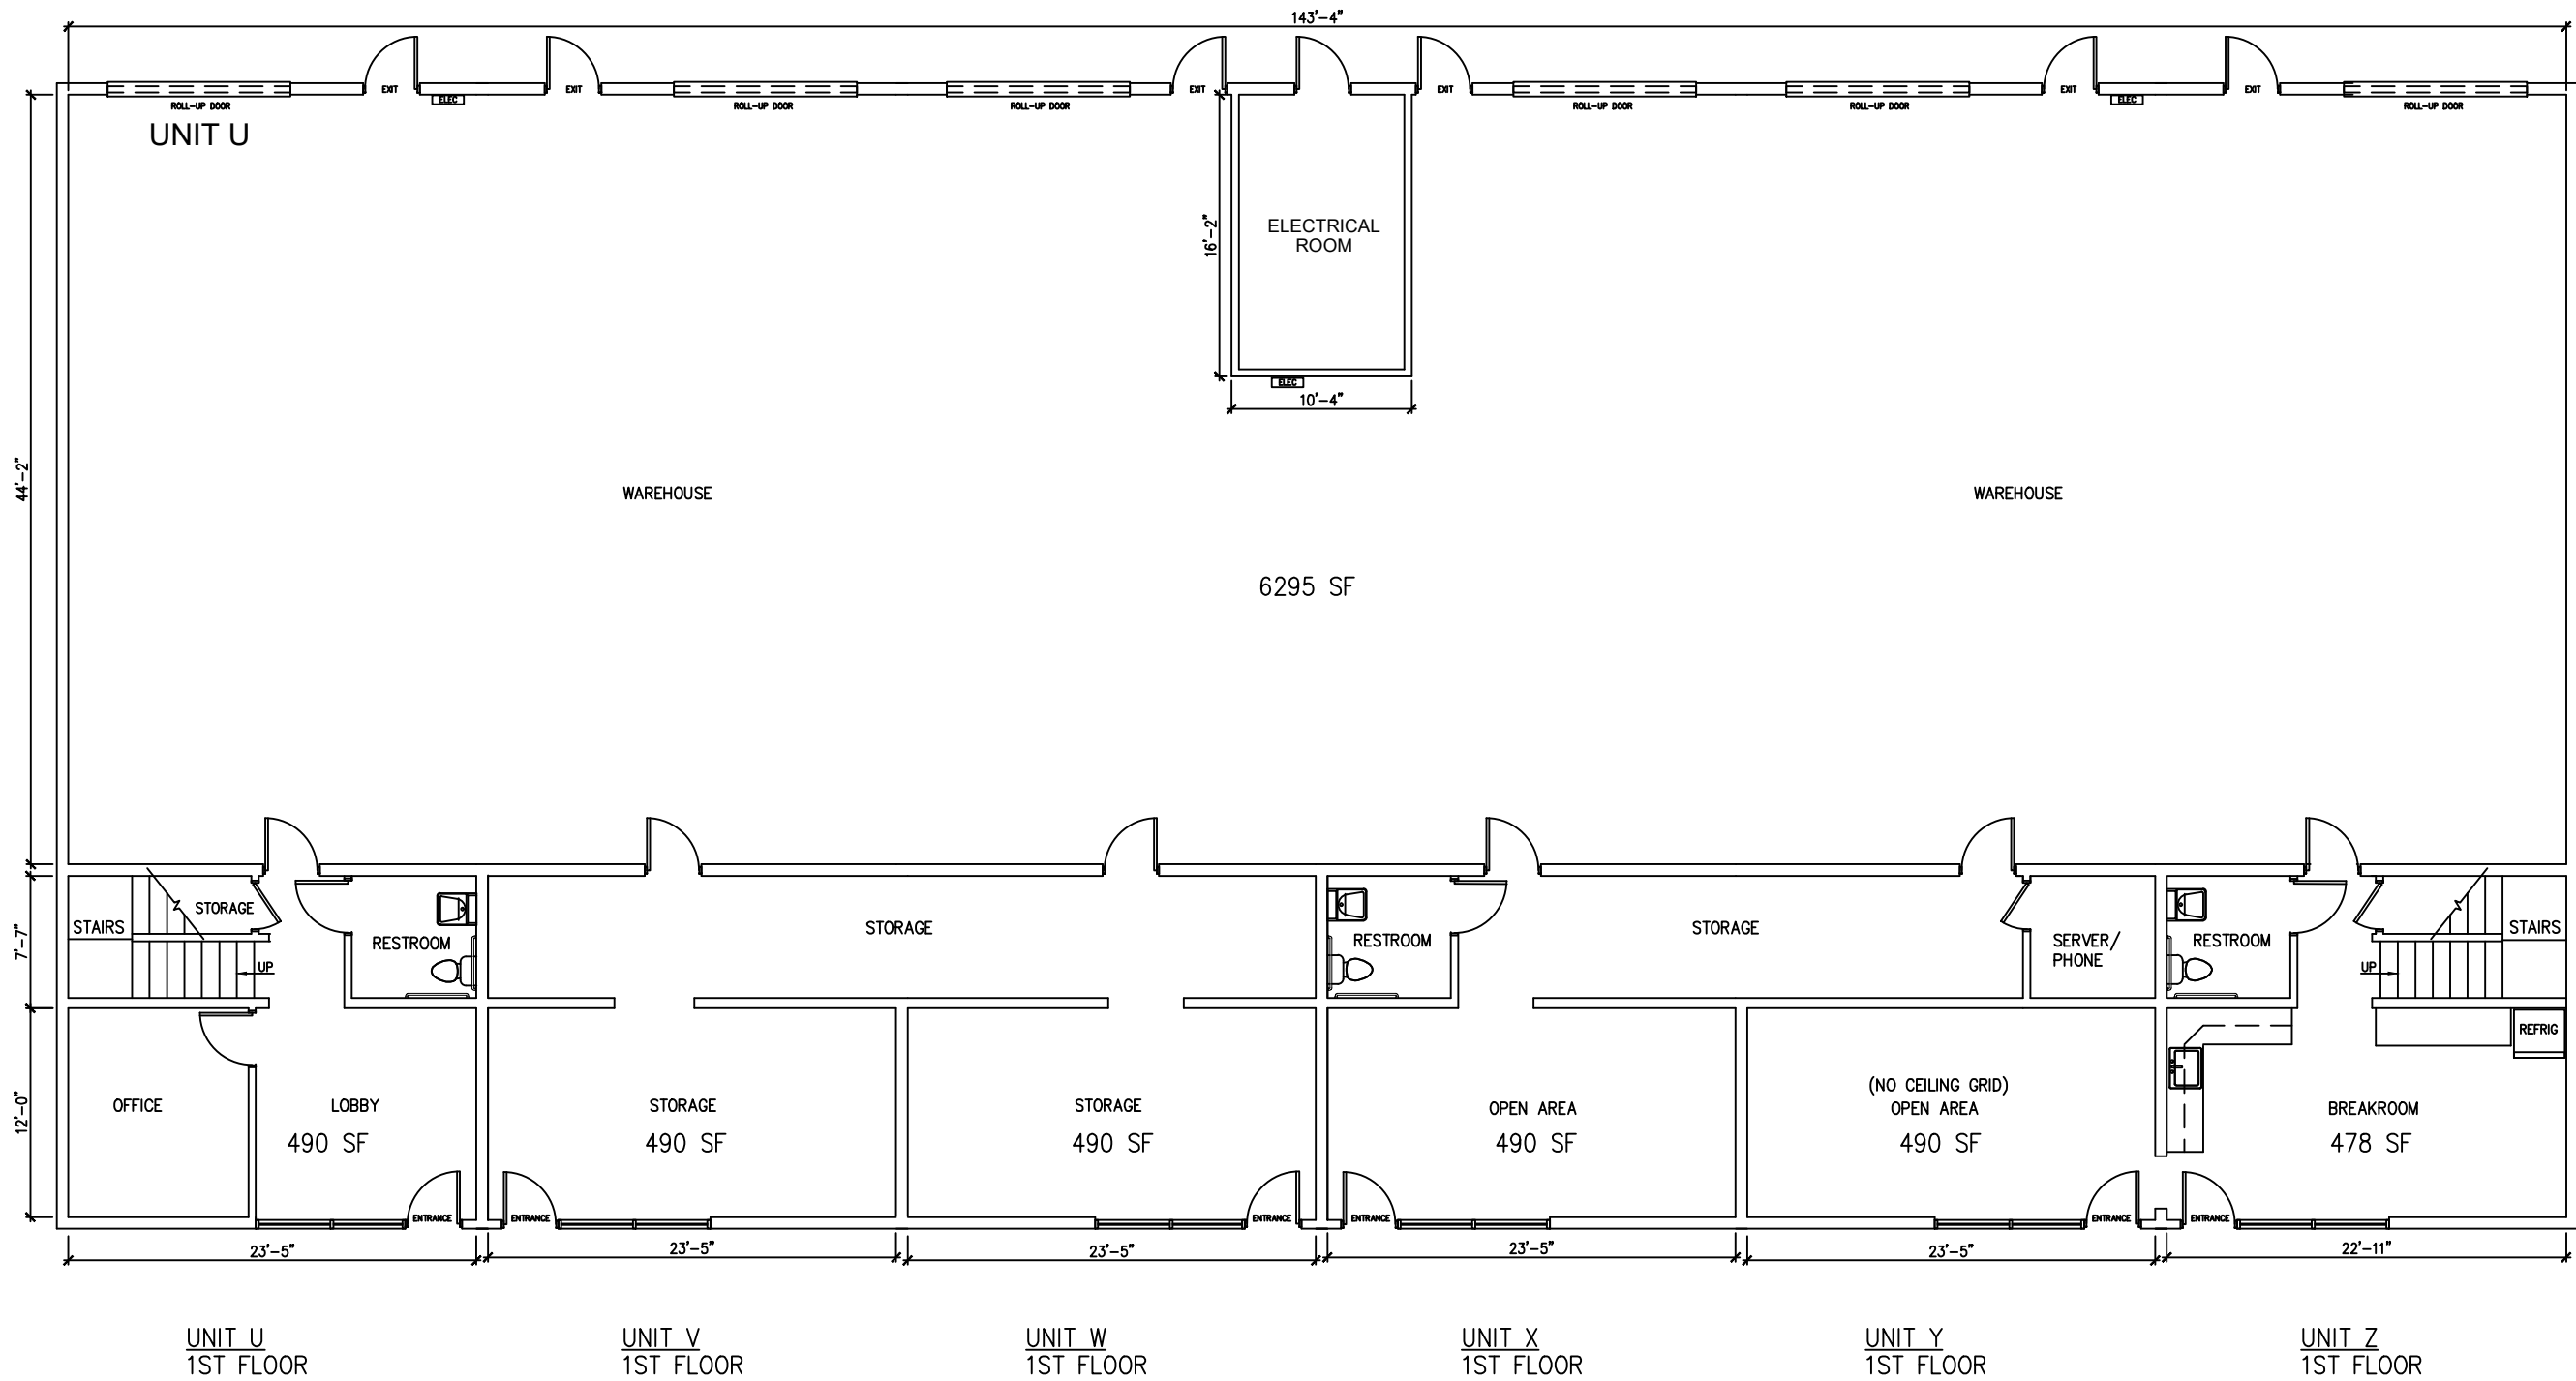

1	BURDITT DESIGNS COMMERCIAL & RESIDENTIAL INTERIORS MAIN 805-501-6399	AGOURA BUSINESS CENTER UNITS U-Z 5304 DERRY AVE AGOURA HILLS, CA
	1ST FLOOR AS-BUILT PLAN	
	Title: AS-BUILT PLAN Drawn by: J. Burditt Scale: 3/32"=1' Date: 12.02.20	