



1st Building front

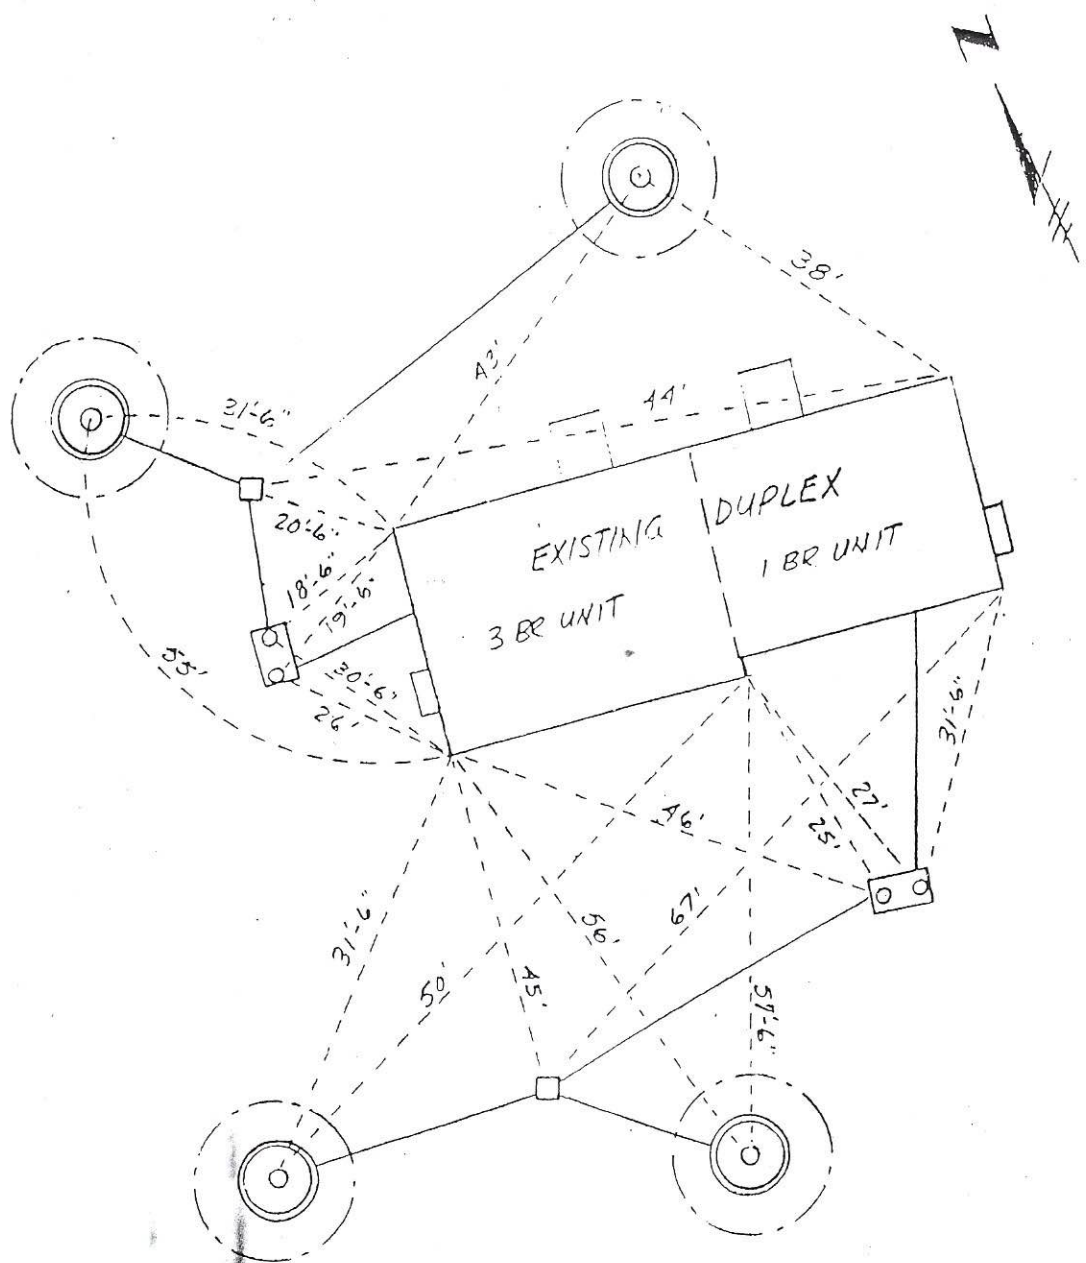


AS BUILT LOCATIONS PLAN

Parcel 3, off Center Street, @ Erickson's Lane, Pembroke

ROBERT E. HANNIGAN ASSOCIATES
406 WILLARD STREET SUITE 201
QUINCY, MASSACHUSETTS 02169
5.19.86

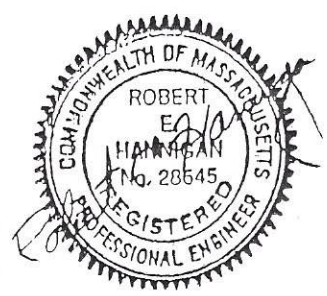

2nd Building Back

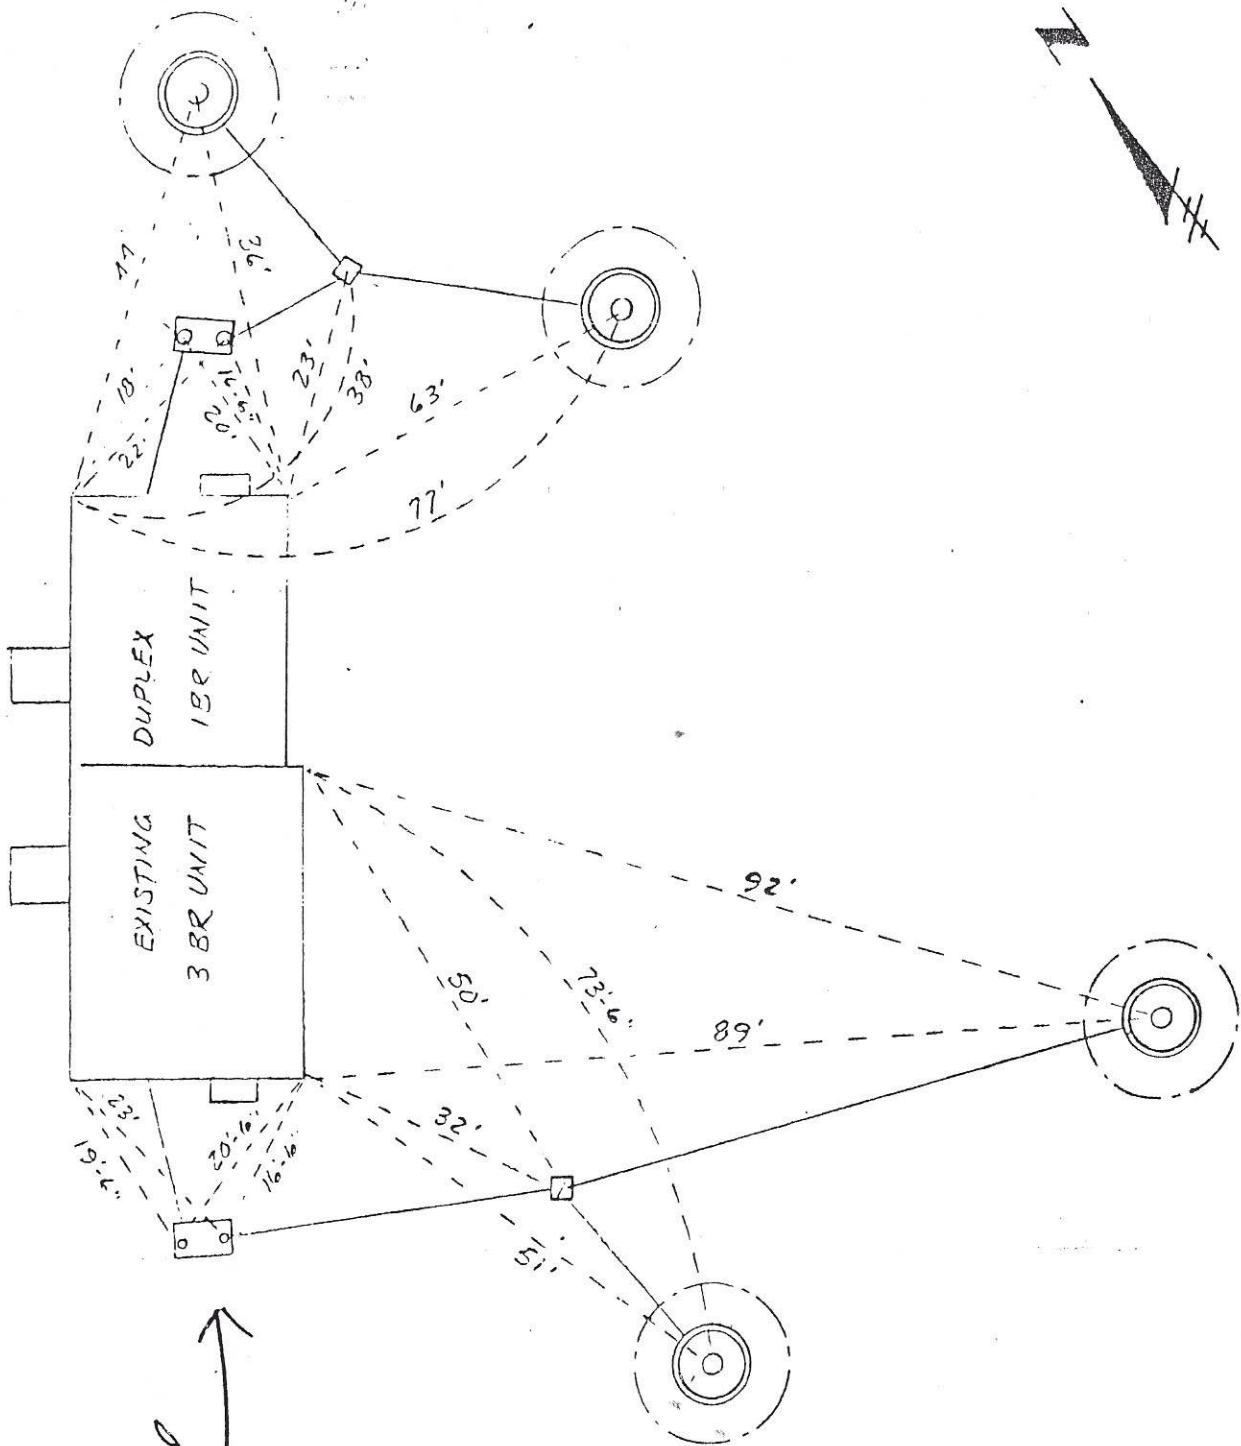

Purp

AS BUILT LOCATION PLAN

LOT 1, off Center Street @ Erickson's Lane, Pembroke

ROBERT E. HANNIGAN ASSOCIATES
406 WILLARD STREET, SUITE 201
QUINCY, MASSACHUSETTS 02169

