

**SECOND FLOOR
OFFICE RETROFIT**
2145 PORTAGE AVE.
WINNIPEG, MANITOBA



CLIENT REVIEW SIGNATURE:

ARCHITECTURAL SEAL

SHEET TITLE:
SECOND FLOOR PLAN

PROJECT NO: 2018180
DRAWN BY: RR
CHECKED BY: JV
SCALE: 3/32"=1'-0"
ISSUED FOR: AS-BUILT
ISSUE DATE: 11 AUGUST 2020

AA-1.1R9
CD
DATE PLOTTED
8/11/20

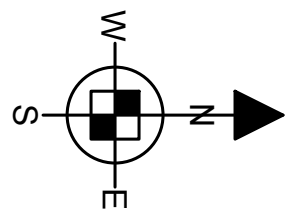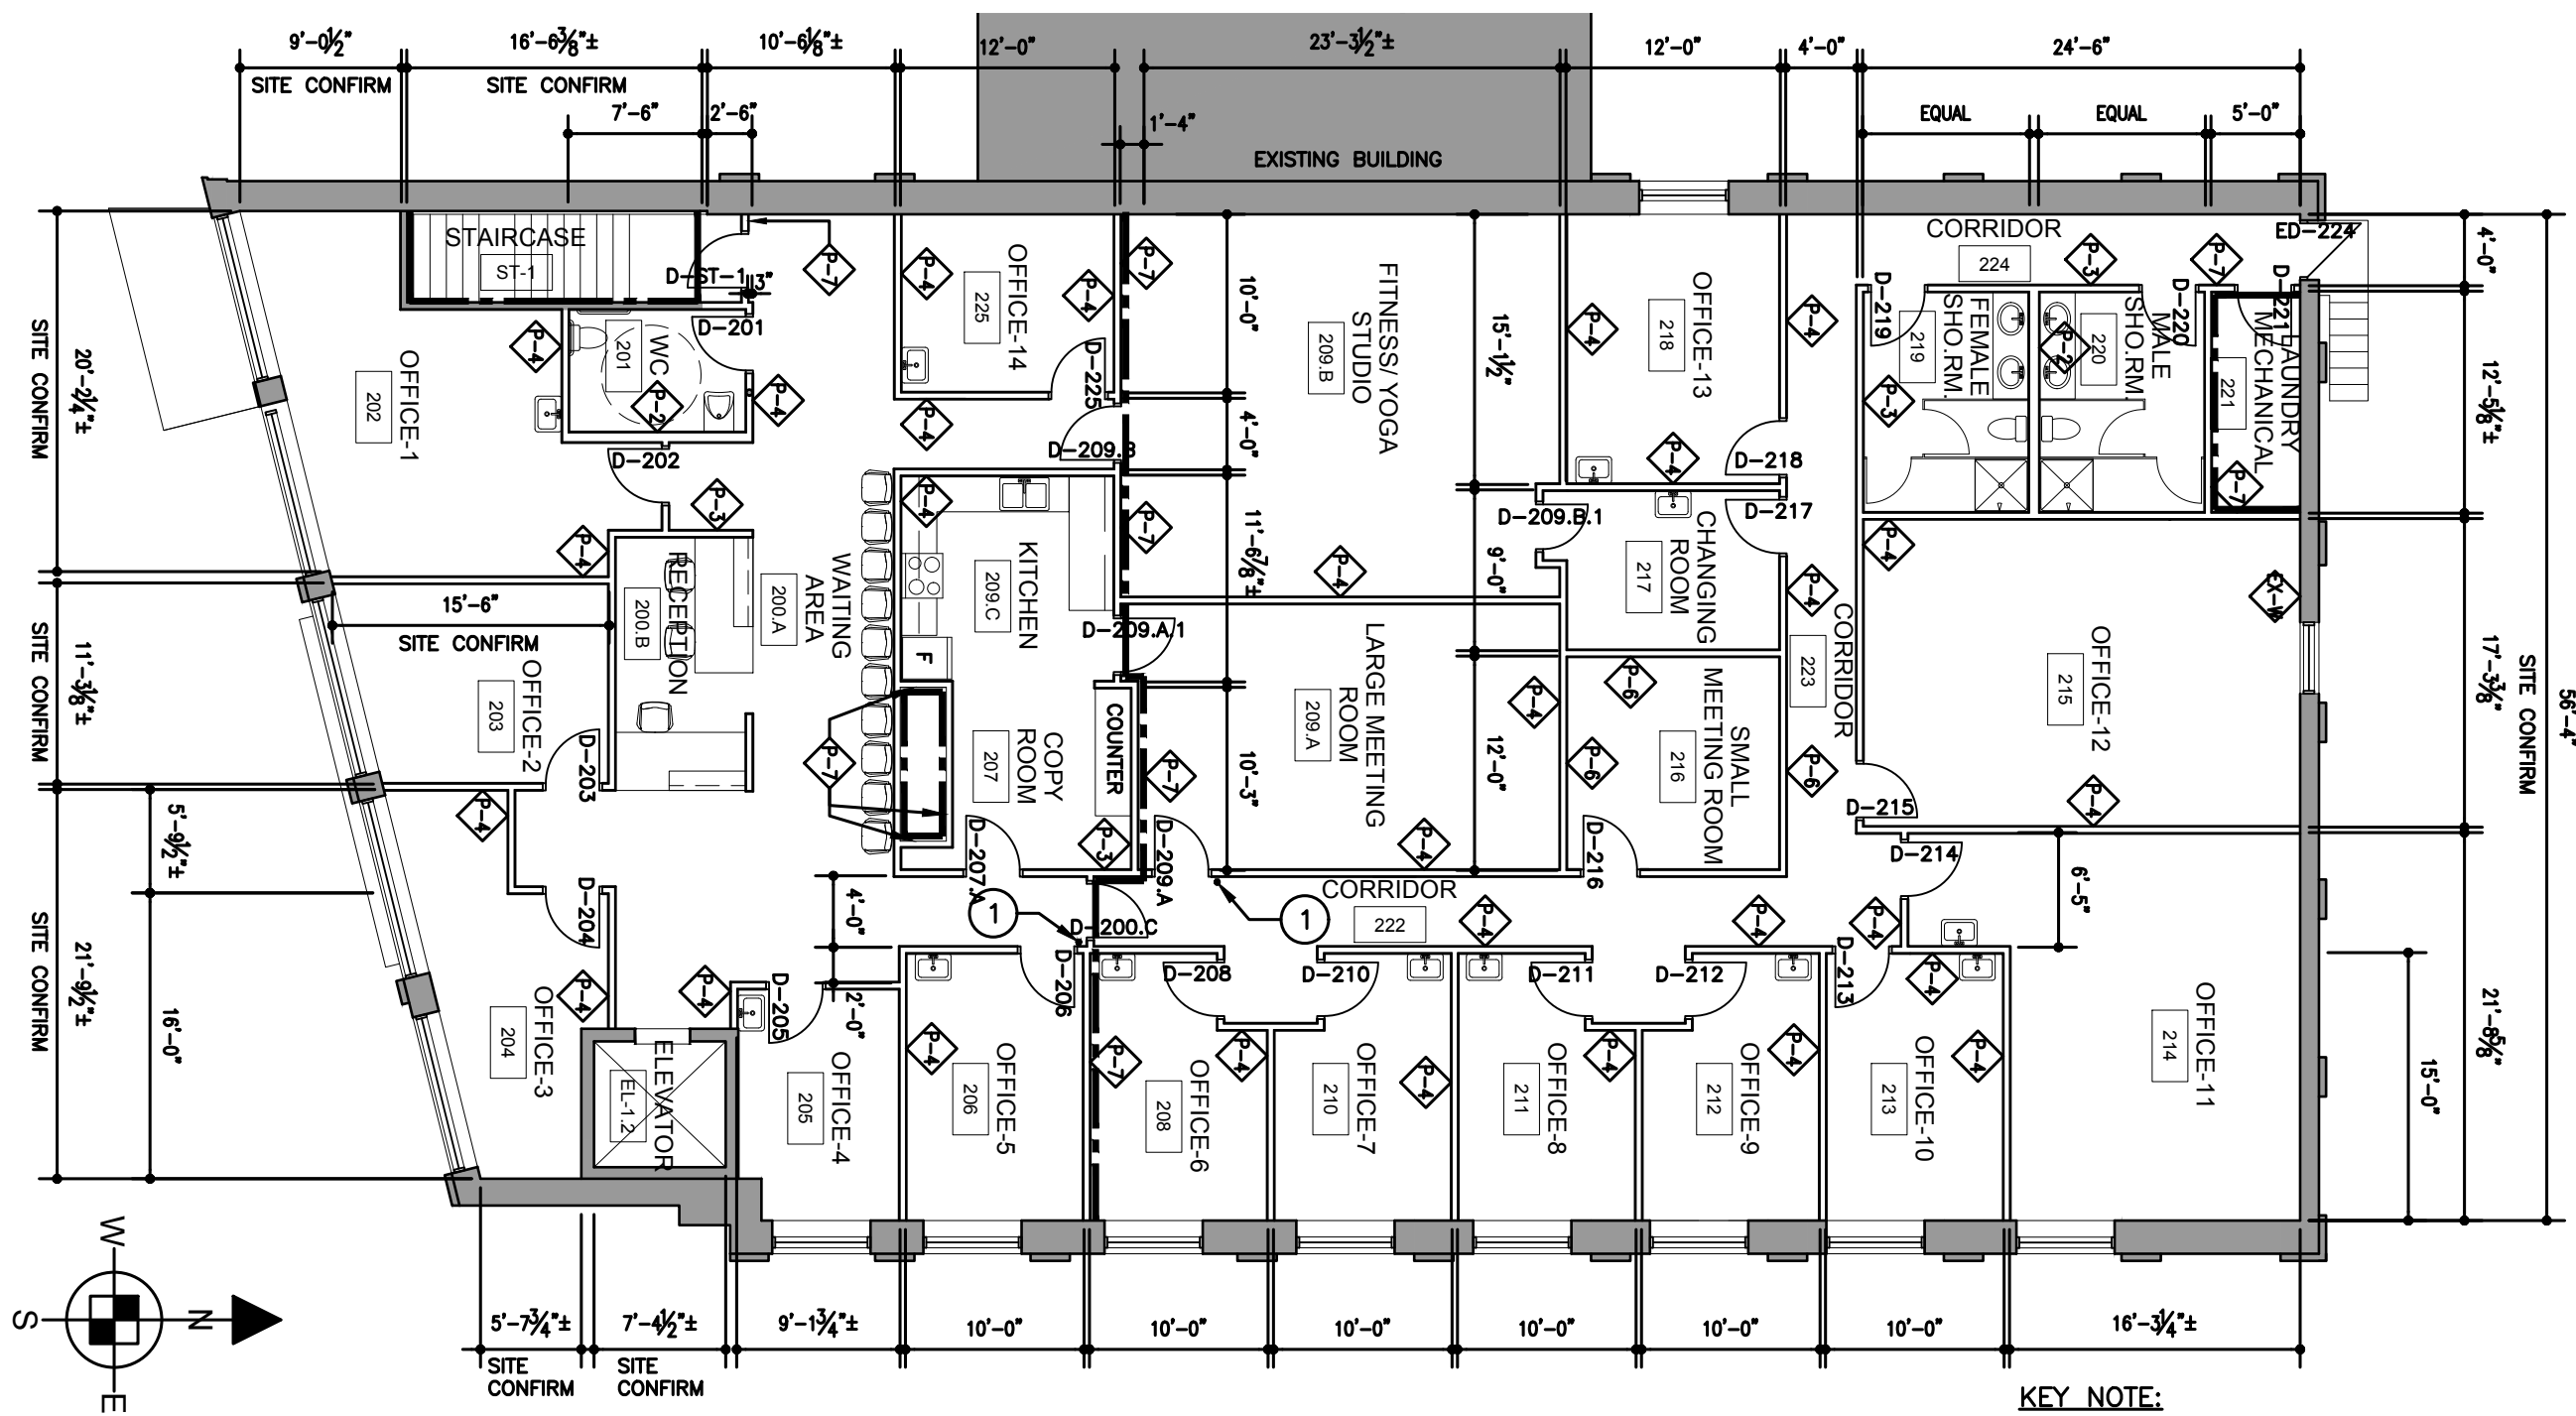

KEY NOTE:

① PUSH BUTTON DOOR OPERATOR

SECOND FLOOR PLAN
3/32"=1'-0"

1 AA-1.1 1 AA-1.1R8

PARTITION TYPES

P-1 PARTITION
5/8" GYP.BD.
6" STEEL STUDS @ 16" O.C.
5/8" GYP.BD.

P-2 PARTITION
5/8" GYP.BD.
6" STEEL STUDS @ 16" O.C.
SOUND BATT INSULATION
RESILIENT CHANNEL ON OFFICE SIDE
5/8" GYP.BD.

P-3 PARTITION
5/8" GYP.BD.
3-5/8" STEEL STUDS @ 16" O.C.
5/8" GYP.BD.

P-4 PARTITION
5/8" GYP.BD.
3-5/8" STEEL STUDS @ 16" O.C.
SOUND BATT INSULATION
5/8" GYP.BD.

P-5 PARTITION
5/8" GYP.BD.
3-5/8" STEEL STUDS @ 16" O.C.

P-6 PARTITION (1HR RATED)
5/8" GYP.BD. TYPE X
3-5/8" STEEL STUDS @ 16" O.C.
SOUND BATT INSULATION
RESILIENT CHANNEL ON OFFICE SIDE
5/8" GYP.BD. TYPE X

P-7 PARTITION (1HR RATED)
5/8" GYP.BD. TYPE X
3-5/8" STEEL STUDS @ 16" O.C.
SOUND BATT INSULATION
5/8" GYP.BD. TYPE X

NOTE:
ALL PARTITIONS TO U/S OF STRUCTURE
UNLESS NOTED OTHERWISE