


EAST 27TH STREET



E 26TH STREET

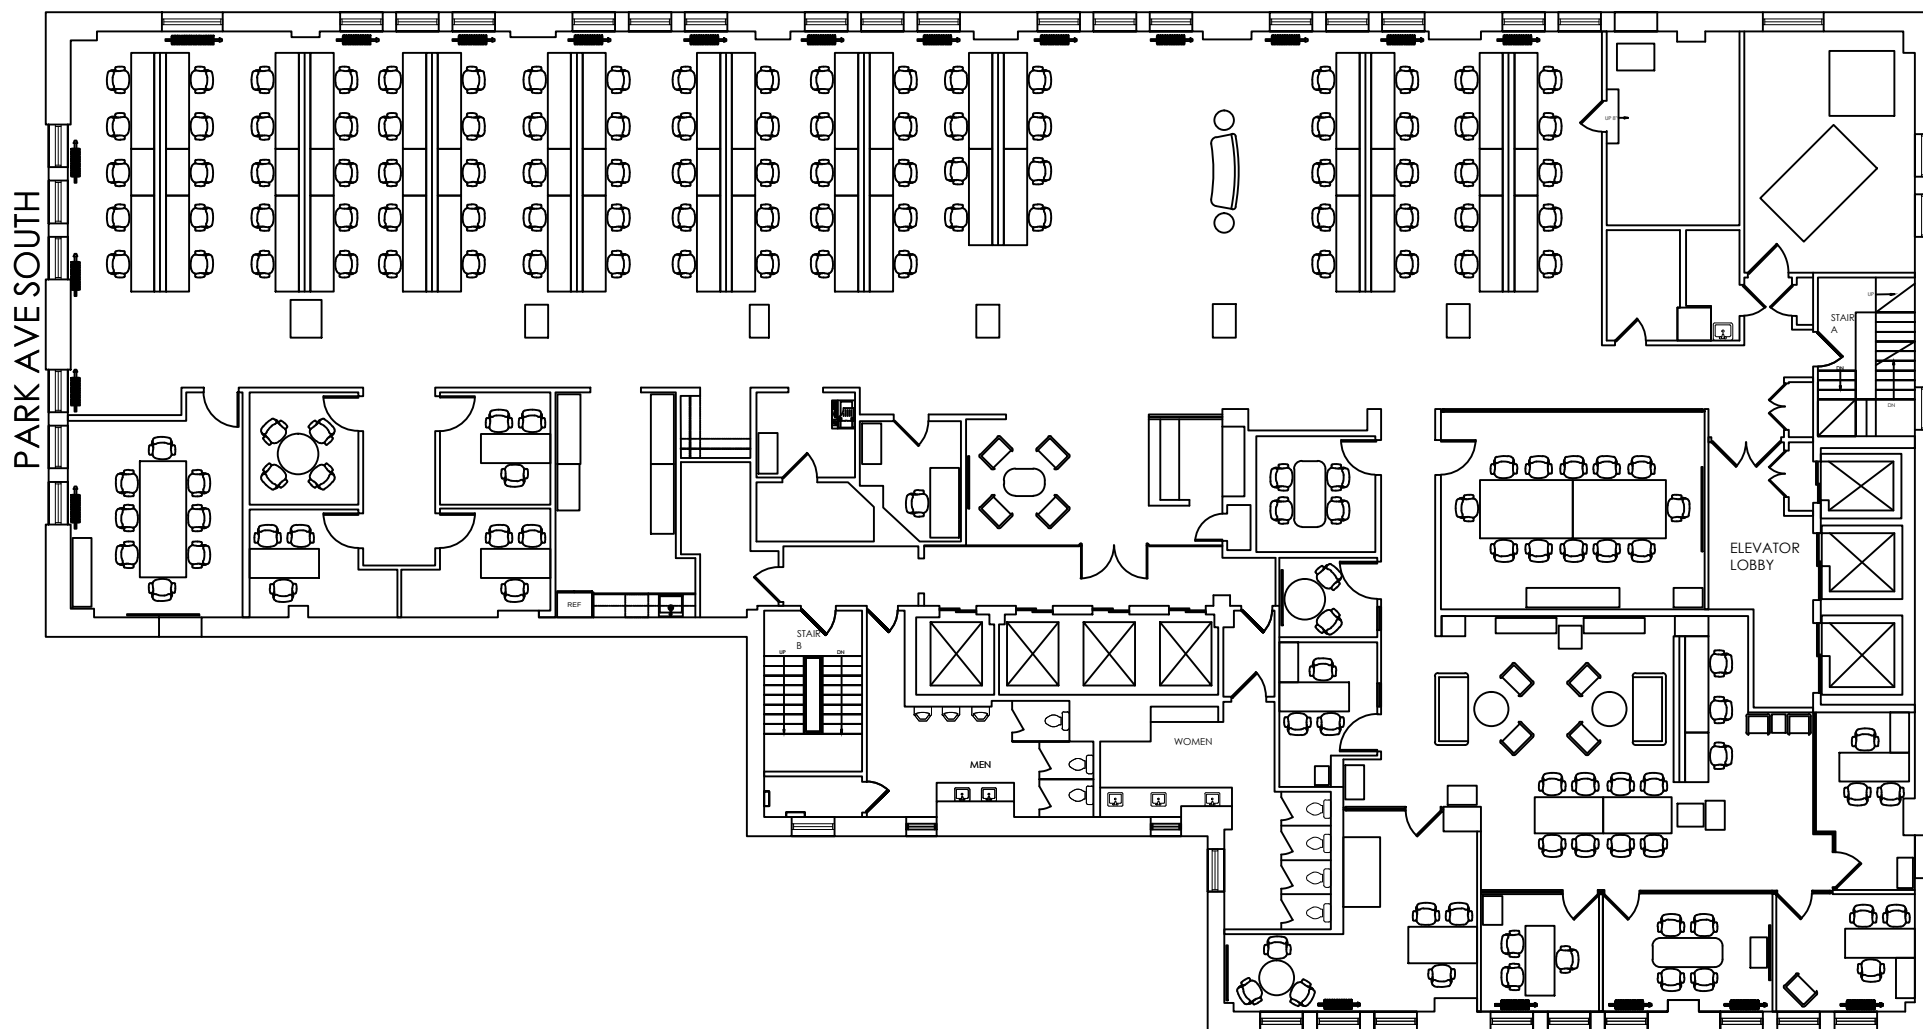

575 Eighth Avenue, Suite 2400
New York, NY 10018
(212) 564-6662
Fax: (212) 564-6667
www.olmsteadinc.com

381 Park Ave South
New York, NY 10016

5th Floor



All areas and dimensions
are approximate. Field
verification is necessary.
Date Printed: