


FIRST FLOOR PLAN

SCALE: 1" = 20'-0"

FIRST FLOOR AS BUILT

1" = 20'-0"


05/28/15

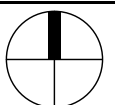

COPYRIGHT 2015: MYEFSKI ARCHITECTS, INC. EXPRESSLY RESERVES ITS COMMON LAW COPYRIGHT AND OTHER PROPERTY RIGHTS IN THESE DRAWINGS. THESE DRAWINGS ARE NOT TO BE REPRODUCED, CHANGED OR COPIED IN ANY FORM OR MANNER WHATSOEVER, NOR ARE THEY TO BE ASSIGNED TO ANY THIRD PARTY WITHOUT FIRST OBTAINING THE EXPRESSED WRITTEN PERMISSION OF MYEFSKI ARCHITECTS, INC.

ICE HOUSE

JEFF SCALES | 609 South Blvd., Evanston, Illinois

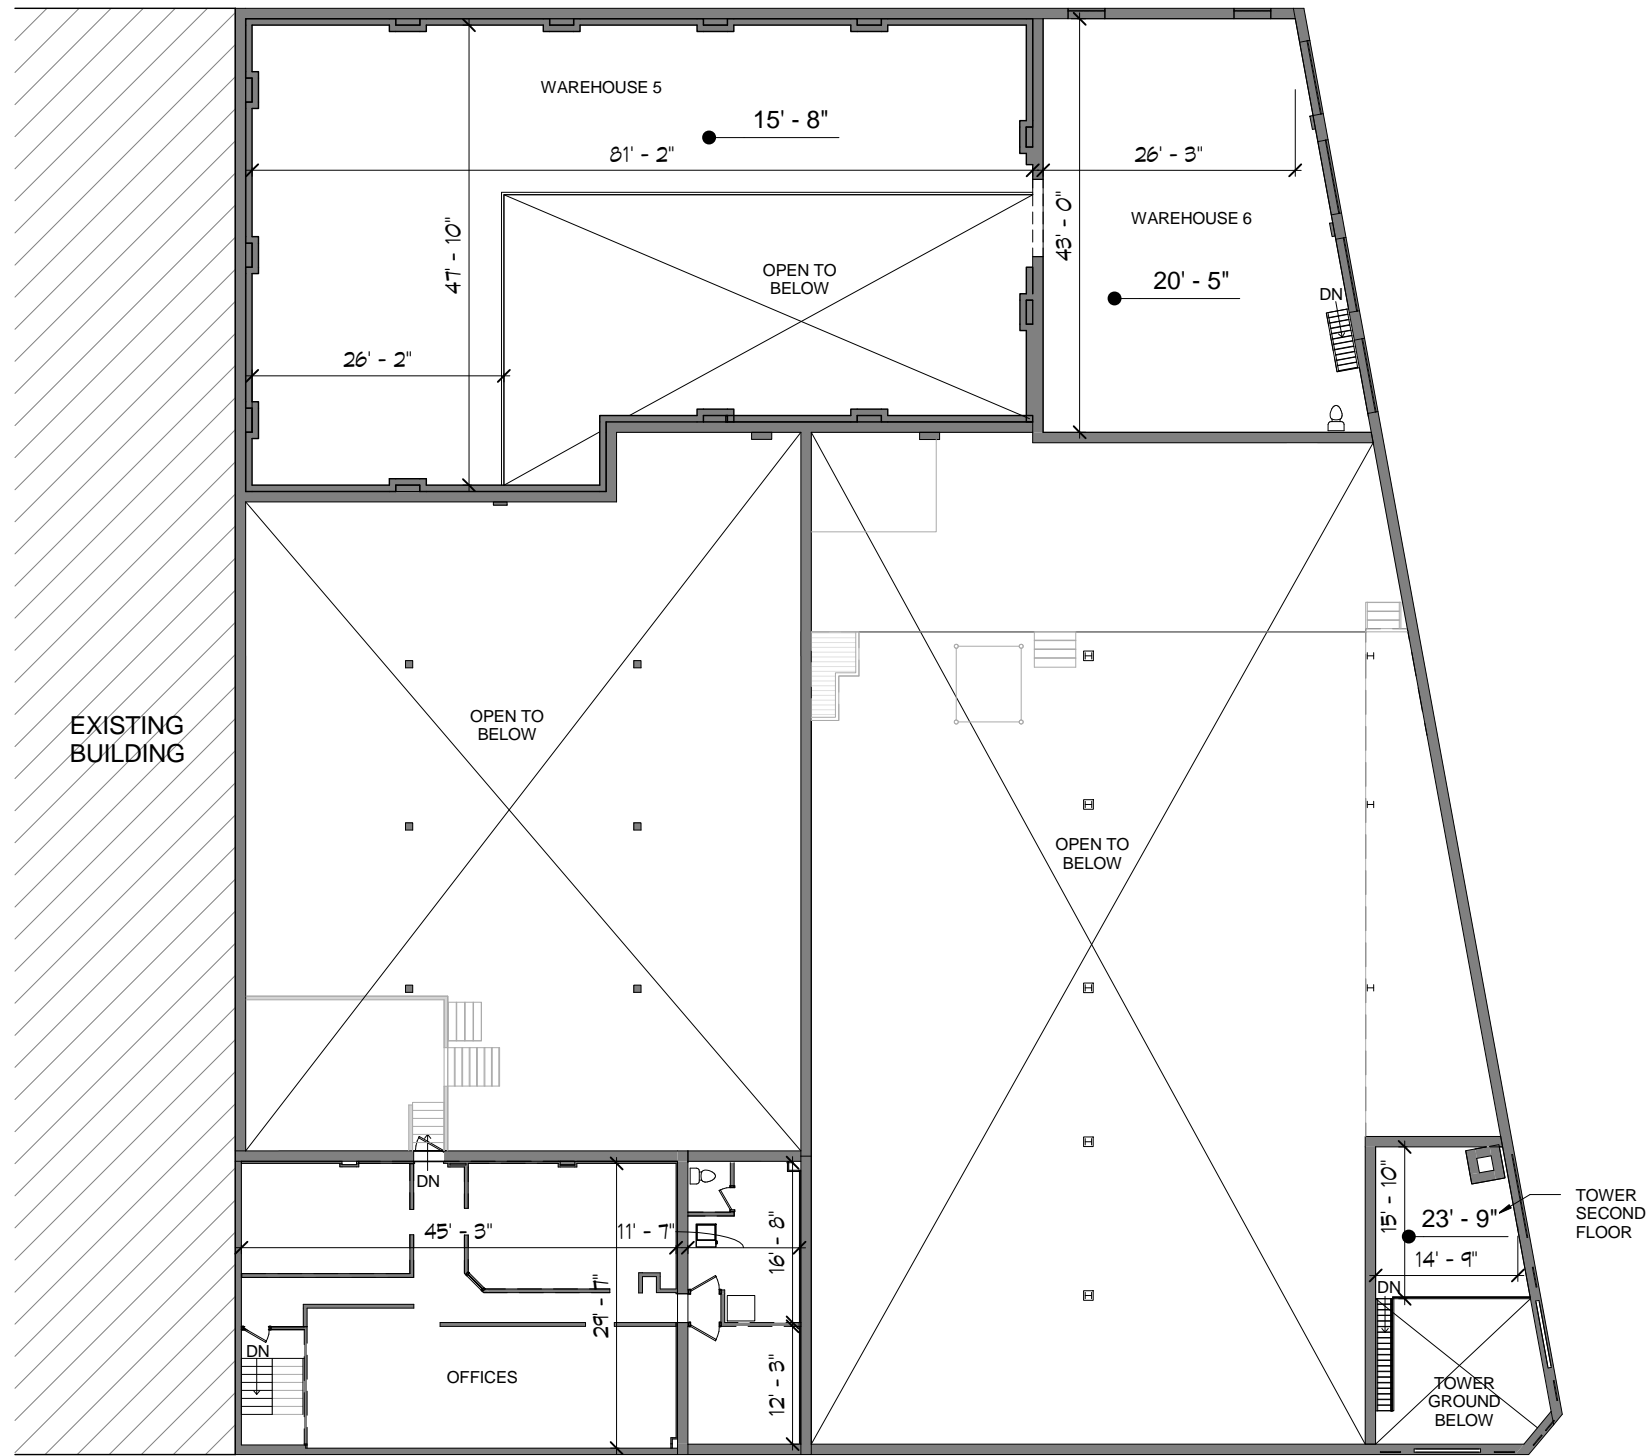

SECOND FLOOR PLAN

SCALE: 1" = 20'-0"



COPYRIGHT 2015: MYEFSKI ARCHITECTS, INC. EXPRESSLY RESERVES ITS COMMON LAW COPYRIGHT AND OTHER PROPERTY RIGHTS IN THESE DRAWINGS. THESE DRAWINGS ARE NOT TO BE REPRODUCED, CHANGED OR COPIED IN ANY FORM OR MANNER WHATSOEVER, NOR ARE THEY TO BE ASSIGNED TO ANY THIRD PARTY WITHOUT FIRST OBTAINING THE EXPRESSED WRITTEN PERMISSION OF MYEFSKI ARCHITECTS, INC.


ICE HOUSE

JEFF SCALES | 609 South Blvd., Evanston, Illinois

SECOND FLOOR AS BUILT

1" = 20'-0"


05/28/15

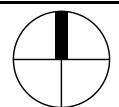



EXISTING SOUTH ELEVATION

SCALE: 1" = 20'-0"

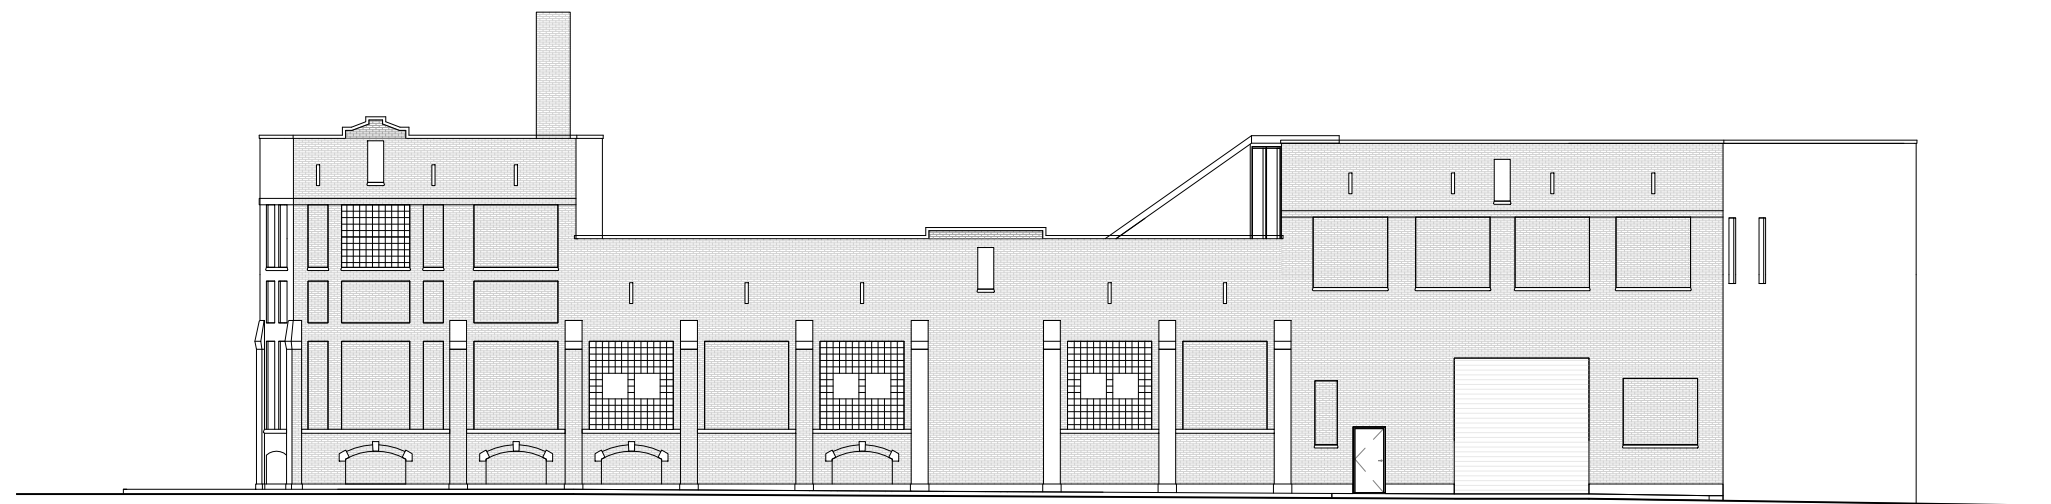

EXISTING EAST ELEVATION

SCALE: 1" = 20'-0"



COPYRIGHT 2015: MYEFSKI ARCHITECTS, INC. EXPRESSLY RESERVES ITS COMMON LAW COPYRIGHT AND OTHER PROPERTY RIGHTS IN THESE DRAWINGS. THESE DRAWINGS ARE NOT TO BE REPRODUCED, CHANGED OR COPIED IN ANY FORM OR MANNER WHATSOEVER, NOR ARE THEY TO BE ASSIGNED TO ANY THIRD PARTY WITHOUT FIRST OBTAINING THE EXPRESSED WRITTEN PERMISSION OF MYEFSKI ARCHITECTS, INC.

ICE HOUSE

JEFF SCALES | 609 South Blvd., Evanston, Illinois

EXISTING EXTERIOR ELEVATIONS

1" = 20'-0"

05/28/15