

# Property Key



# Bryan Dairy As Built Marketing Package

7201 - 7281 Bryan Dairy Road, Largo, FL 33777




# BAY SPACE

Building: East Building

Suite: 7225B

Sheet: A-9


Scale: Not to Scale  
Sheet Size: 8.5" x 11"  
Not For Construction

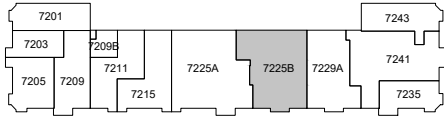

Total Area - 6,085 SF

## Building Information

DECK HEIGHT:	13'-4"
CEILING HEIGHT:	8'-10"
CLEAR HEIGHT:	12'-7"
SPRINKLERED:	Yes

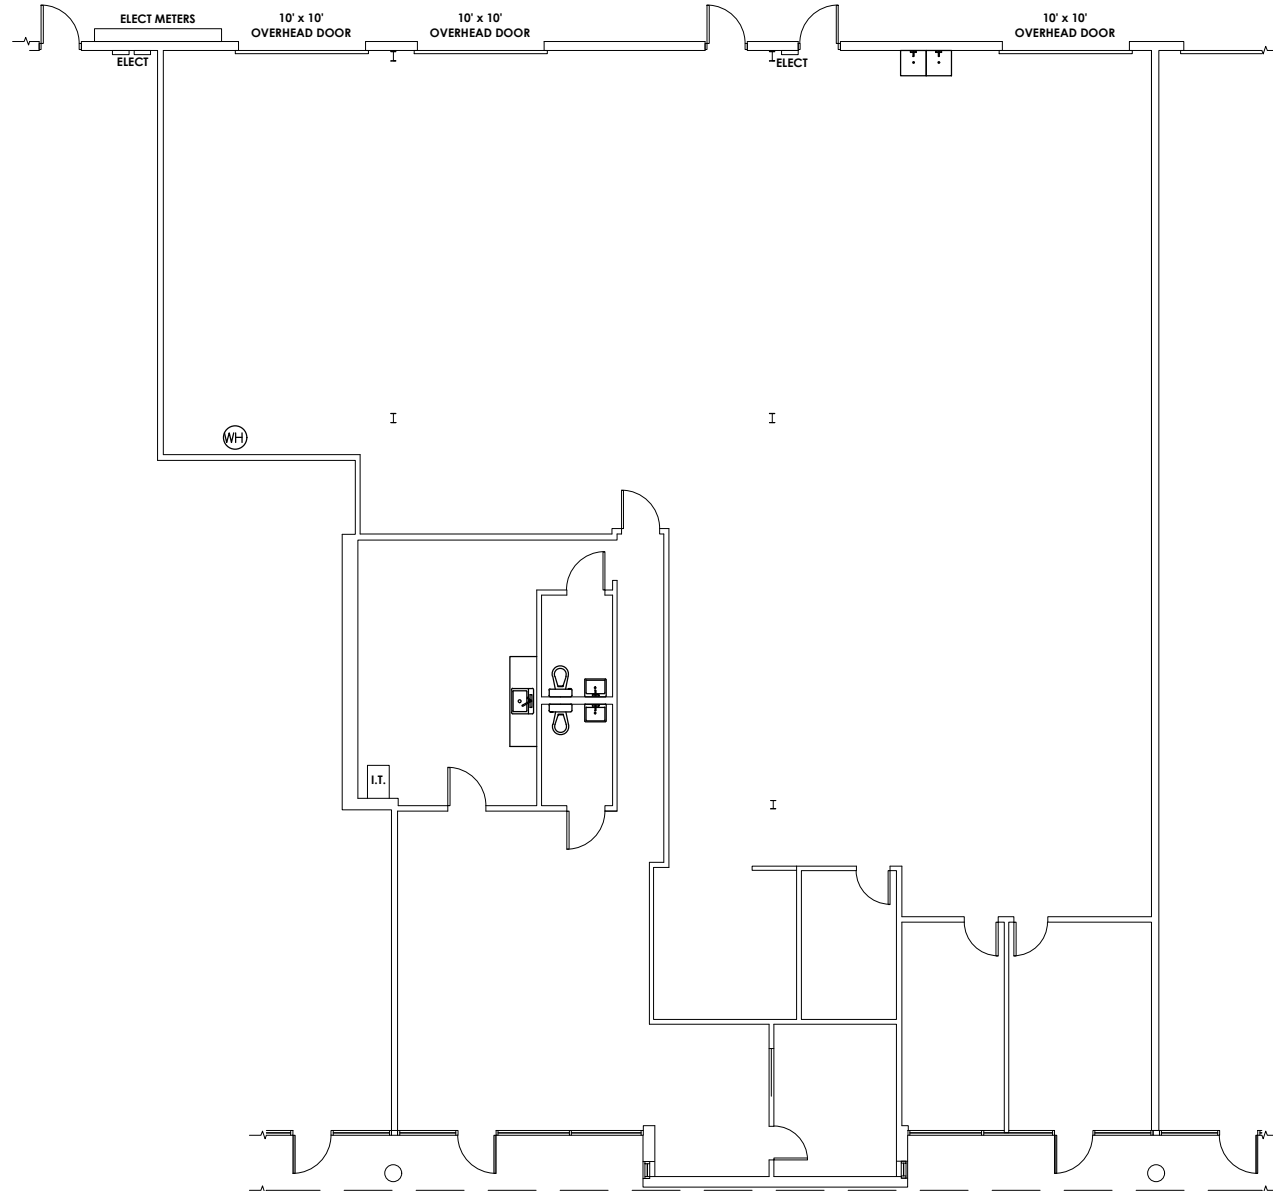

As Built Floor Plan for Marketing

