


KEY PLAN

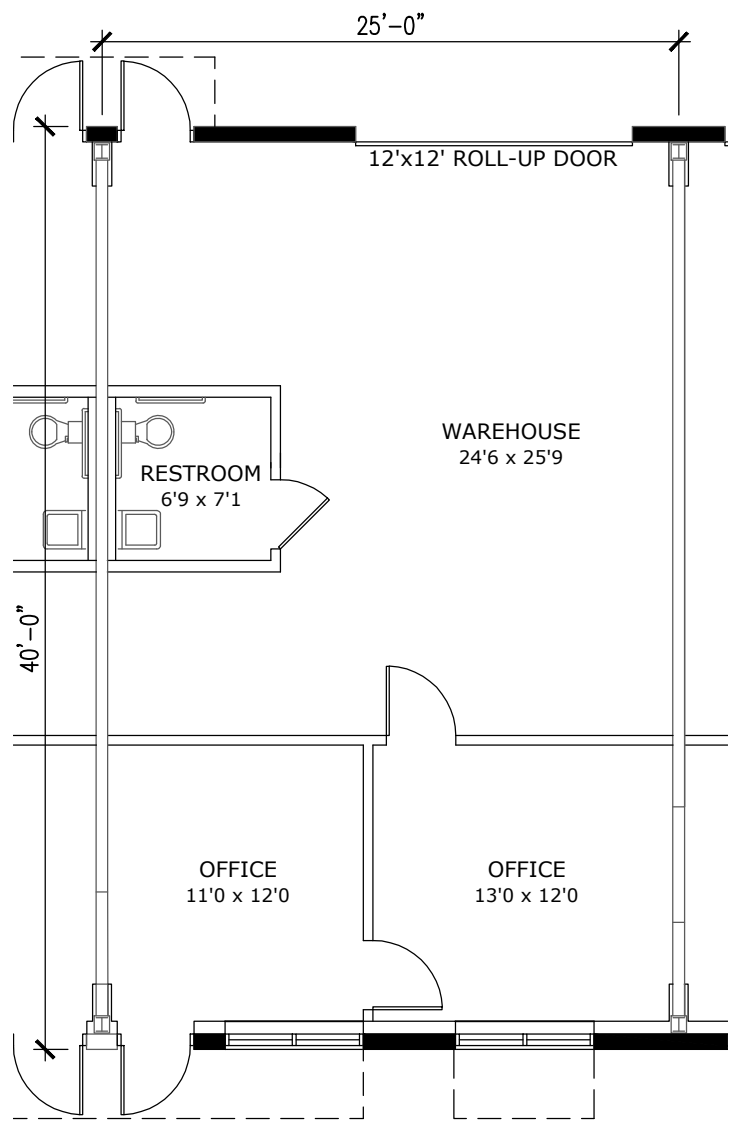

AS BUILT PLAN

512 FENTRESS BLVD, UNIT I  
 DAYTONA BEACH, FL 32114  
 340 SF OFFICE | 660 SF WAREHOUSE

USABLE INTERIOR SQUARE FOOTAGE SHOWN; PLAN IS NOT TO SCALE.