



134 West 26th Street

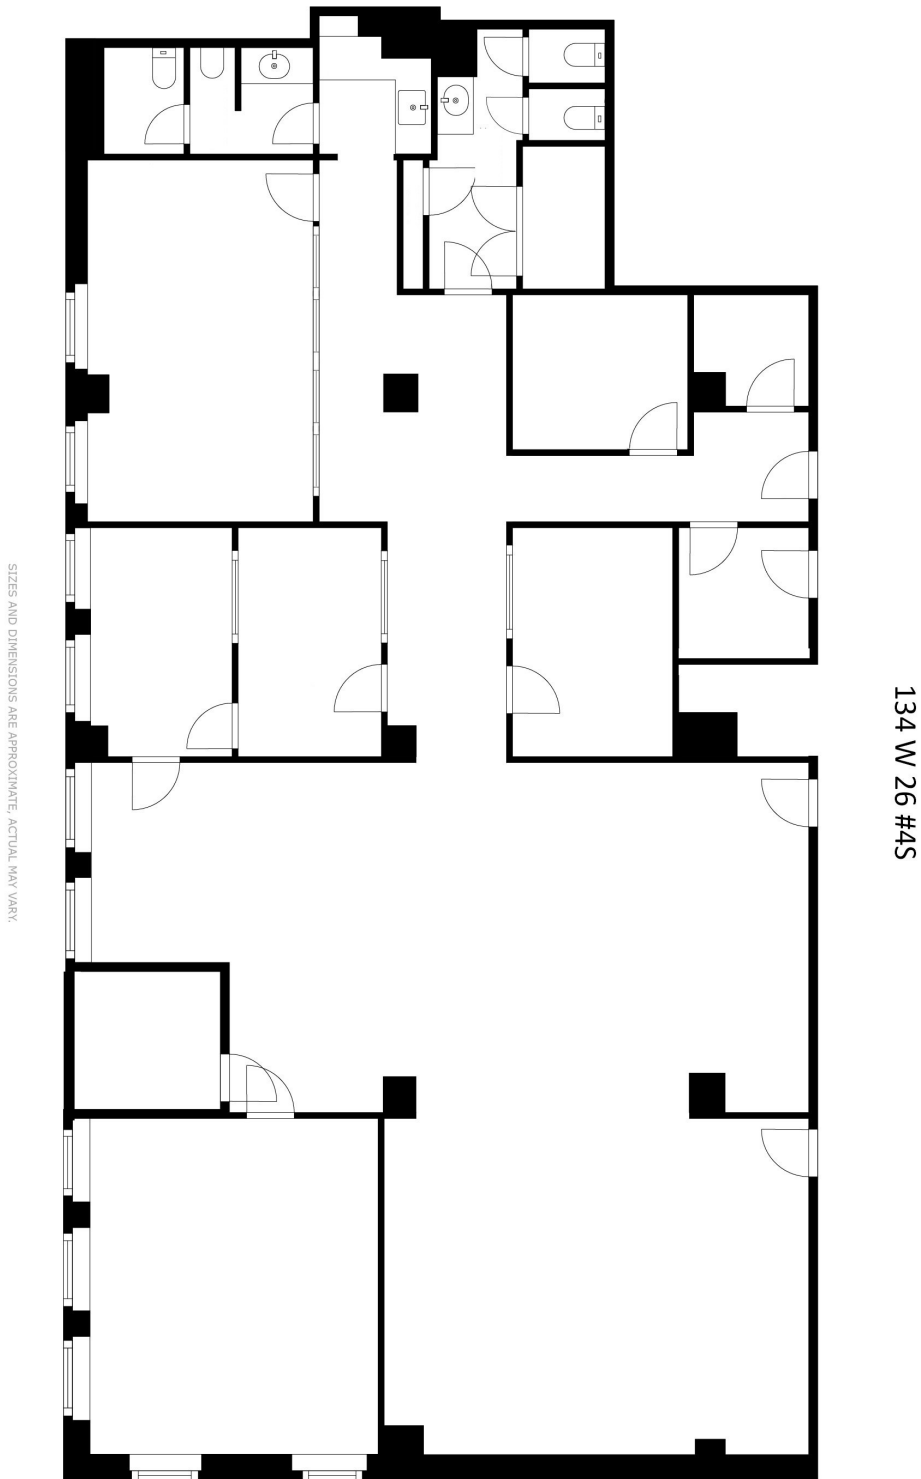

As-Built, can be modified

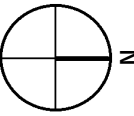

www.signaturepartners.com

Michael Pinney

(212) 813-3573

pinney@signaturepartners.com