


7TH FLOOR | SUITE 770 | 6,347 RSF

As-Built Condition | Available Now

EYE STREET NW

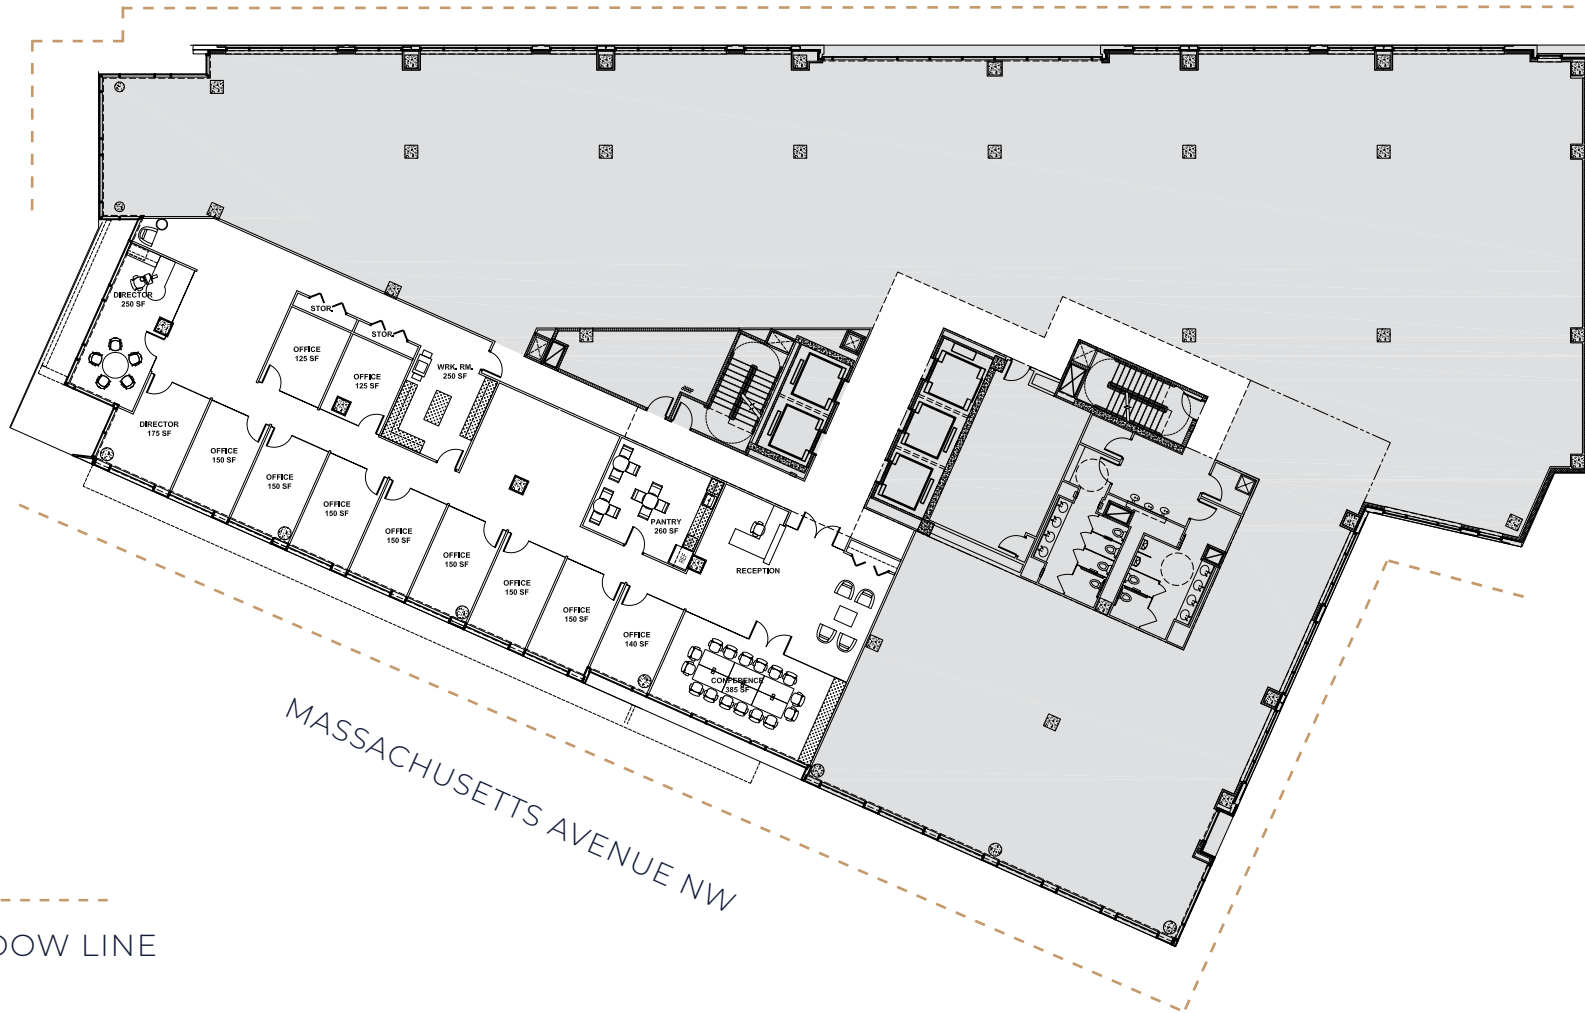

WINDOW LINE