
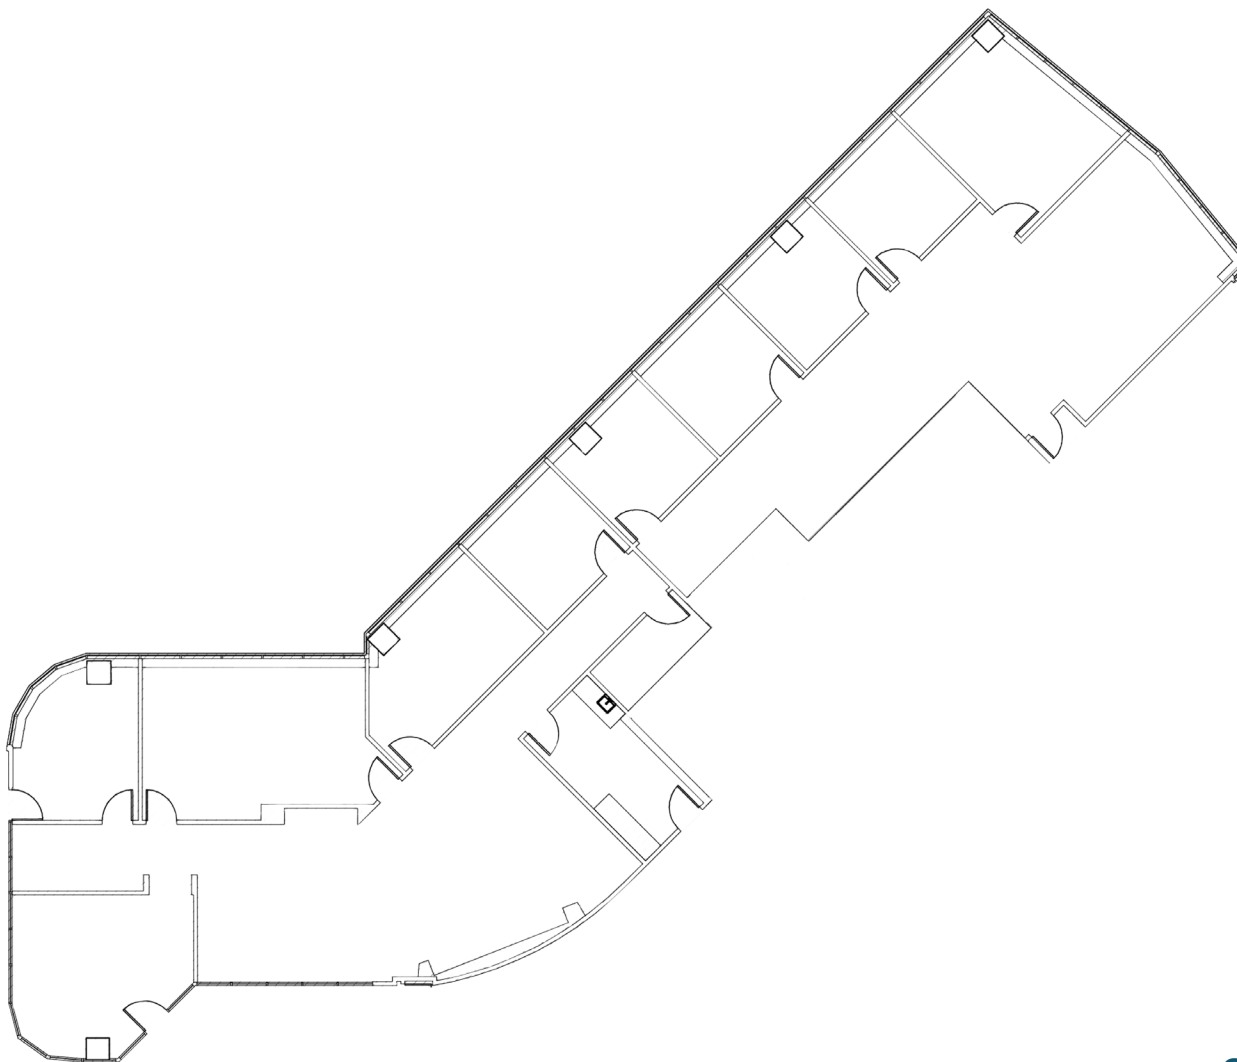


SPACE AVAILABLE

SUITE 150: 5,500 SF

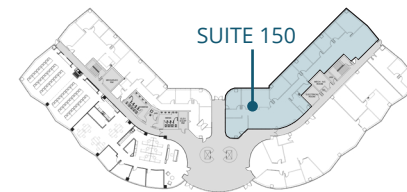

ONE AMERILIFE PLACE
2600 McCormick Dr
Clearwater, FL 33759

No warranty or representation, expressed or implied, is made to the accuracy of information contained herein, and same is submitted subject to errors, change of price, rental or other conditions, withdrawal without notice, and to any special listing conditions imposed by our principals. PLANS NOT TO SCALE

MATT ALEXANDER
813.559.2006
Matthew.Alexander@FranklinSt.com

CHAD RUPP
813.345.5891
Chad.Rupp@FranklinSt.com

 **FranklinStreet**
Licensed Real Estate Broker | FranklinSt.com