
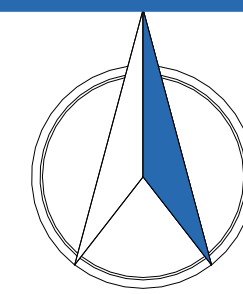


Property Key

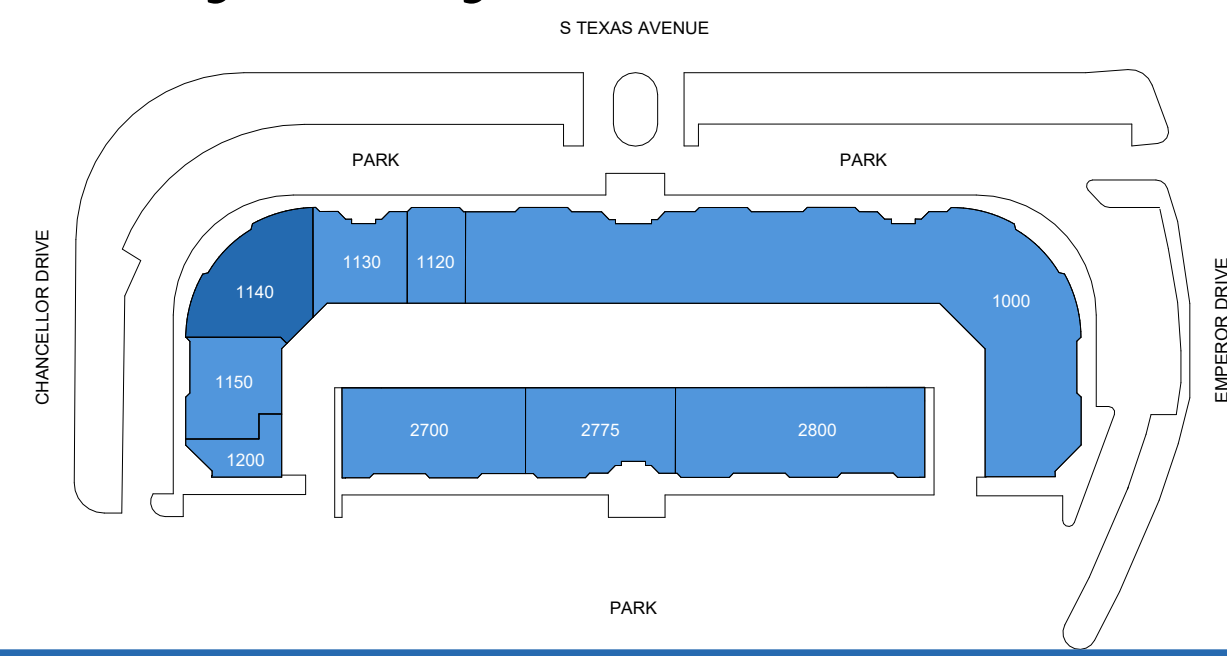

Lakefront As Built Marketing Package

6101 Chancellor Dr, Orlando, FL 32809, US

Building: 6101

Suite: 1140

Sheet **E1**



BAY SPACE


Scale: Not to Scale
Sheet Size: 42" x 30"
Not For Construction

Usable Square Foot Analysis

Office Area	8,500	100 %
Warehouse Area	0	0%
Total Area	8,500	

Building Information

Deck Height:	16' - 6"
Clear Height:	11' - 0 1/4"
Ceiling Height:	9' - 1"
Sprinklered:	<input checked="" type="checkbox"/> Yes <input type="checkbox"/> No
Mechanical Area:	158 SQFT

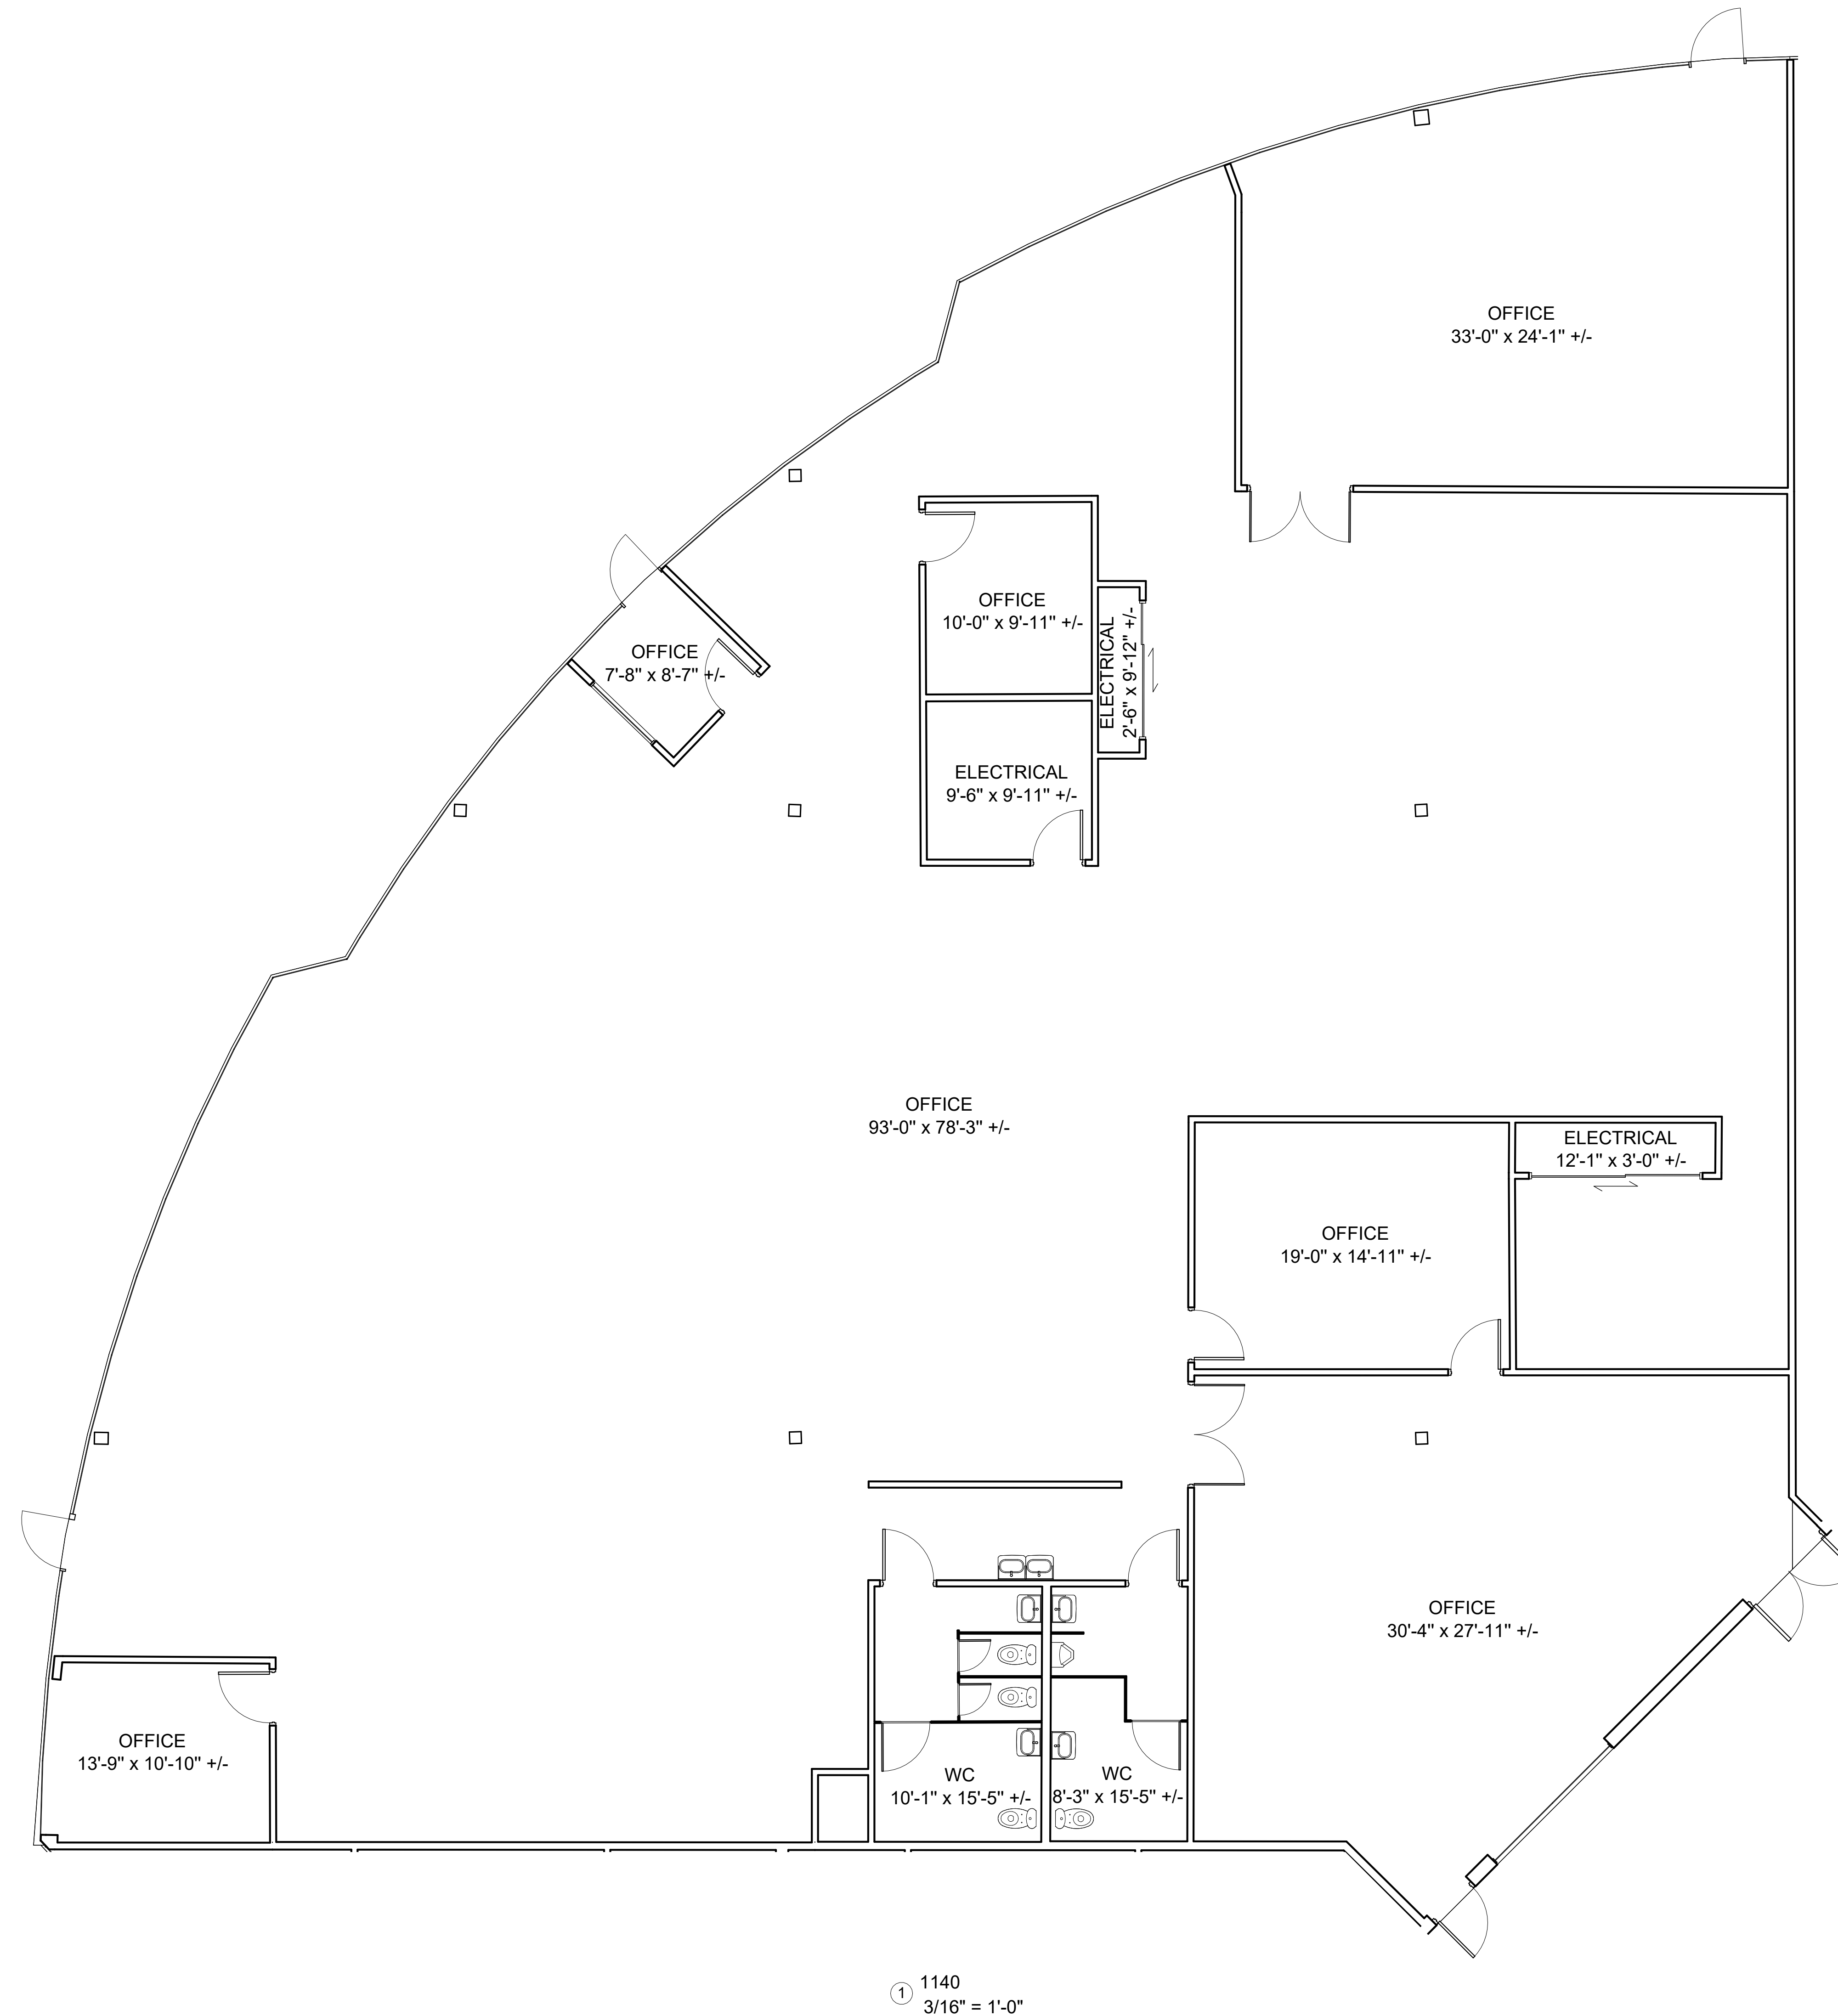

① 1140
3/16" = 1'-0"

As Built Floor Plan for Marketing

