
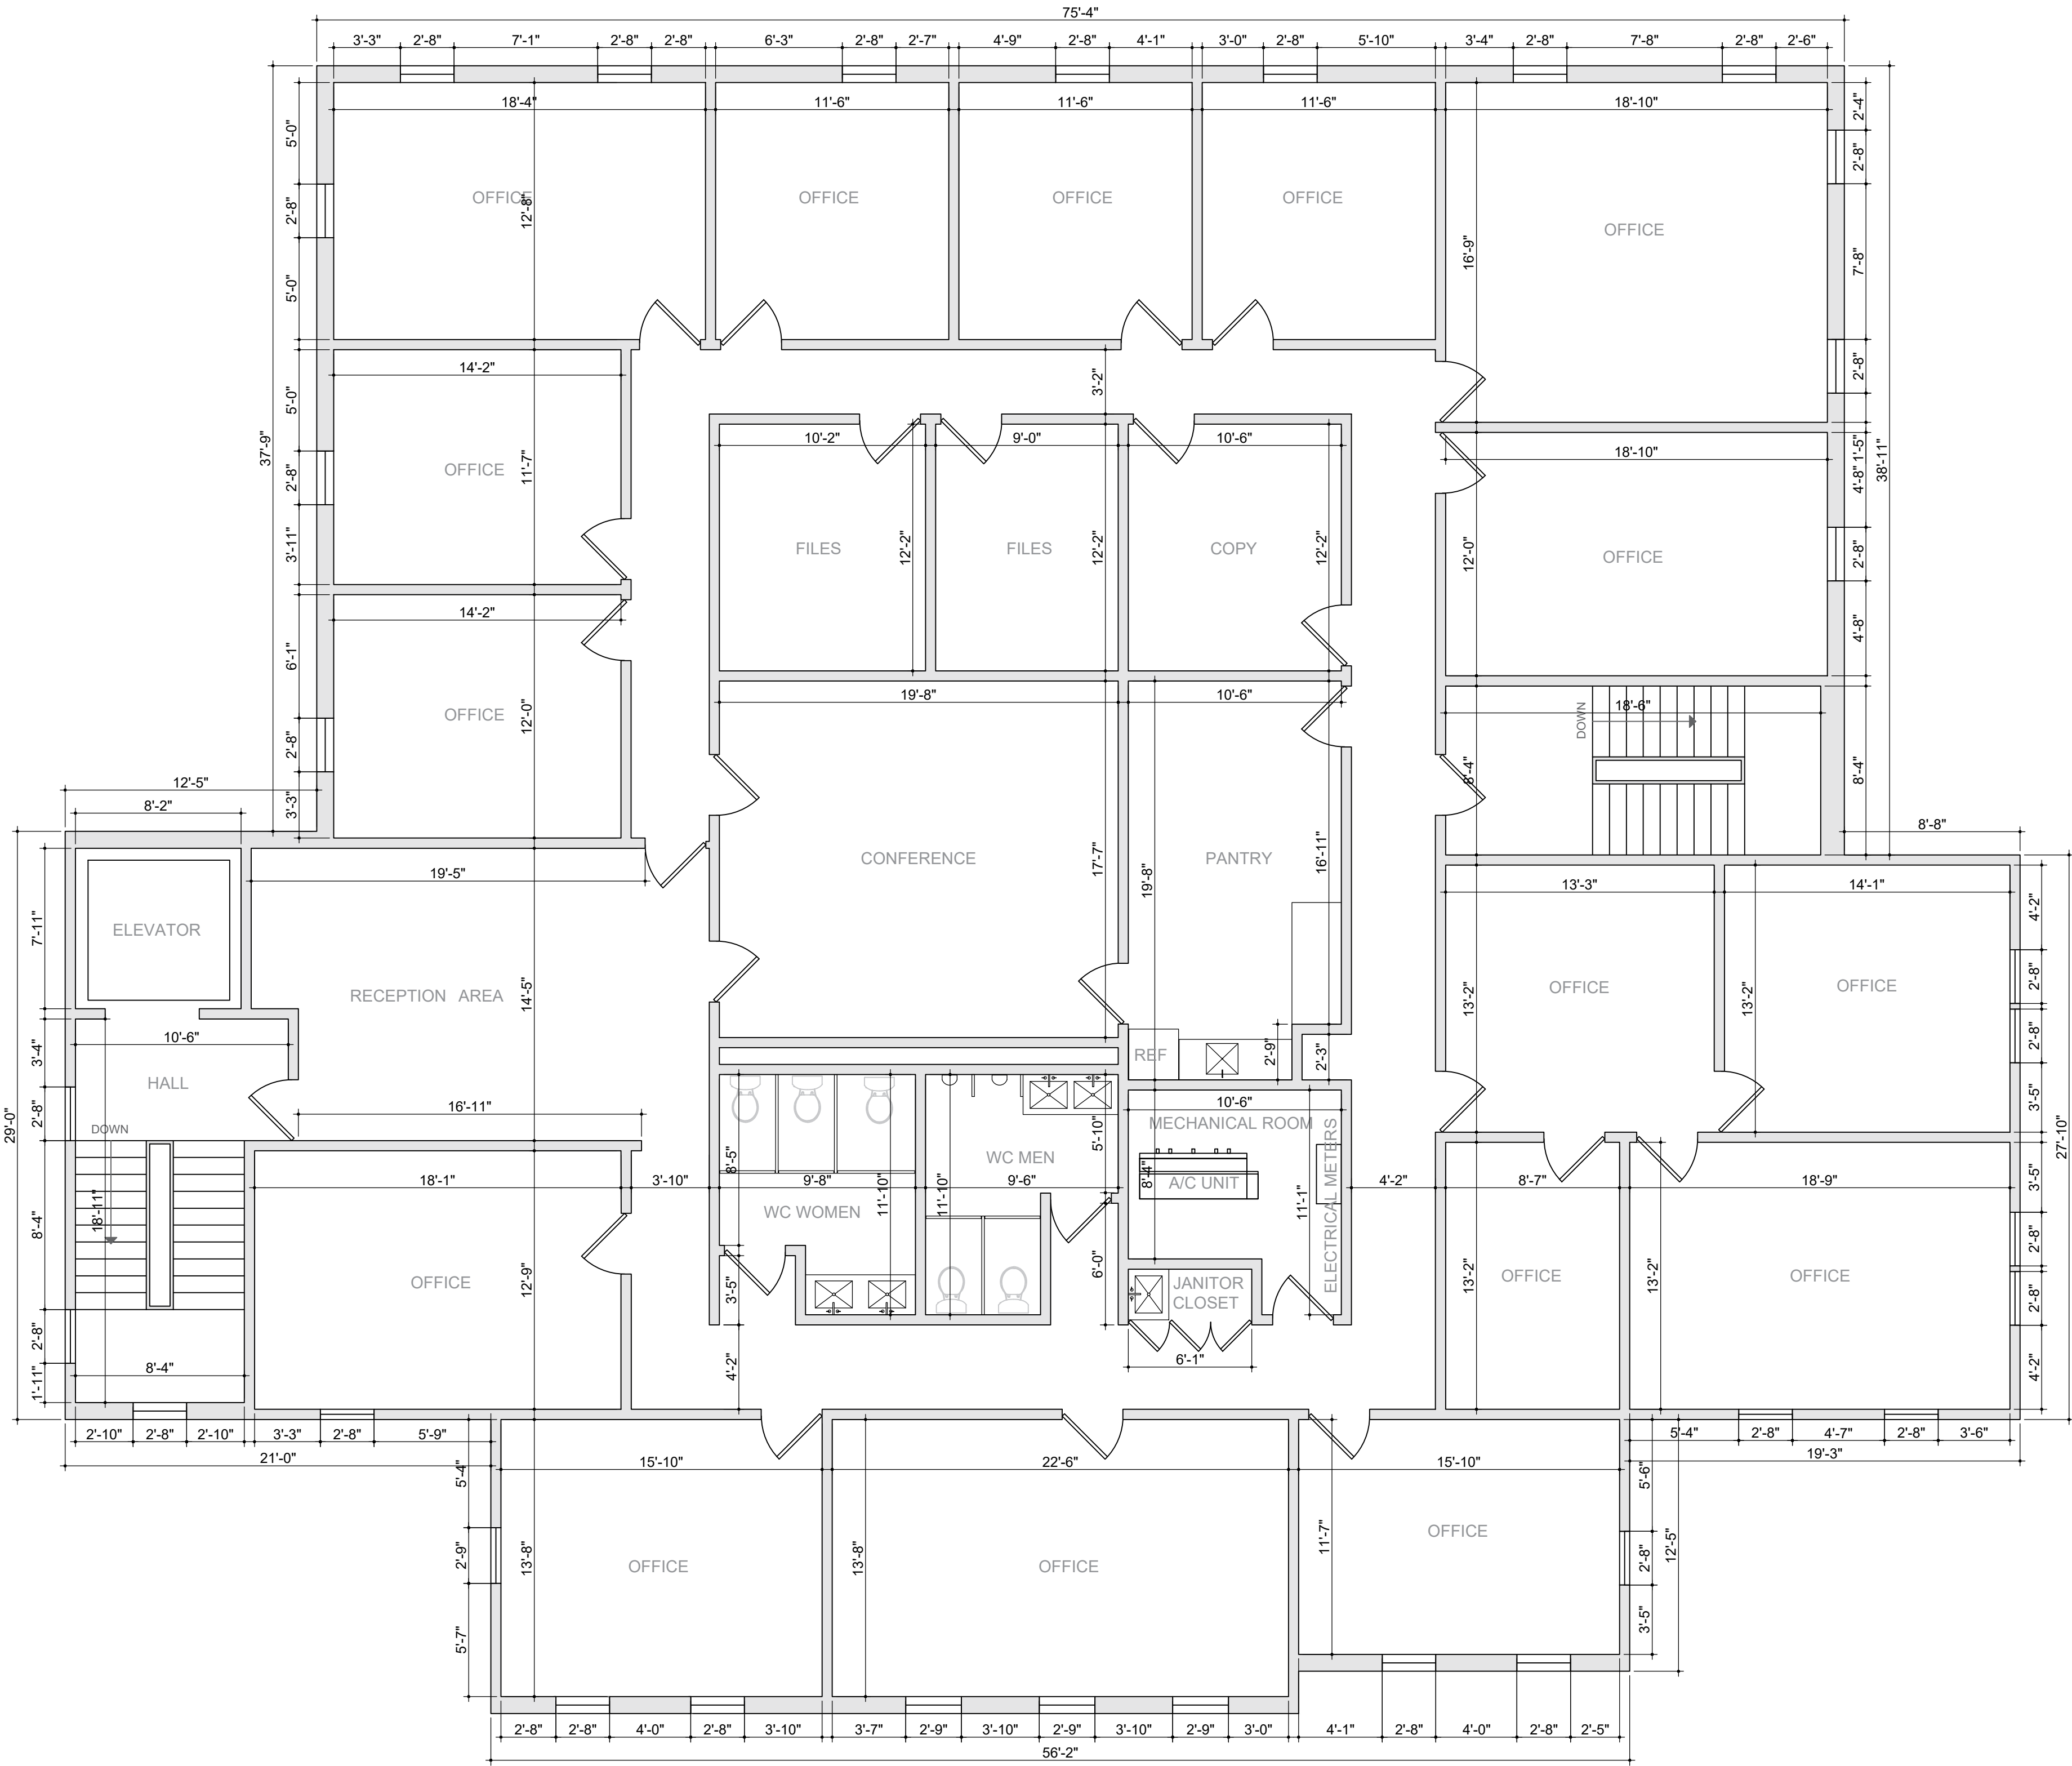


1900 JOHN HANSON LN OXON HILL MD

SECOND FLOOR OFFICE SPACE AS BUILT

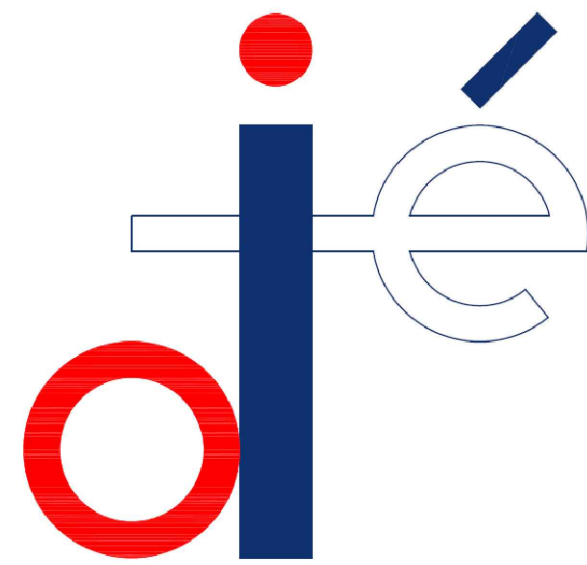

1 AS BUILT 2ND FLOOR PLAN
SCALE 3 / 16 = 1'-0"

THIS DRAWING IS AN INSTRUMENT OF SERVICE, IS THE PROPERTY OF THE DESIGNER AND MAY NOT BE REPRODUCED WITHOUT THE DESIGNER'S PERMISSION AND UNLESS THE REPRODUCTION CARRIES THE DESIGNER'S NAME, ALL DESIGN AND OTHER INFORMATION SHOWN ON THE DRAWING ARE FOR USE ON THE SPECIFIED PROJECT ONLY AND SHALL NOT BE USED OTHERWISE WITHOUT WRITTEN PERMISSION FROM THE DESIGNER.

DESIGNER
JUAN PABLO GARZON
Contact: JUAN PABLO GARZON
Email: juan@ideatelic.net

Keyplan:

1900 JOHN HANSON LANE

Project:

COVER SHEET

Drawing Title:

PERMIT SET

REVISIONS

JPG Project Number: 000.00

Reviewed: JPG

Drawn By:

Scale: AS NOTED

Date: JUNE 05, 2025

001