


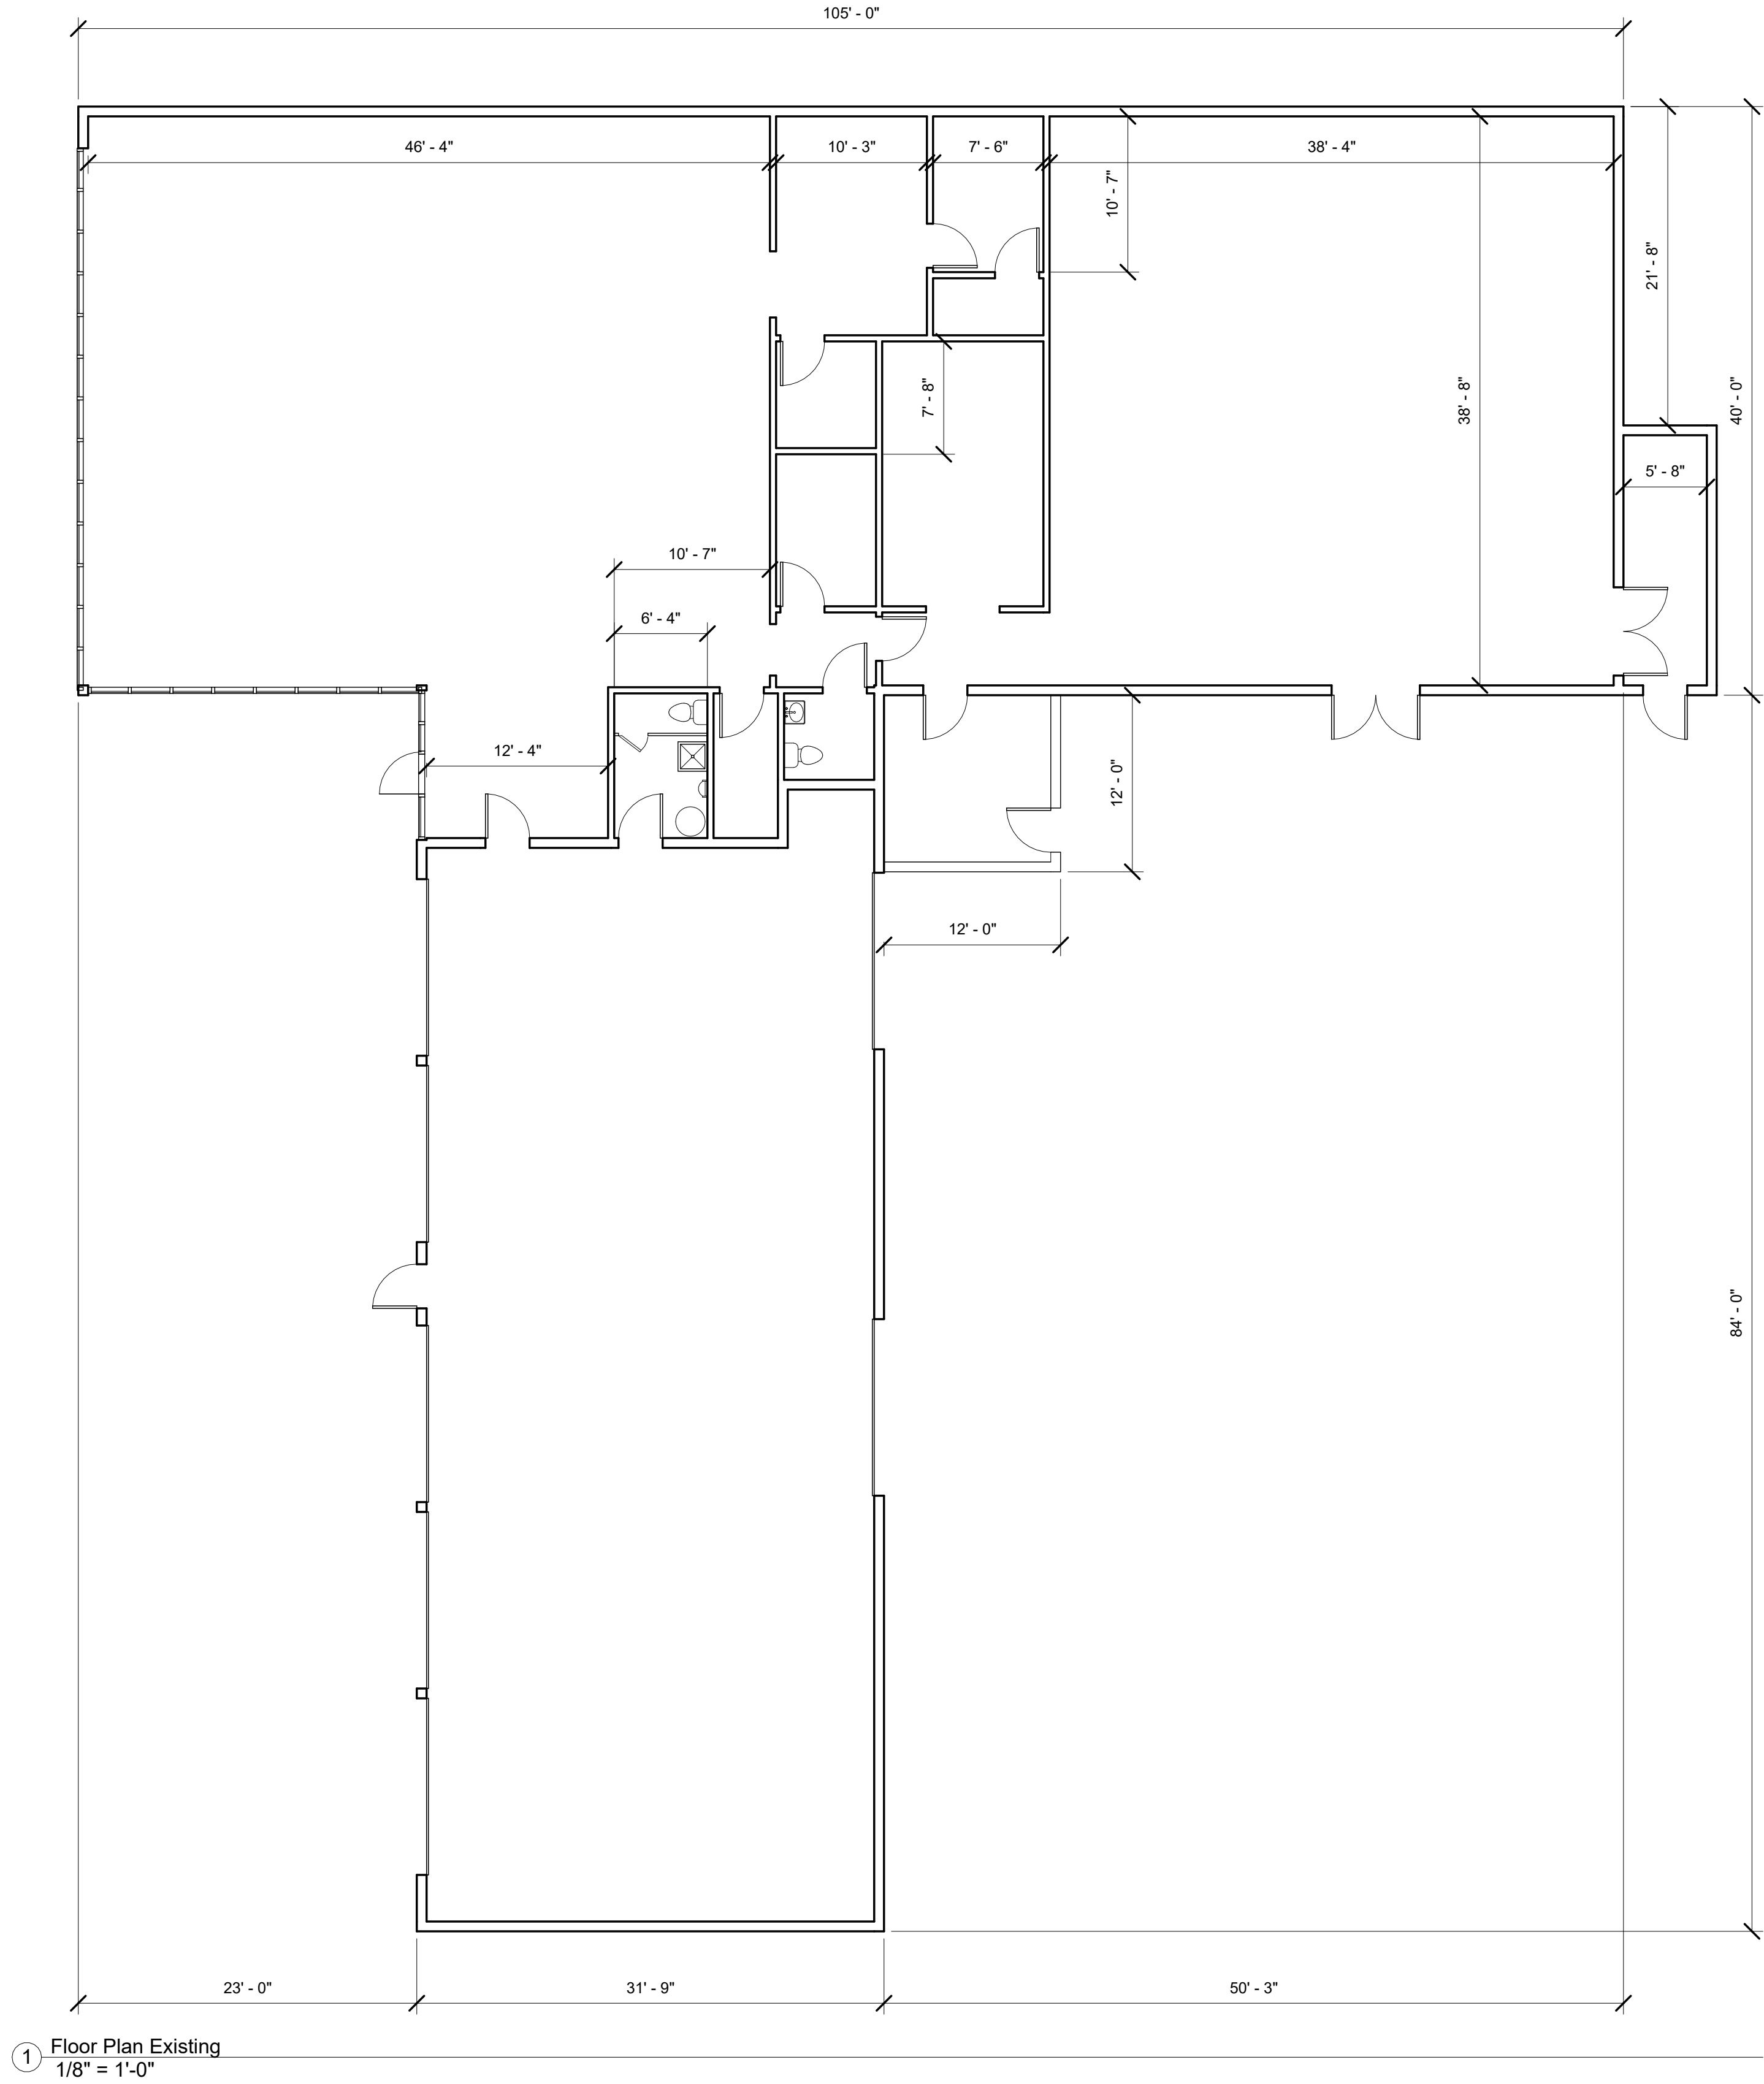

① Floor Plan Existing
1/8" = 1'-0"

FIELD VERIFY ALL DIMENSIONS PRIOR TO ANY CONSTRUCTION



5836 Central Kansas City, Mo 64113
Phone: 816-914-5165 Scharhagarch@gmail.com

Copyright 2023 Herman A. Scharhag Co., Architects
All Rights Reserved. No part of these drawings may be reproduced in any form or by any electronic or mechanical means, without written permission.

AS BUILTS FOR
2021 SWIFT
NORTH KANSAS CITY, MO

J. Jeffrey Schroeder Mo. License A-4226
Herman Scharhag Co., Arch. Cert. of Authority A-22

No.	Description	Date
Revision Schedule		

Floor Plan

Project number	2568
Date	12.20.2023

A101

Scale 1/8" = 1'-0"

12/20/2023 10:32:09 AM