



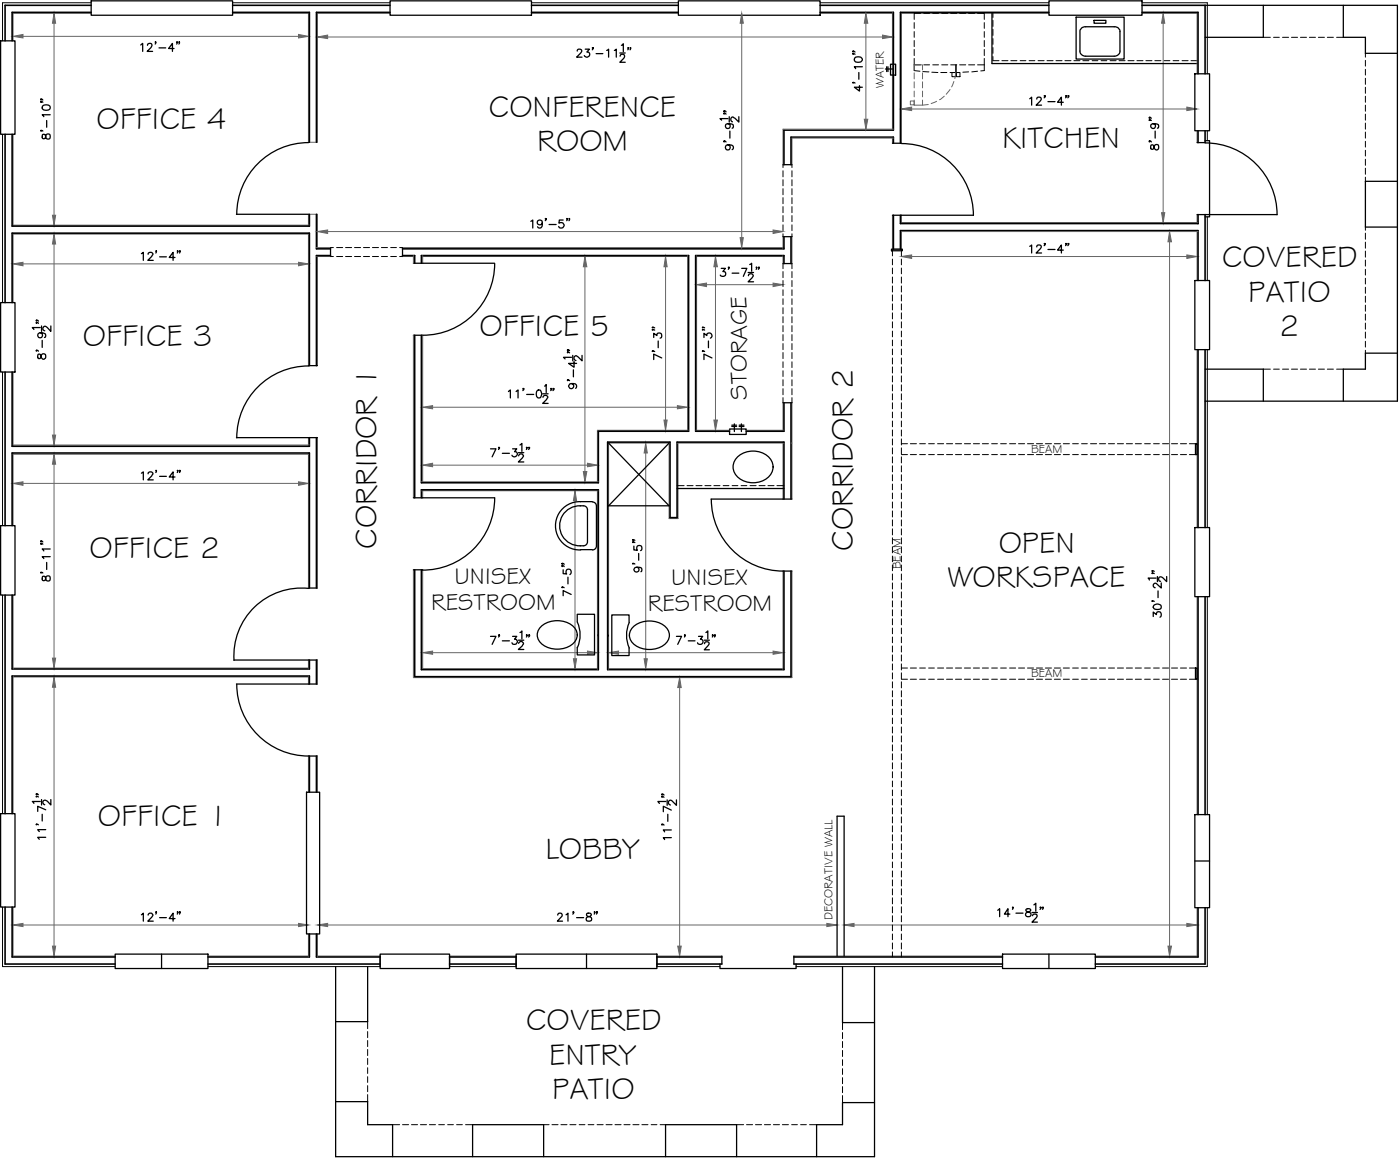

AS-BUILT FLOOR PLAN

SCALE: 1/8" = 1'-0" When Printed on 11X17 Paper

LEASE SPACE - 2017 SQFT
COV. ENTRY PORCH - 178 SQFT
COV. PORCH 2 - 131 SQFT

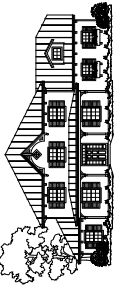

Jeff Overman CPBD
11512 Trinity Hill Drive
Austin, Texas 78753
(512) 472-0975

OvermanCustomDesign.Com

THIS PLAN IS NOT TO BE
REPRODUCED, COPIED,
OR MODIFIED.

CONCEPTUAL DRAWING
ONLY. NOT FOR
CONSTRUCTION.

DATE:
June 22, 2026

Review dates:
6-22-26

JOB NO.:
2606-1487-4211

© 2026 Jeffrey D. Overman
All Rights Reserved

DRWG. NO.:
A.101

JEFFREY D. OVERMAN, CPBD, #TX-452

Center Lake Business Park
Building 200
Dripping Springs, TX

PRELIMINARY - NOT FOR CONSTRUCTION