


EXHIBIT B

SEVENTH AVENUE

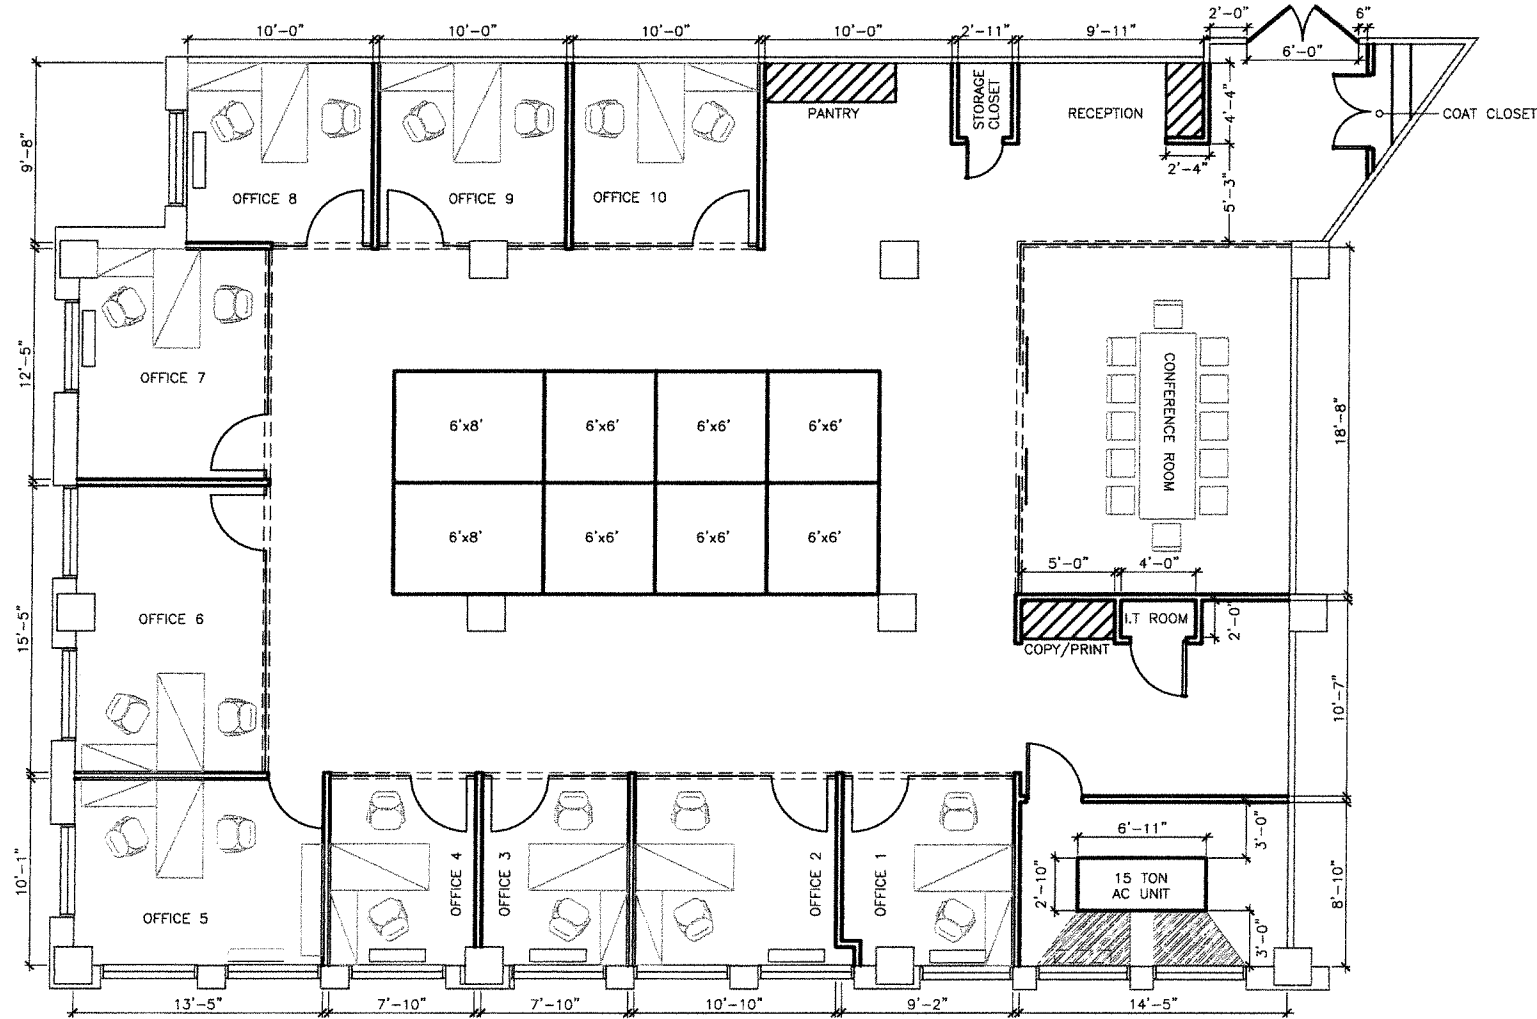

LEGEND

- EXISTING WALL
- NEW MILLWORK
- NEW WALL
- NEW GLASS
- EXISTING RADIATOR
- NEW RADIATOR
- RELOCATED RADIATOR
- REMOVE RADIATOR

NOTE:

DIMENSIONS ON PLAN ARE TO BE VERIFIED IN FIELD

WEST 38TH STREET

Suite 1904

PLAN SCALE: 1/8" = 1'-0"

PHASE 3
design + build

525 7th Avenue
New York, NY 10018
19th Floor



SK-3A