

**WEBB MEDICAL
PLAZA A**

14420 W MEEKER BLVD | SUN CITY WEST, AZ 85375


Floor 02

Suite 202

AS-BUILT

1,704 SF

AVAILABLE

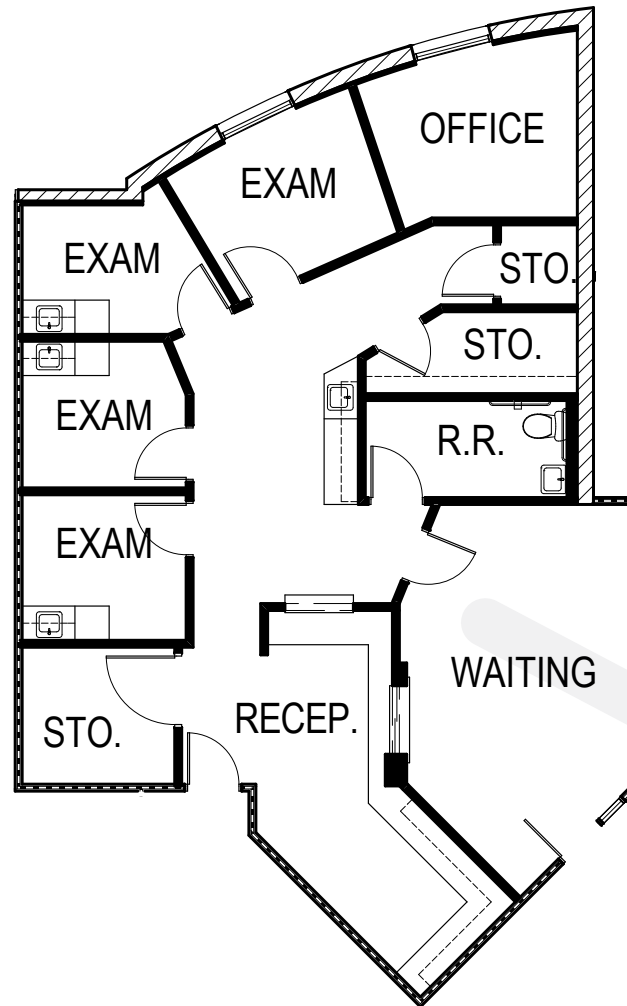

RACHAEL THOMPSON
Senior Vice President
602.513.5122
rachael.thompson@kidder.com

PERRY GABUZZI, CCIM
Senior Vice President
602.513.5116
perry.gabuzzi@kidder.com



km Kidder
Mathews