

GRANITE
VALLEY
MEDICAL
OFFICE

14506 W GRANITE VALLEY DR | SUN CITY WEST, AZ 85375


Floor 1

Suite 102

AS-BUILT

2,703 SF

AVAILABLE

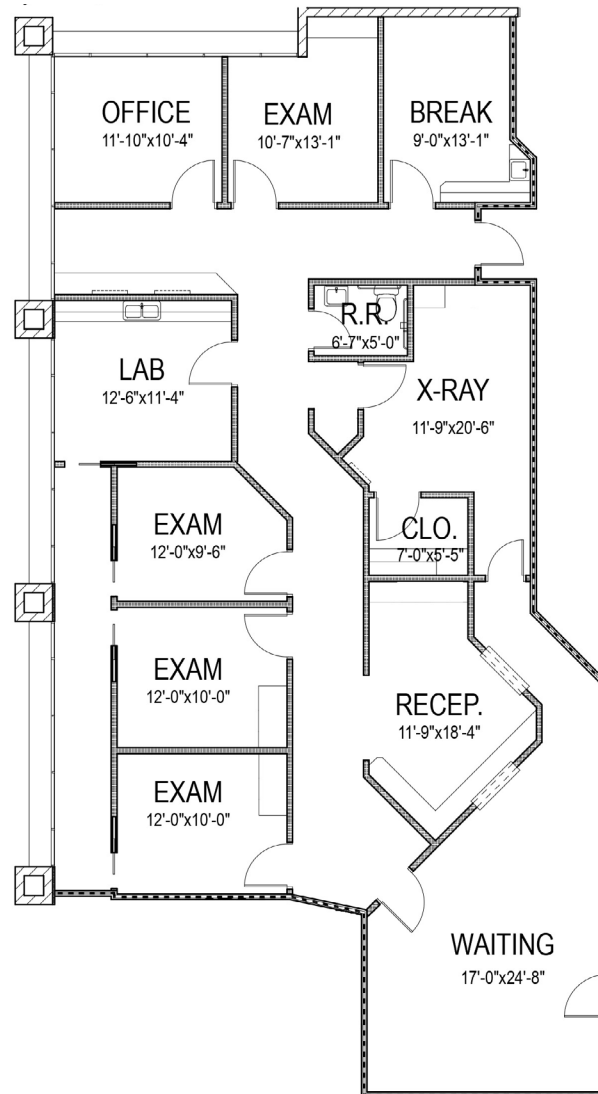

RACHAEL THOMPSON
Senior Vice President
602.513.5122
rachael.thompson@kidder.com

PERRY GABUZZI, CCIM
Senior Vice President
602.513.5116
perry.gabuzzi@kidder.com



km Kidder
Mathews