
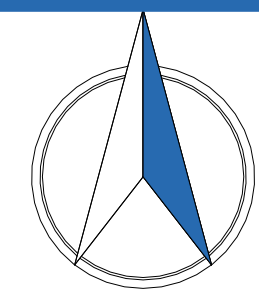



Property Key

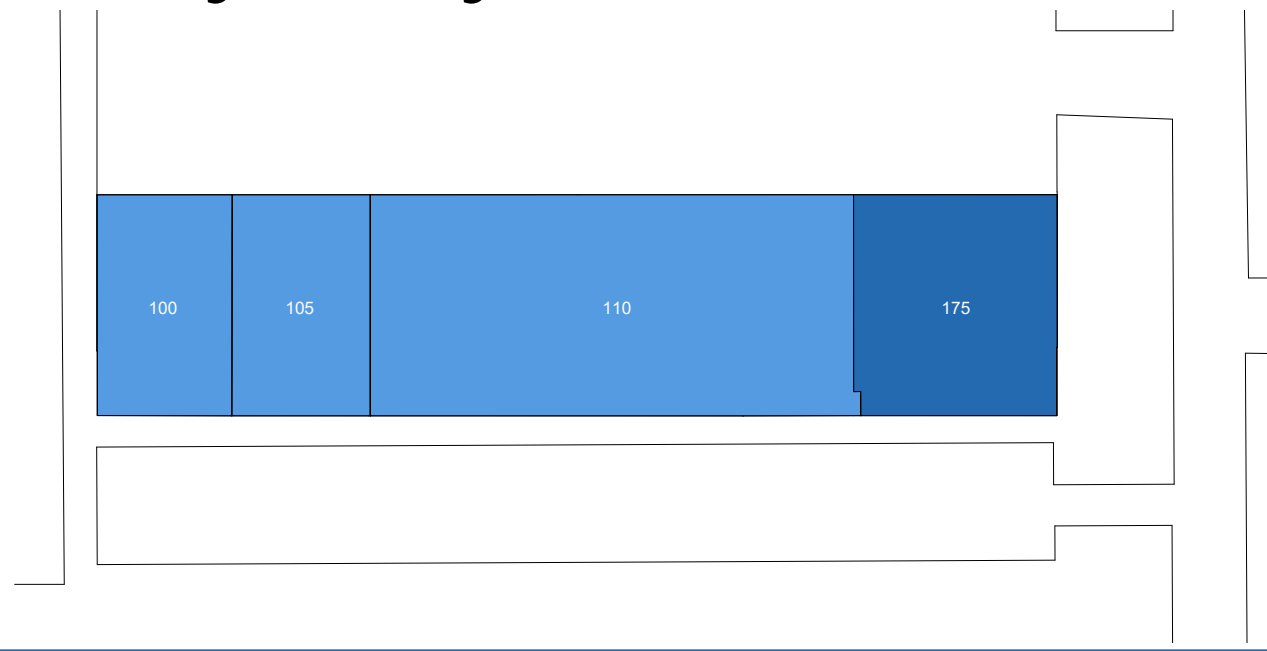

Lakefront As Built Marketing Package

8150 Chancellor Dr, Orlando, FL 32809, US

Building: 8150
Suite: 175
Sheet **E1**

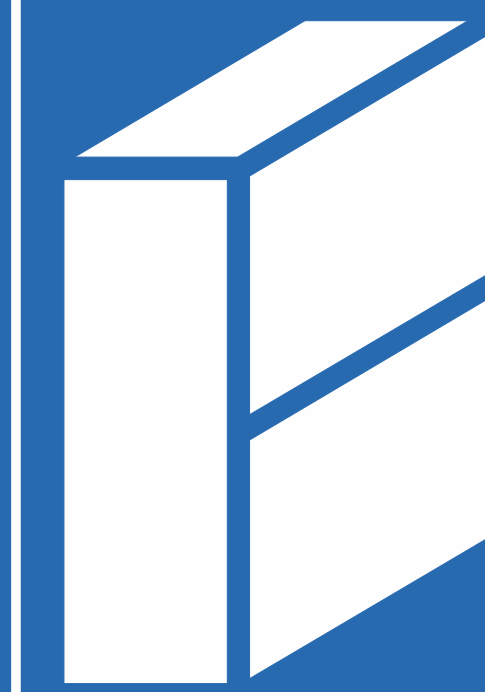

BAY SPACE


Scale: Not to Scale
Sheet Size: 42" x 30"
Not For Construction

Usable Square Foot Analysis

Office Area	12,468	100 %
Warehouse Area	0	0%
Total Area	12,468	

Building Information

Deck Height:	21' - 3 1/2"
Clear Height:	16' - 5"
Ceiling Height:	11' - 9"
Sprinklered:	<input checked="" type="checkbox"/> Yes <input type="checkbox"/> No
Mechanical Area:	212 SQFT

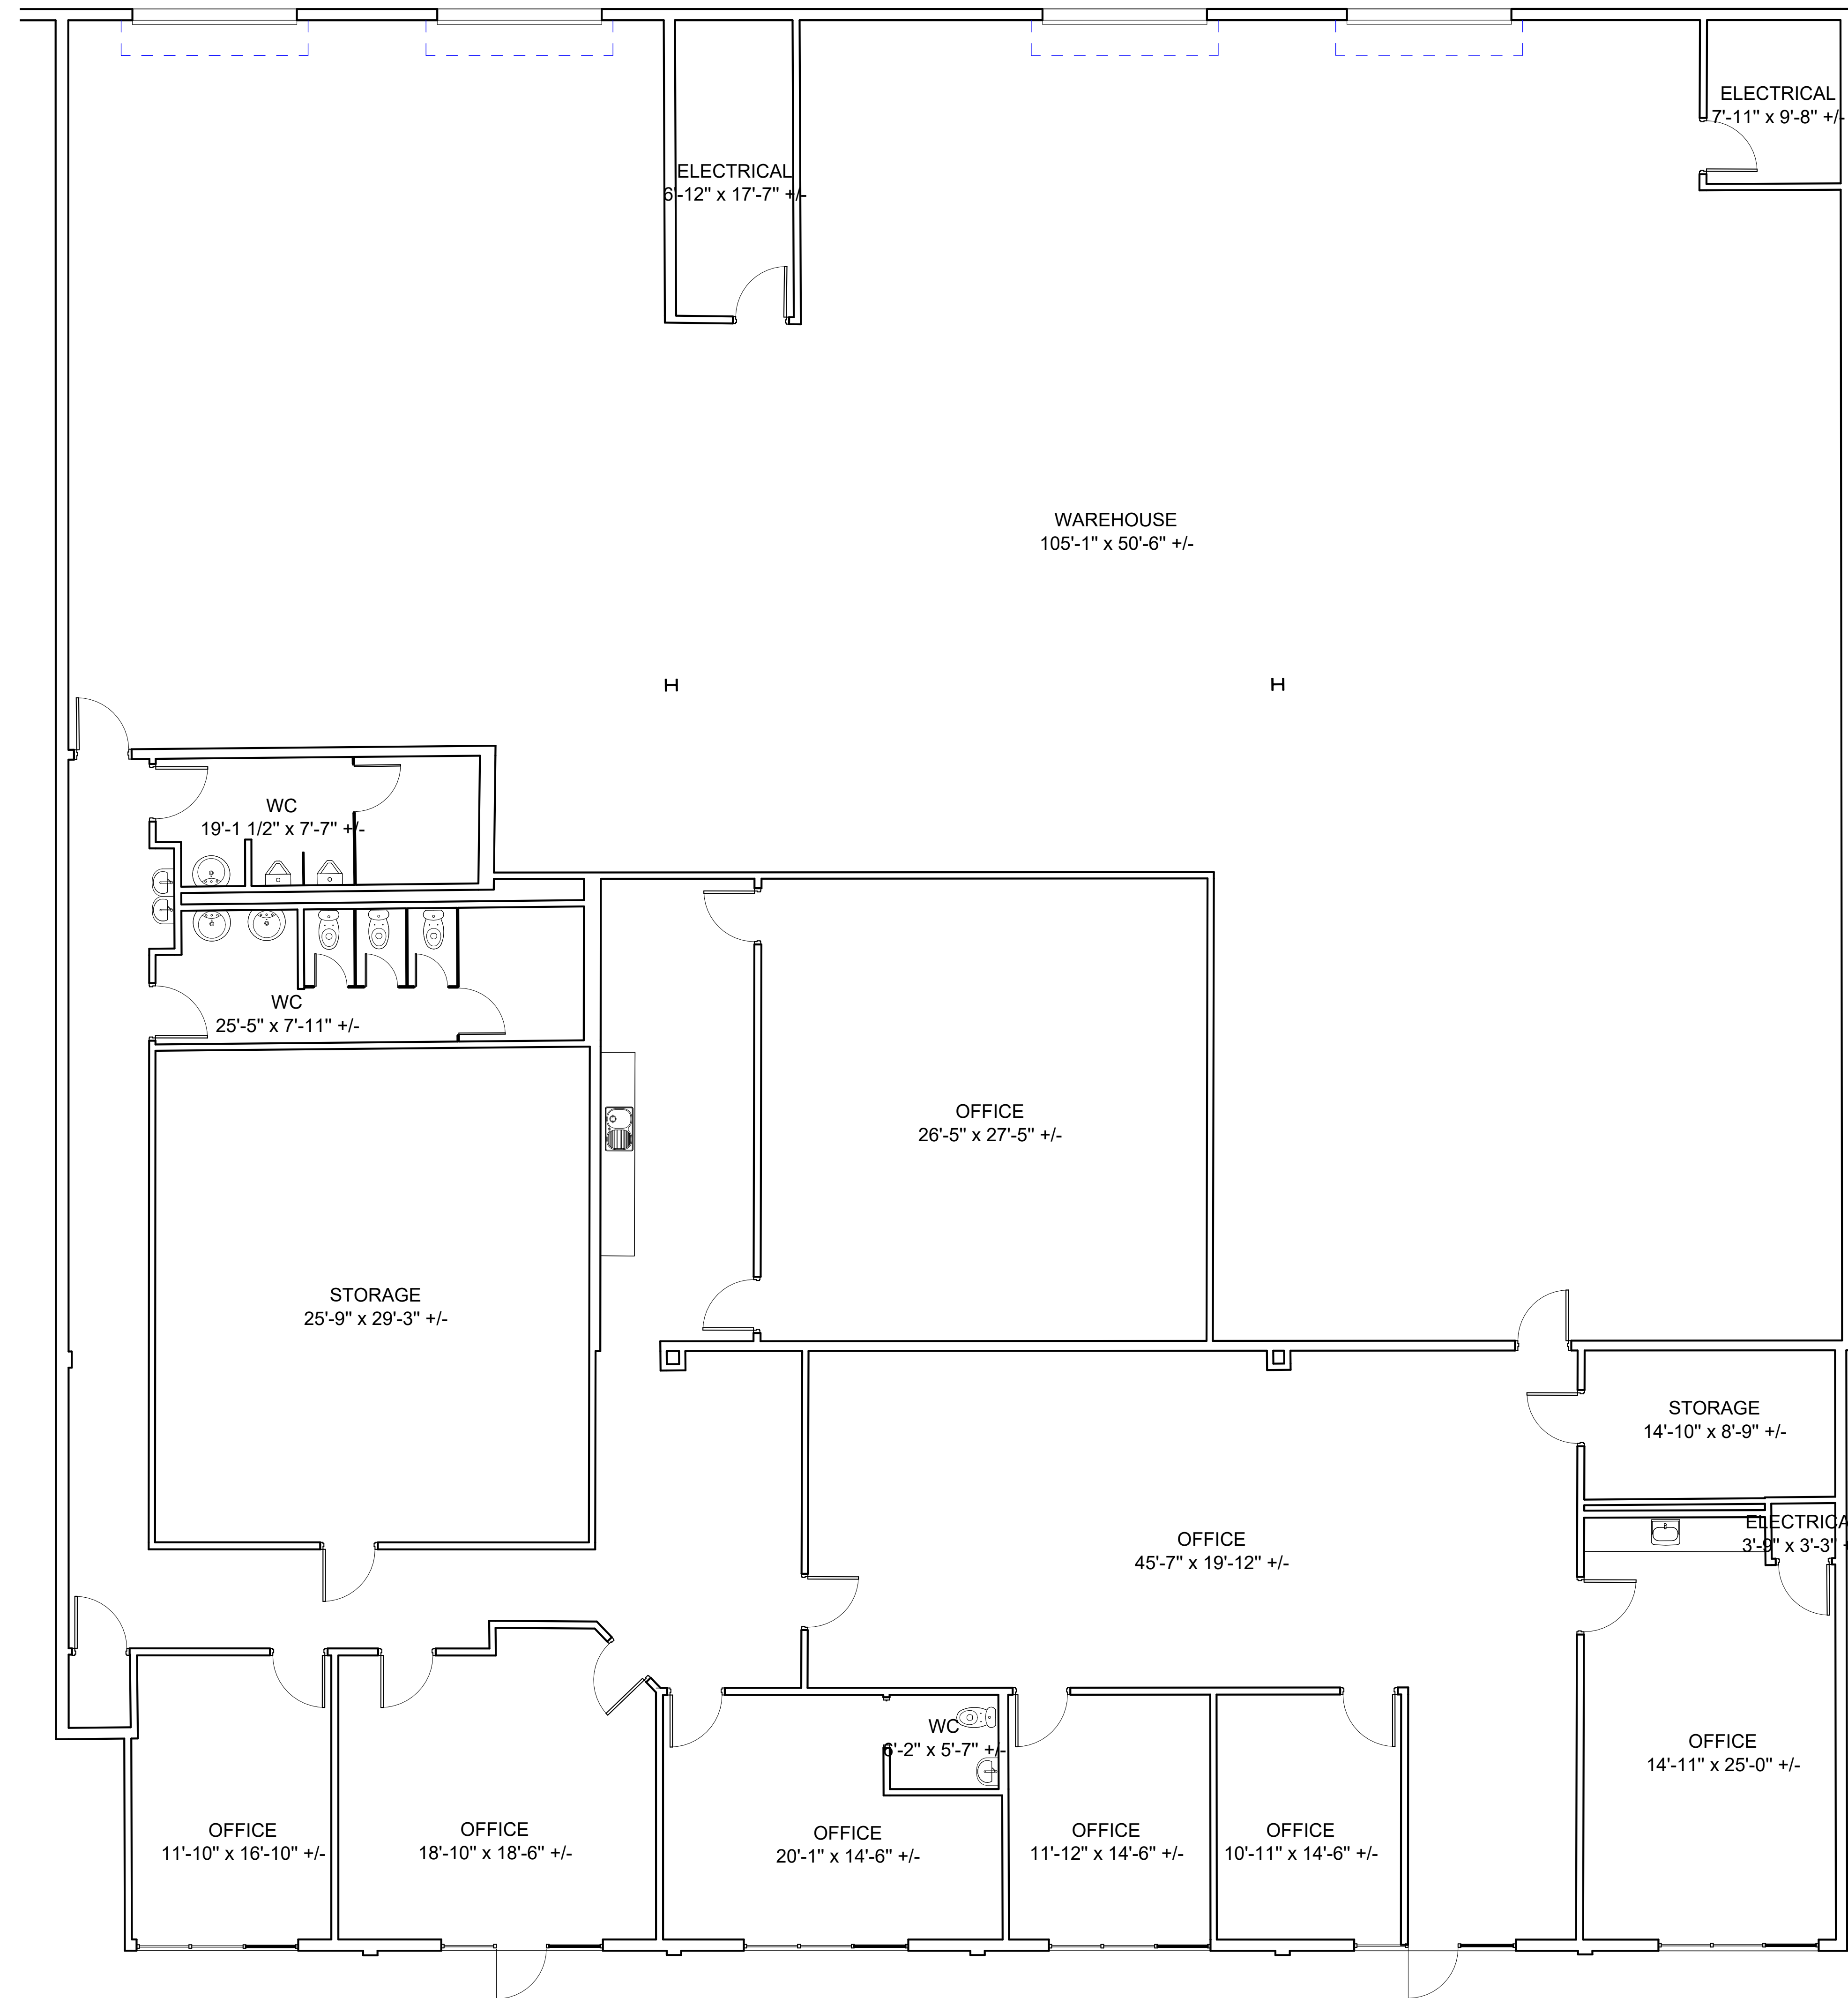

① 175
3/16" = 1'-0"

As Built Floor Plan for Marketing

