



Y:\Sandakris\_2621 Van Buren Ave - Marketing Requests 2026\_2026-0084\Drawings\2621 Van Buren00\_Suite 200 EC\_Marketing Plan\_2026-0084.dwg

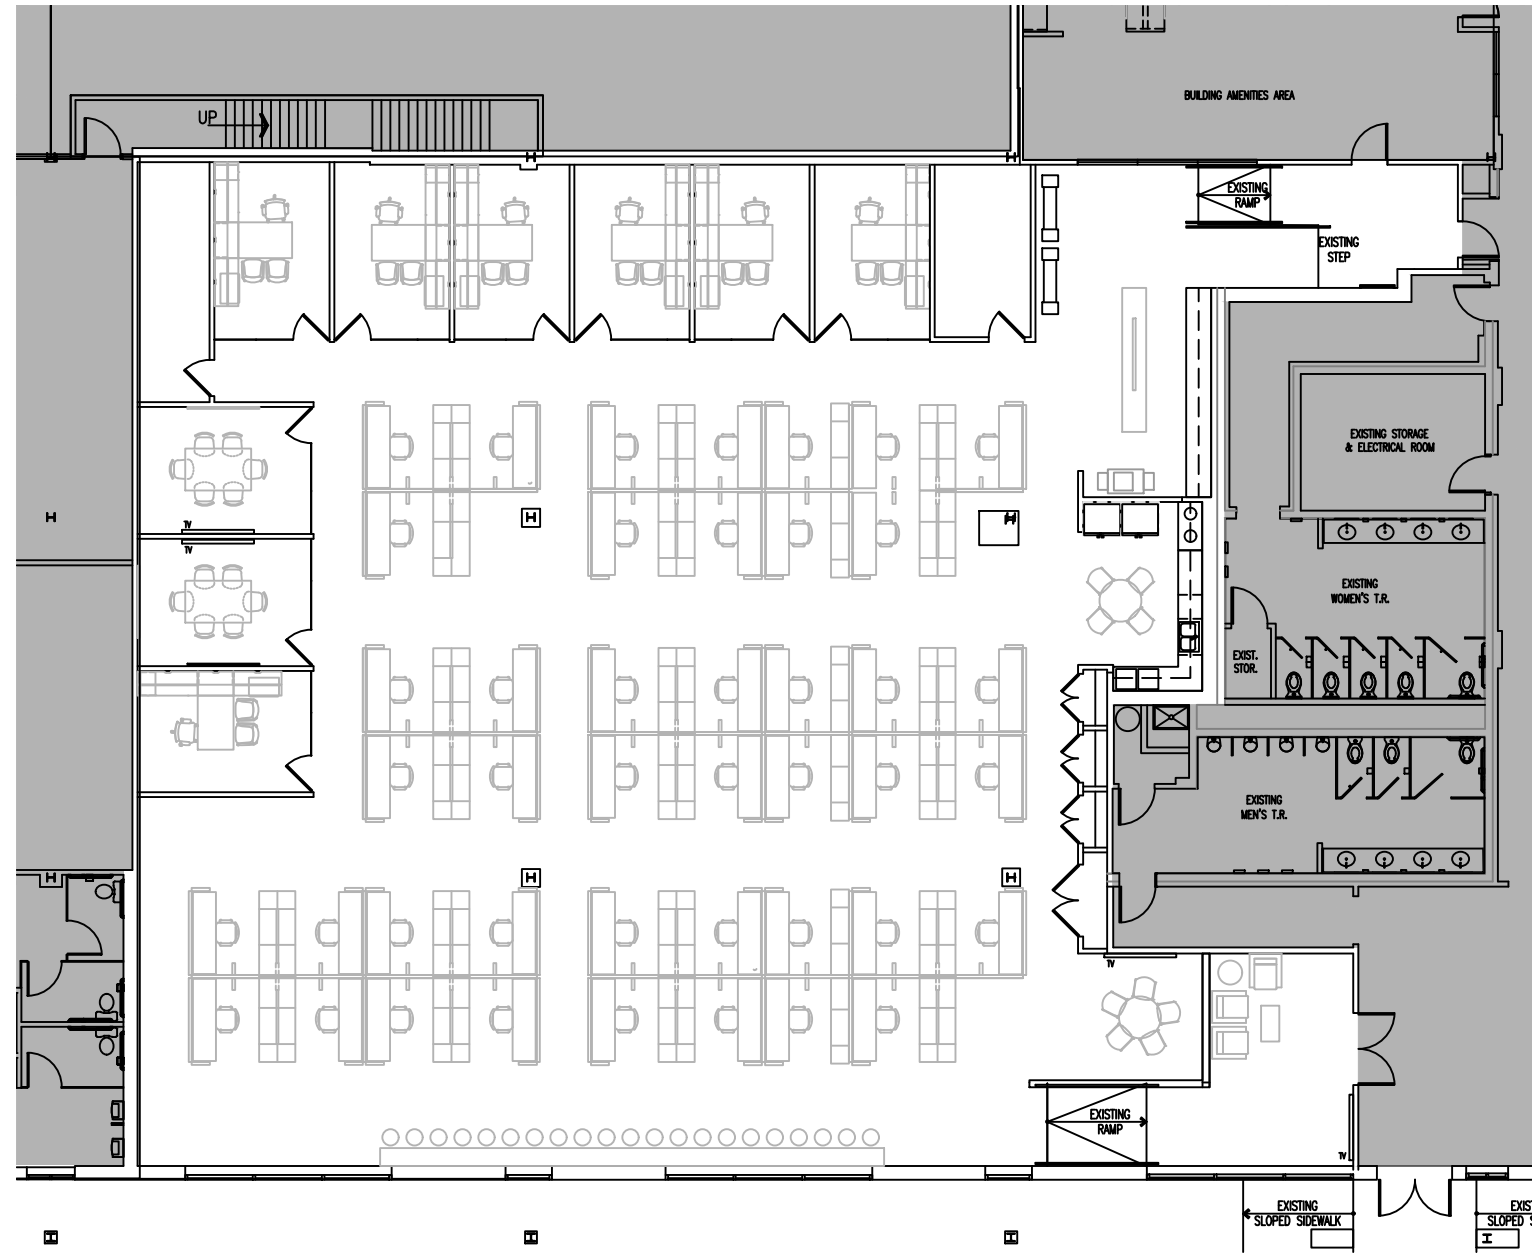

### FLOOR PLAN

SCALE: 1/16" = 1'-0"

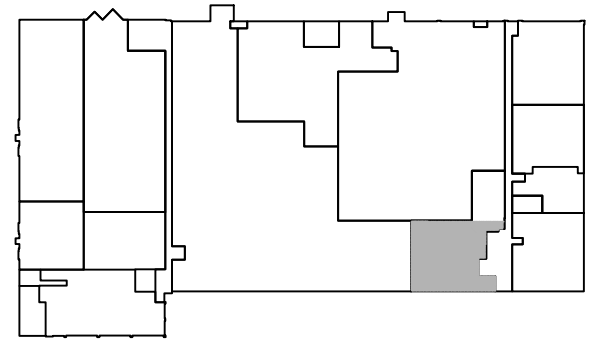

### KEY PLAN - GROUND FLOOR

NOT TO SCALE

EXISTING CONDITIONS FOR:  
**SUITE 200**  
2621 VAN BUREN AVE.  
NORRISTOWN, PA

**RHJ ASSOCIATES, PC**  
ARCHITECTS · PLANNERS · DESIGNERS

PAOLI, PA 610.337.4555	MOUNT LAUREL, NJ 856.252.0040	PHILADELPHIA, PA 215.279.5845	WILMINGTON, DE 302.482.2269	YORK, PA 717.845.3644
<a href="http://www.rhjassoc.com">www.rhjassoc.com</a>				

DATE	03.11.26
PROJECT NO.	2026-0084