
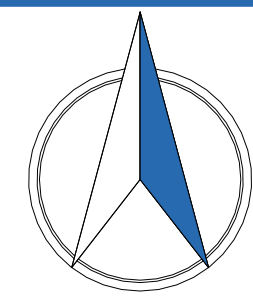


Property Key

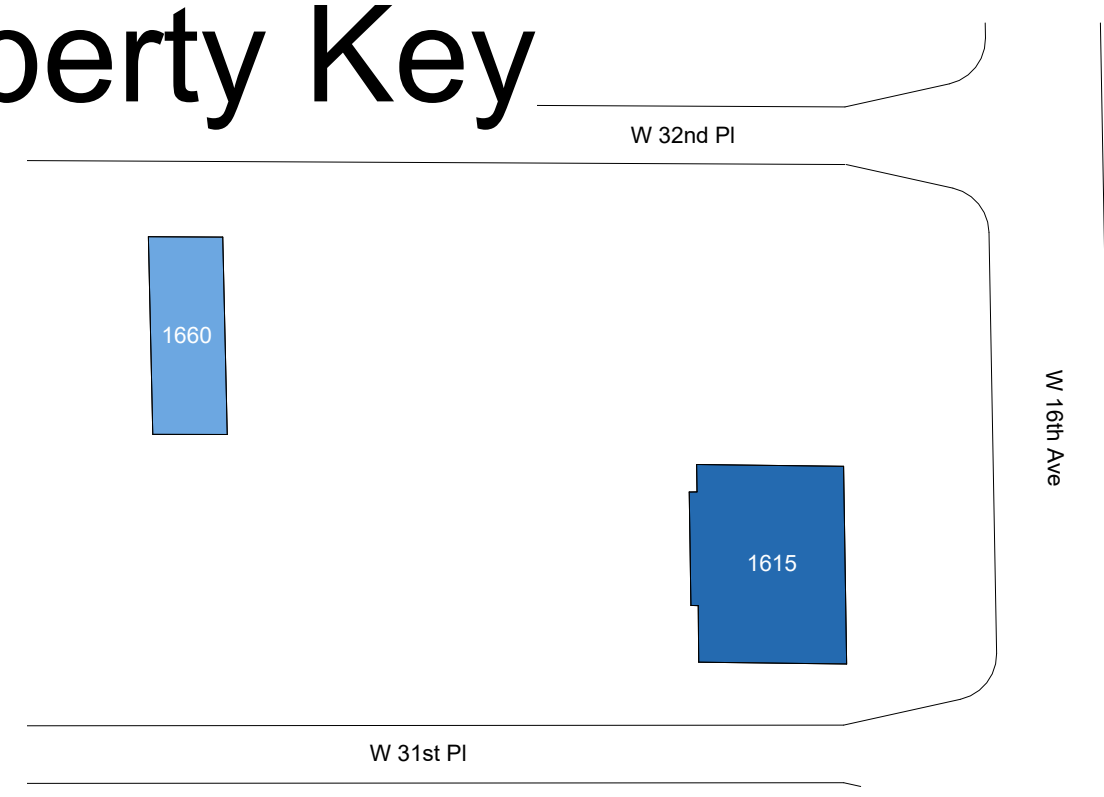


Hialeah Buildings

1615 W 31st St, Hialeah, FL 33012

Building: 5

Suite: 1615

Sheet **E1**

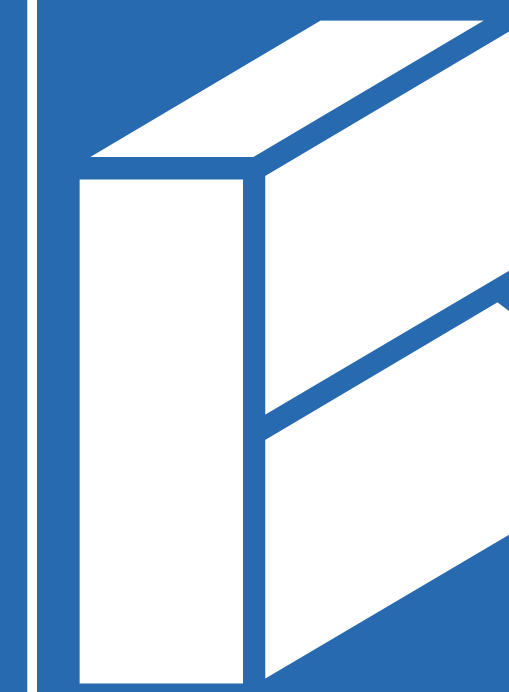

BAY SPACE


Scale: Not to Scale
Sheet Size: 42" x 30"
Not For Construction

Usable Square Foot Analysis

	SQFT	BUILDING PERCENTAGE
Office Area	0	0 %
Warehouse Area	8000	100 %
Total Area	8,000	

Building Information

Deck Height:	17' - 5 1/4"
Clear Height:	14' - 2"
Ceiling Height:	7' - 10 1/4"
Sprinklered:	<input type="checkbox"/> Yes <input checked="" type="checkbox"/> No
Mechanical Area:	0 SQFT

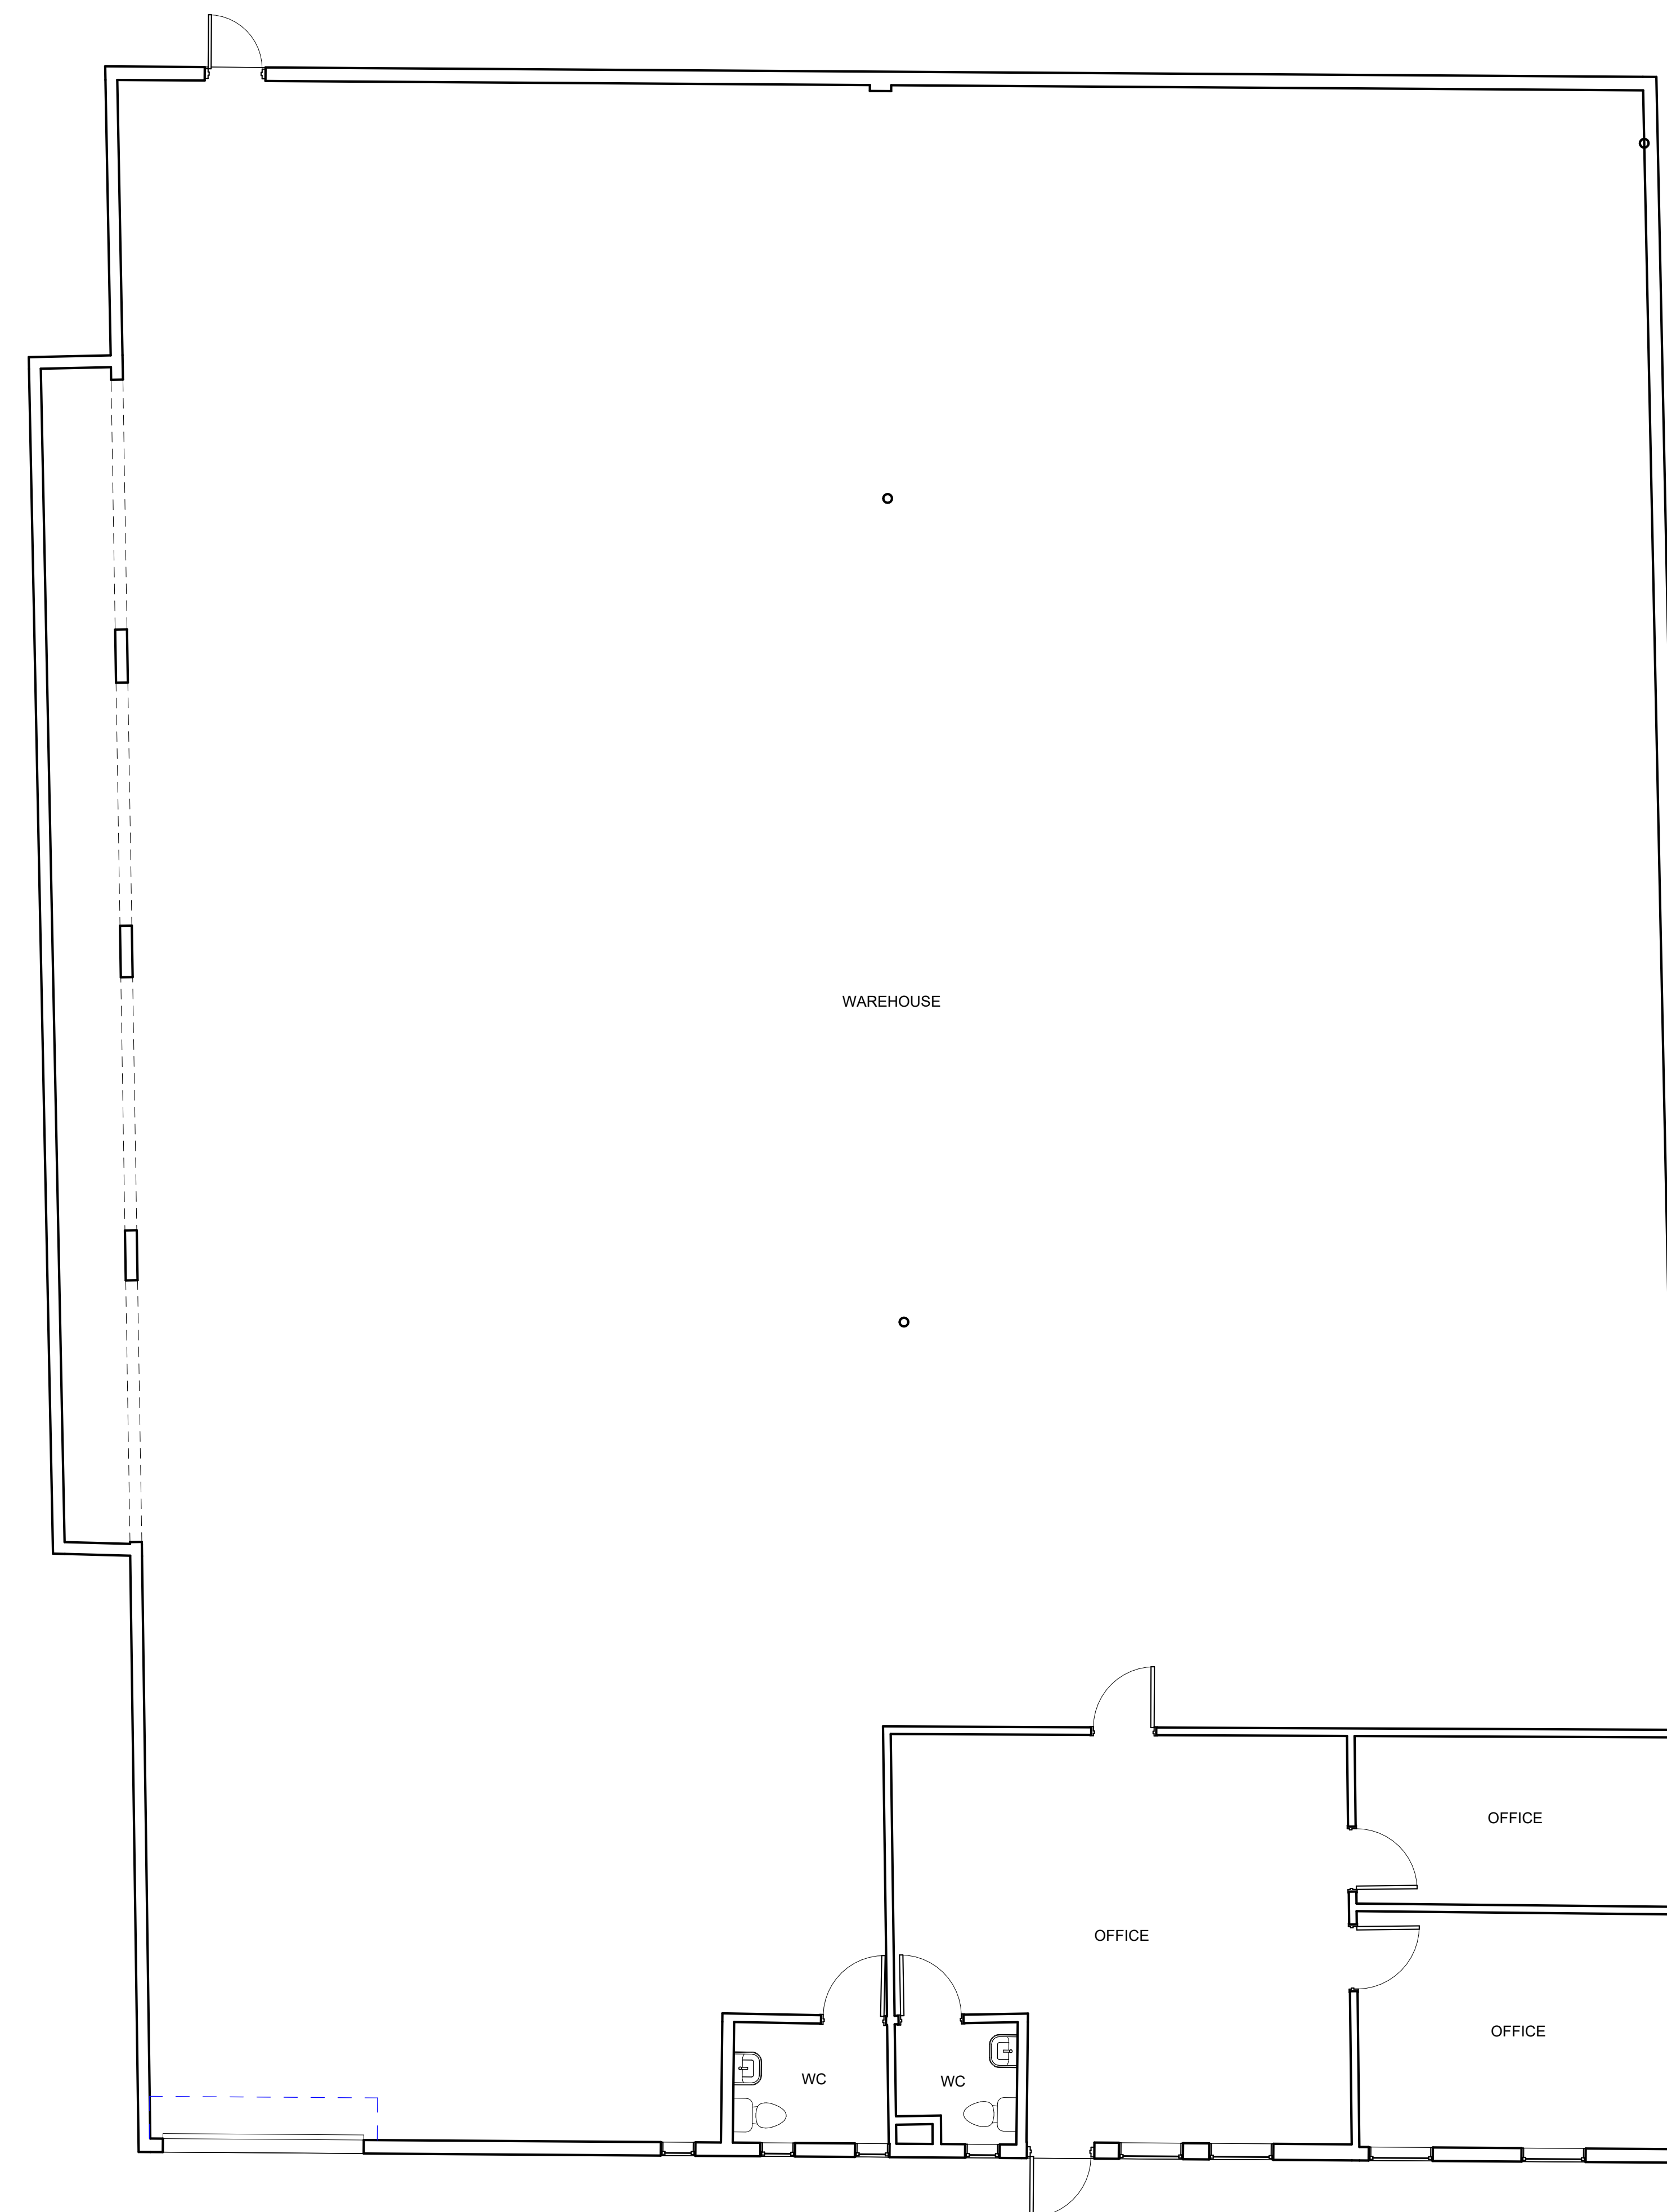

② 1615
3/16" = 1'-0"

As Built Floor Plan for Marketing

