



Property Key

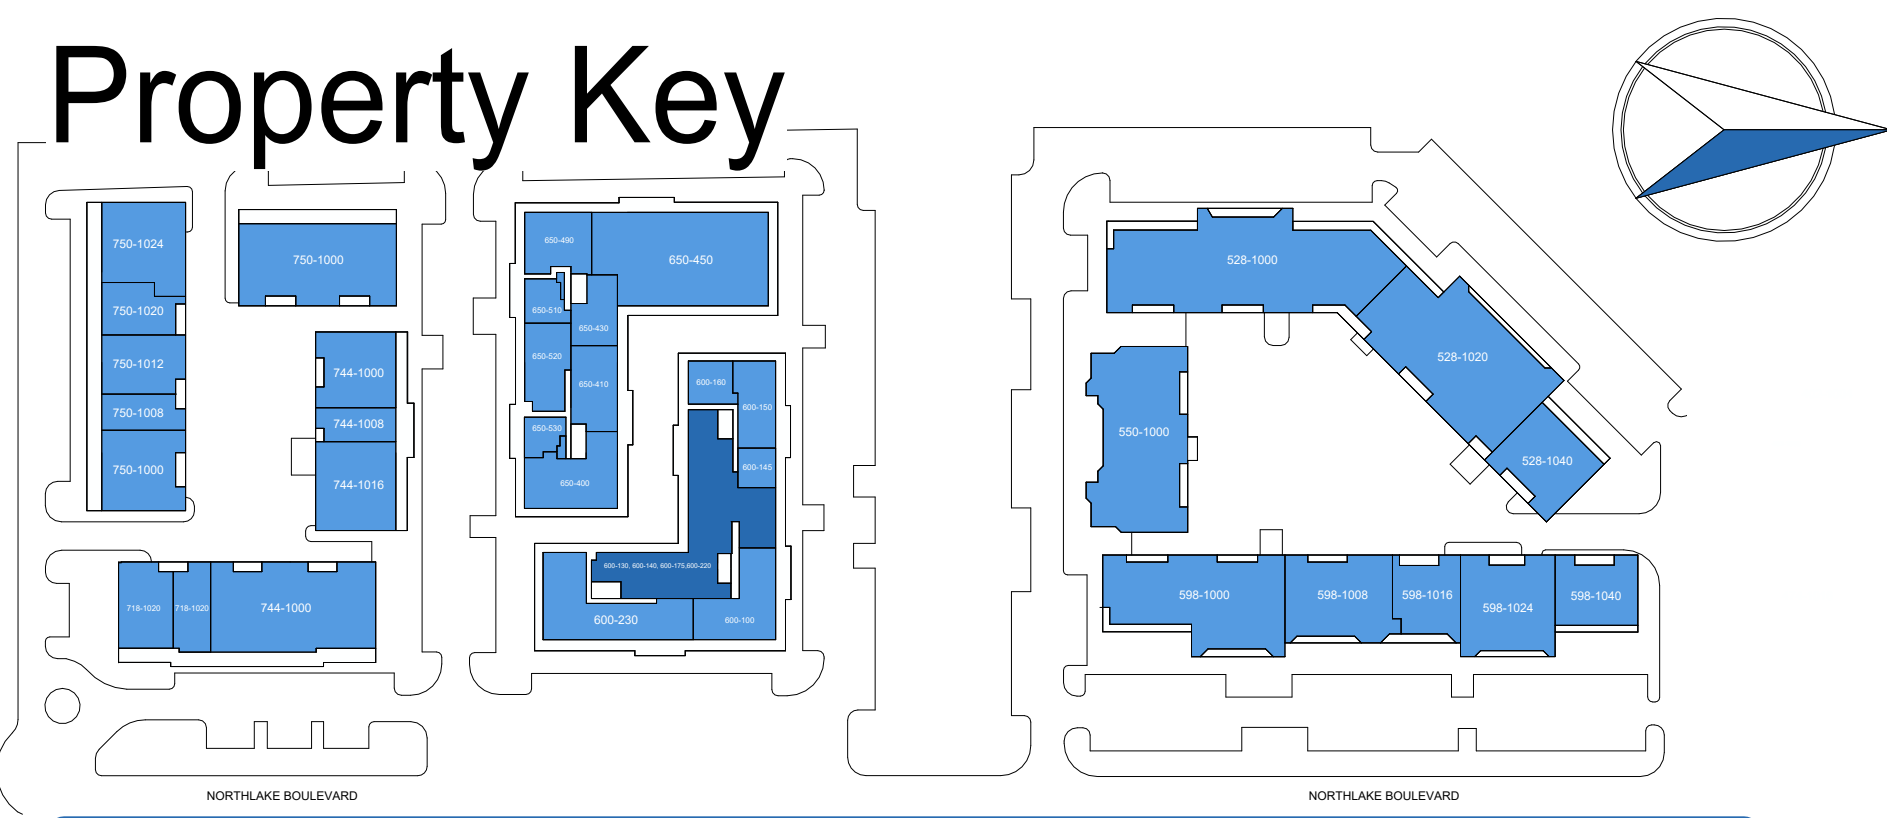

Belle, Winter Springs As Built Marketing Package

600 Northlake Blvd, Alt Springs, FL 32701, US

Building: 600
Suite: 130, 140, 175, 220
Sheet **E1**

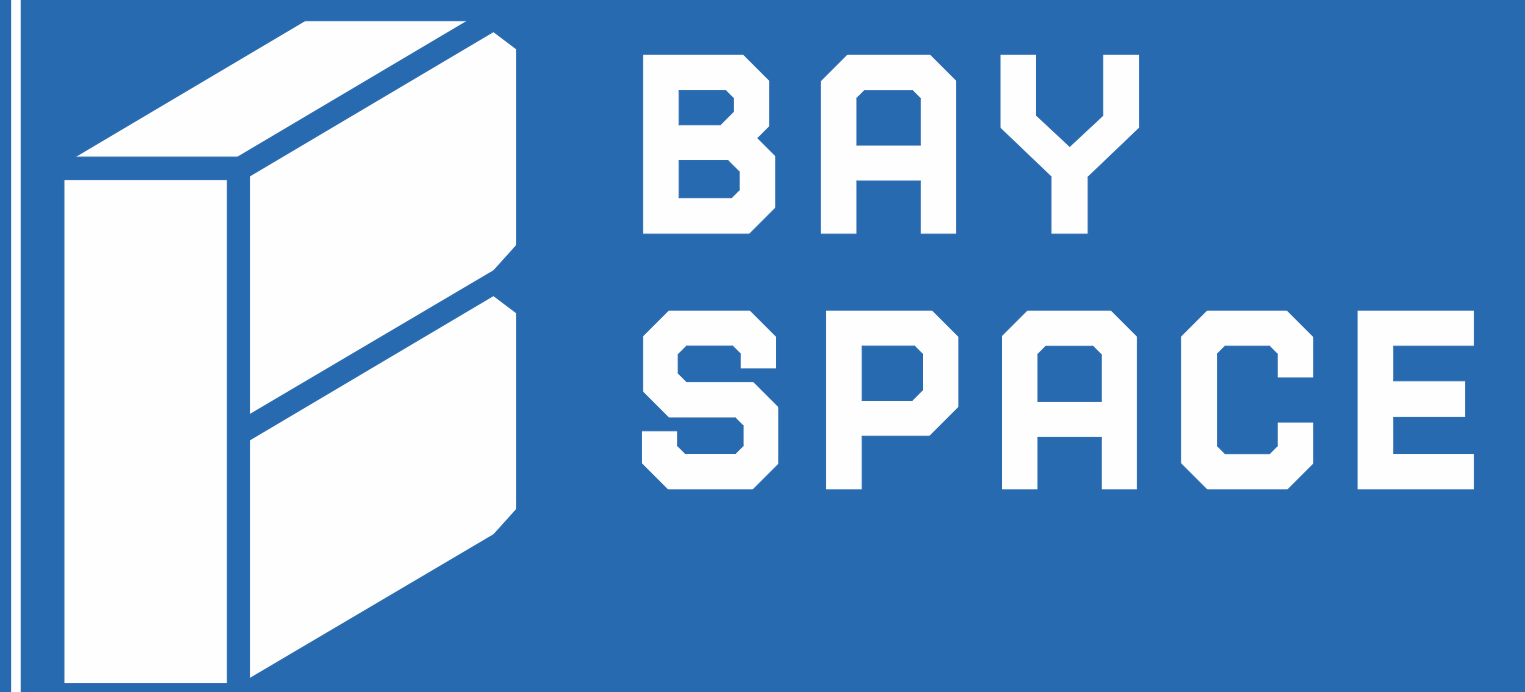


Scale: Not to Scale
Sheet Size: 42" x 30"
Not For Construction

Usable Square Foot Analysis

Office Area	6,666	89%
Warehouse Area	847	11%
Total Area	7,513	

Building Information

Deck Height:	N/A	
Clear Height:	7' - 11 1/2"	
Ceiling Height:	8' - 5 1/2"	
Sprinklered:	<input checked="" type="checkbox"/> Yes	<input type="checkbox"/> No
Mechanical Area:		

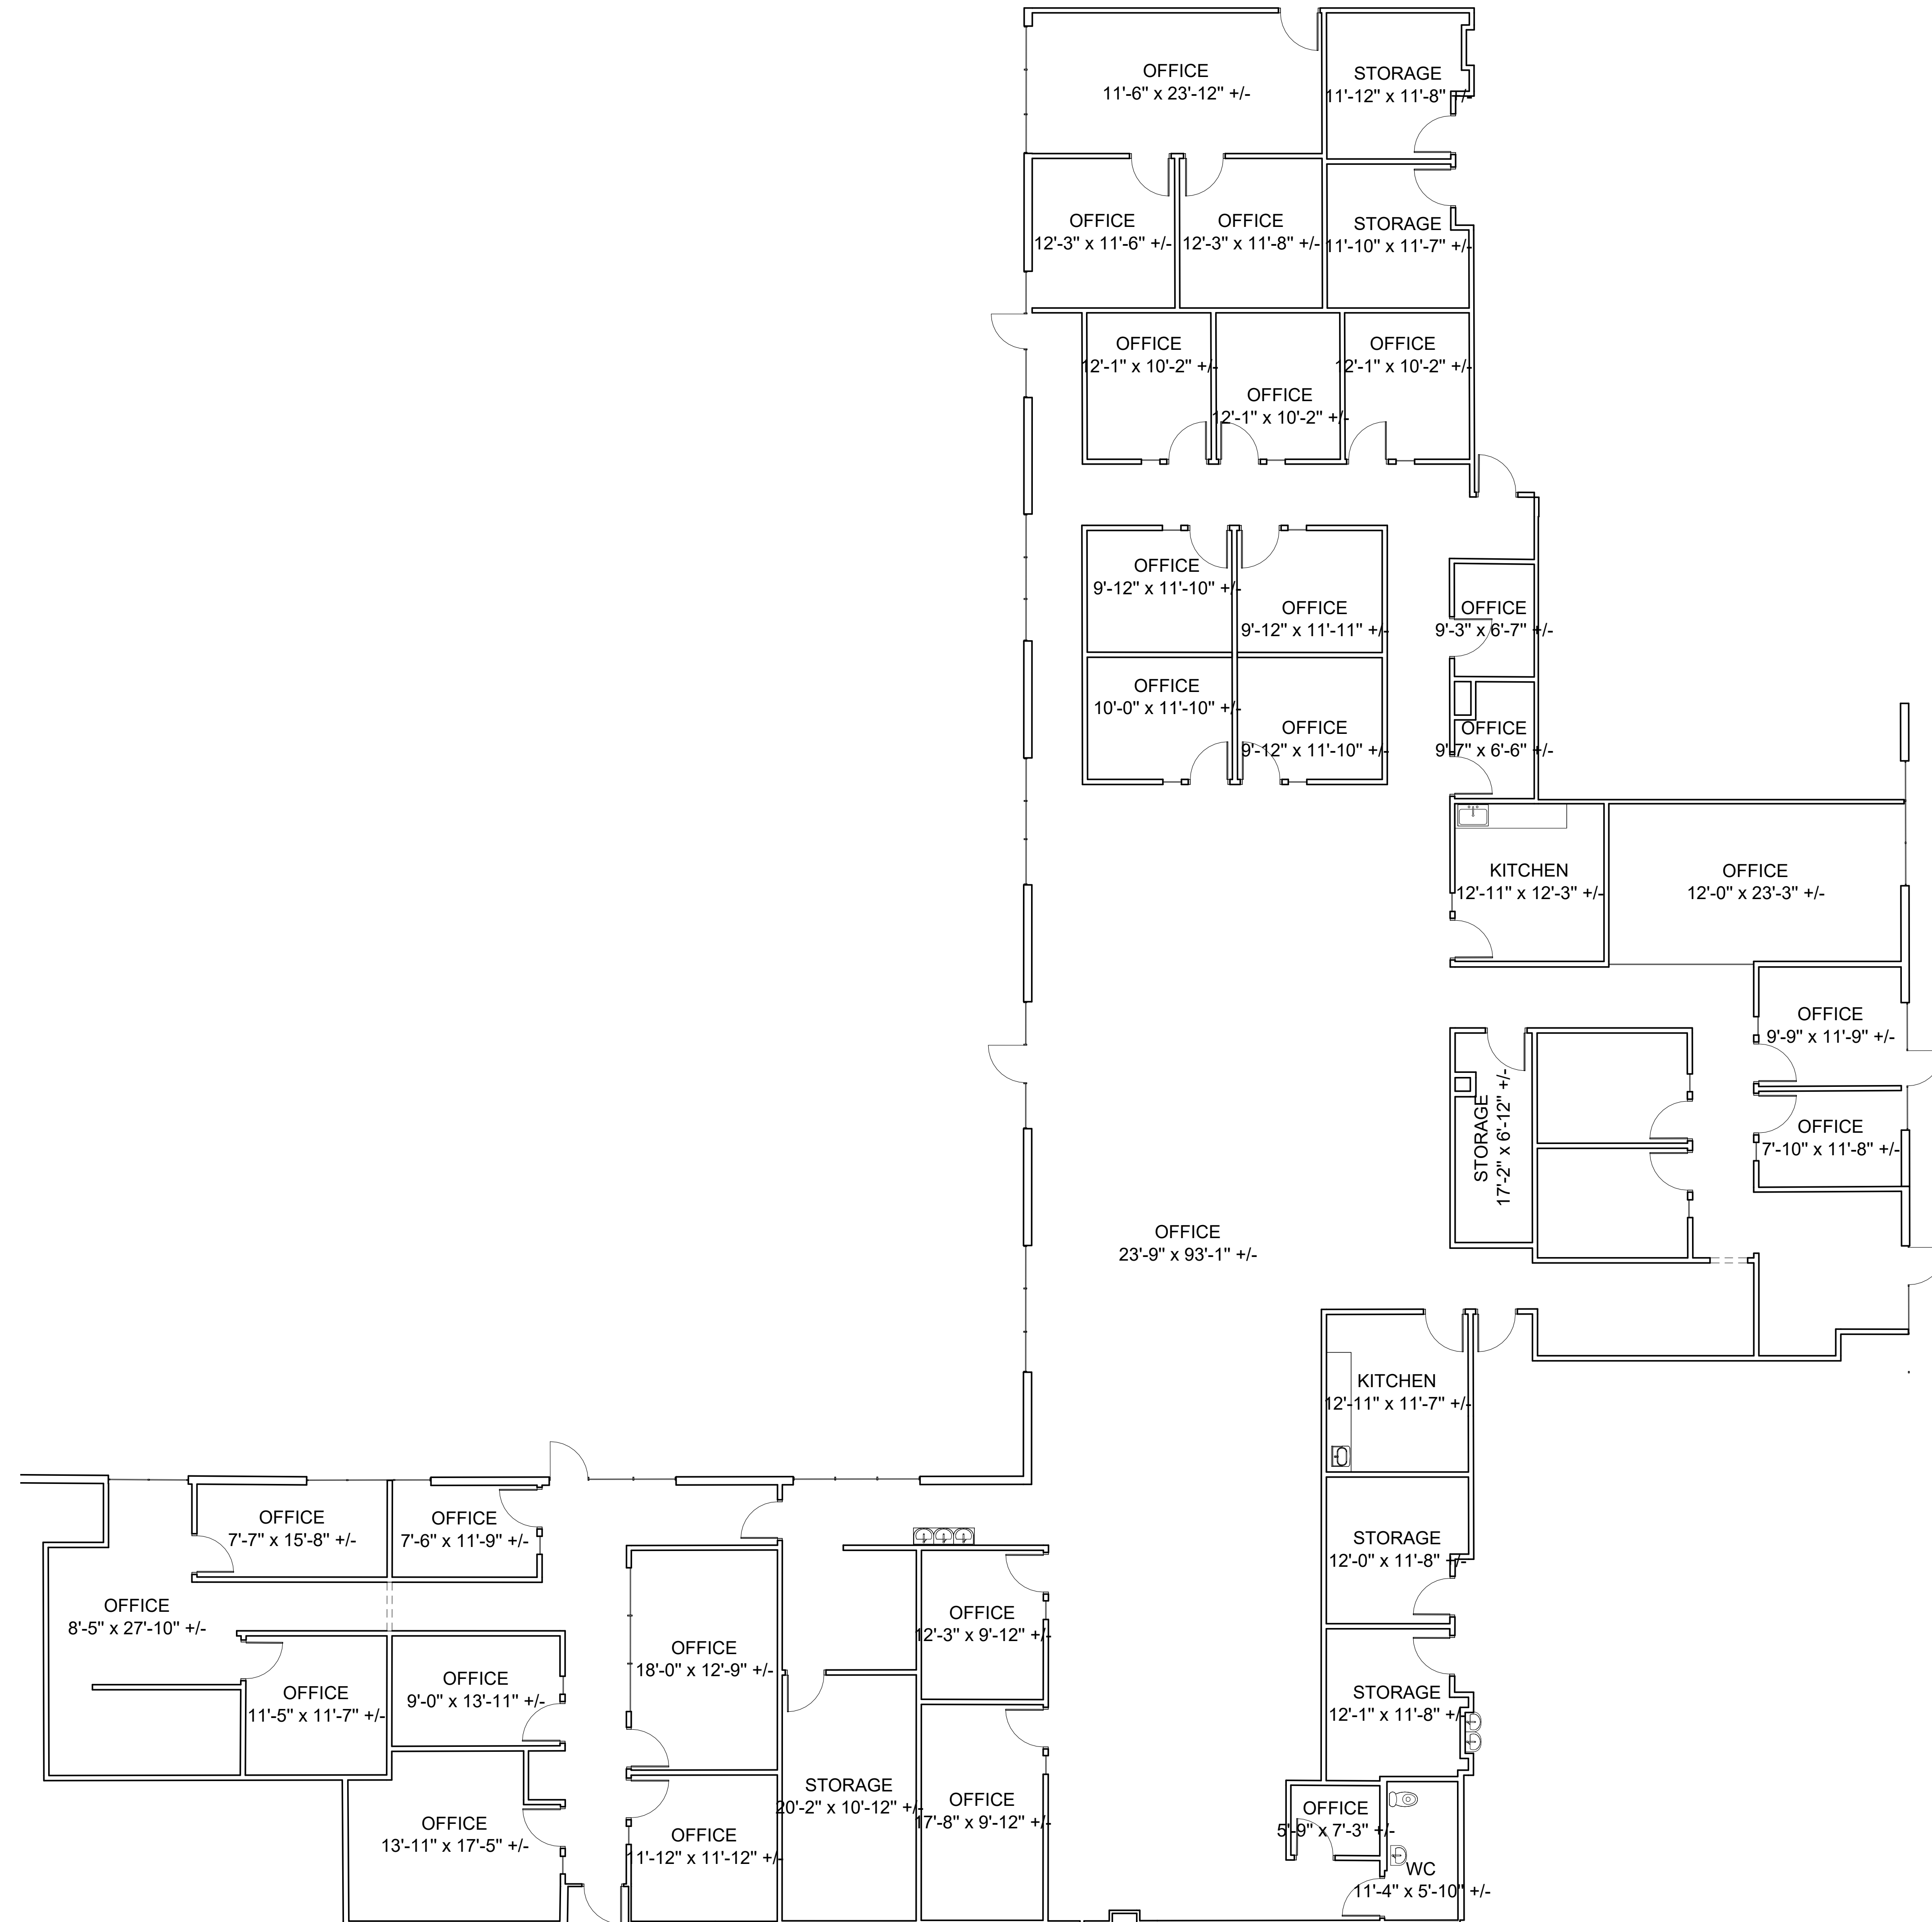

As Built Floor Plan for Marketing

