
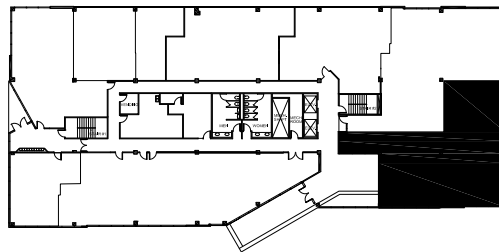


ADDISON NORTH

16801 Addison Road, Addison, Texas

SUITE 100
2,608 RSF

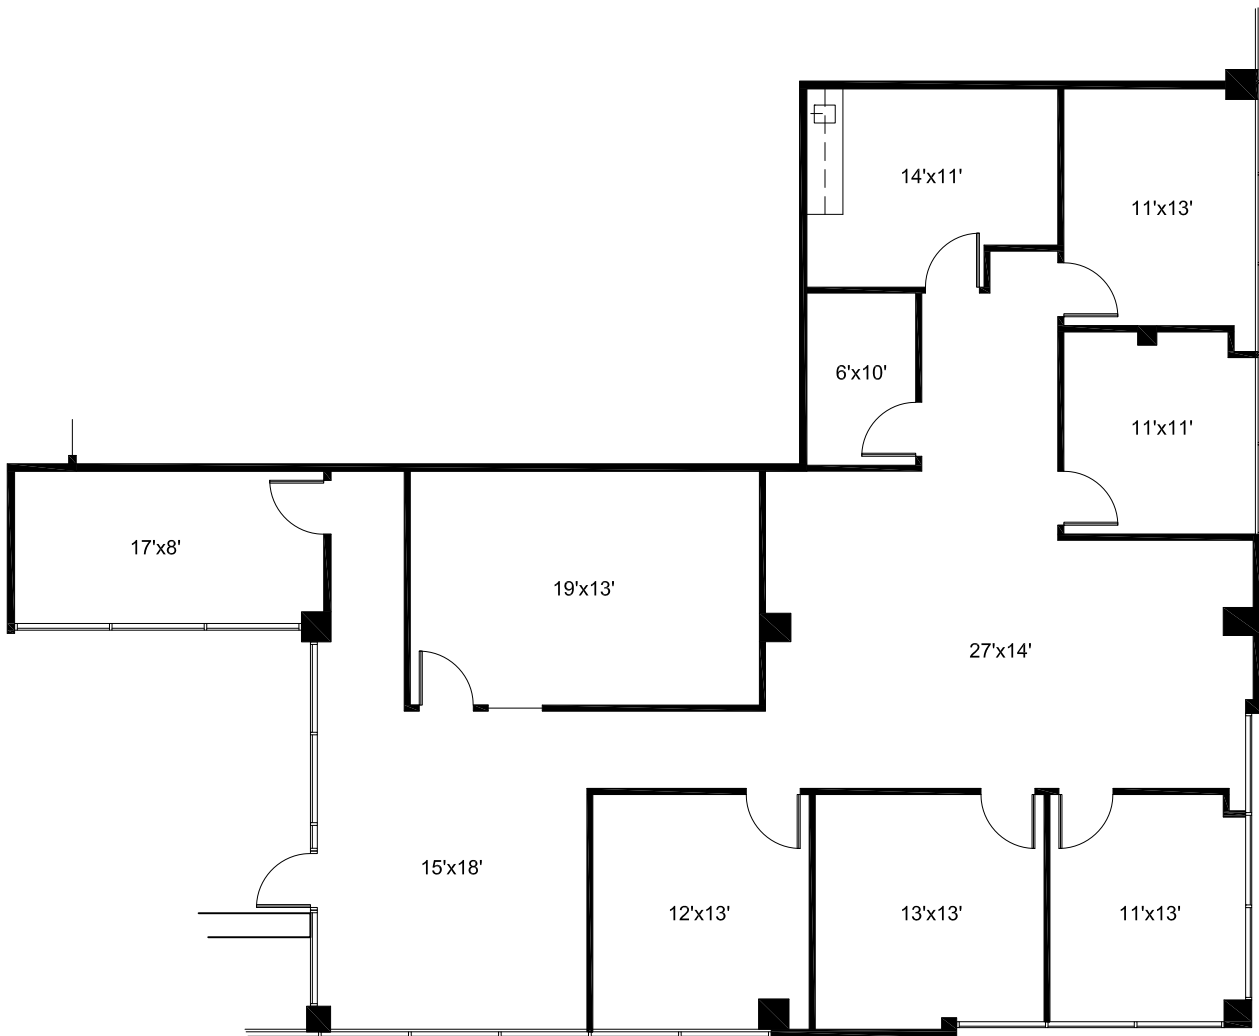

1ST FLOOR

Scale: 3/32"=1'-0"

All dimensions and square footages are approximate.

July 17, 2026



DFW DESIGN DEPOT

(817) 929-8804