


4,993 RSF



500 W. 190th STREET | GARDENA, CA 90248

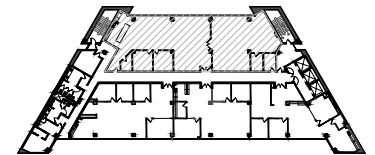

2ND FLOOR | SUITE 230 & 240