


Property Key

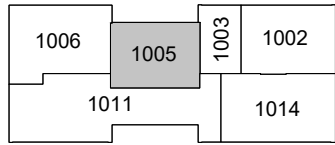

WMG ICOT BC As Built Marketing Package

13830-13923 58th Street North, Clearwater, FL 33760

Building: 10

Suite: 1005

Sheet: A-3


Scale: Not to Scale
Sheet Size: 8.5" x 11"
Not For Construction



Total Area - 1,997 SF

Building Information

DECK HEIGHT:	N/A
CEILING HEIGHT:	9'-0"
CLEAR HEIGHT:	9'-0"
SPRINKLERED:	No

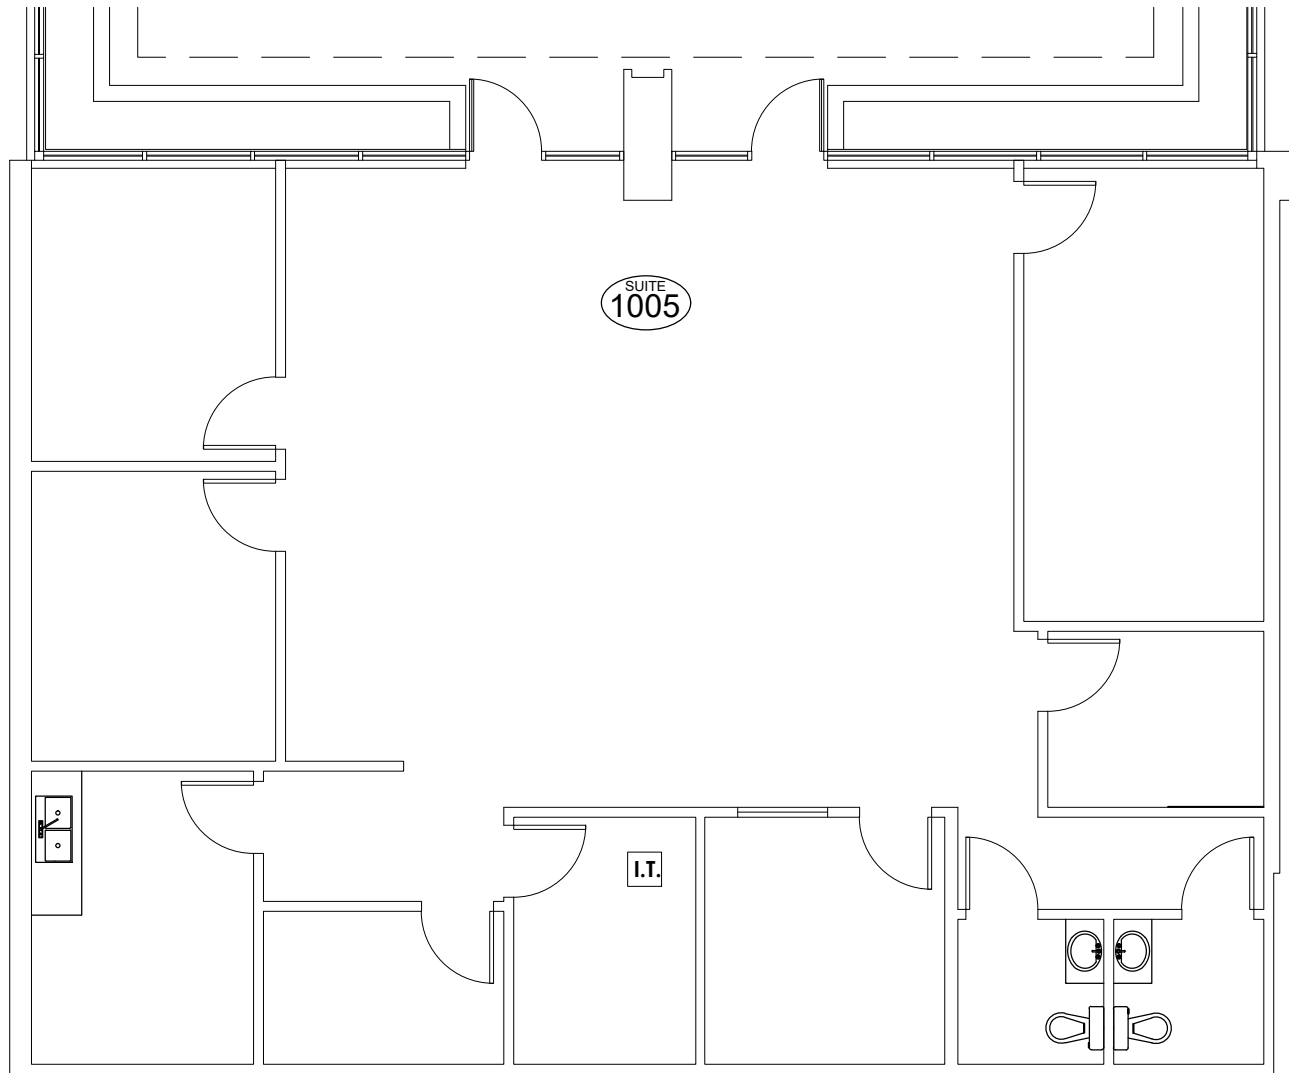

As Built Floor Plan for Marketing

