

Plan A Services Inc.
70 Gilbert St
Monroe NY 10950

718.219.4749

info@planaservices.com
planaservices.com

Project


63-15 Traffic Ave

Drawing

**As-built
Floor Plan**

A - 001

Area	
Scale	1/16" = 1'-0"
Date	07/02/2025
Drawn By	O. P.
Notes	40669 Square feet

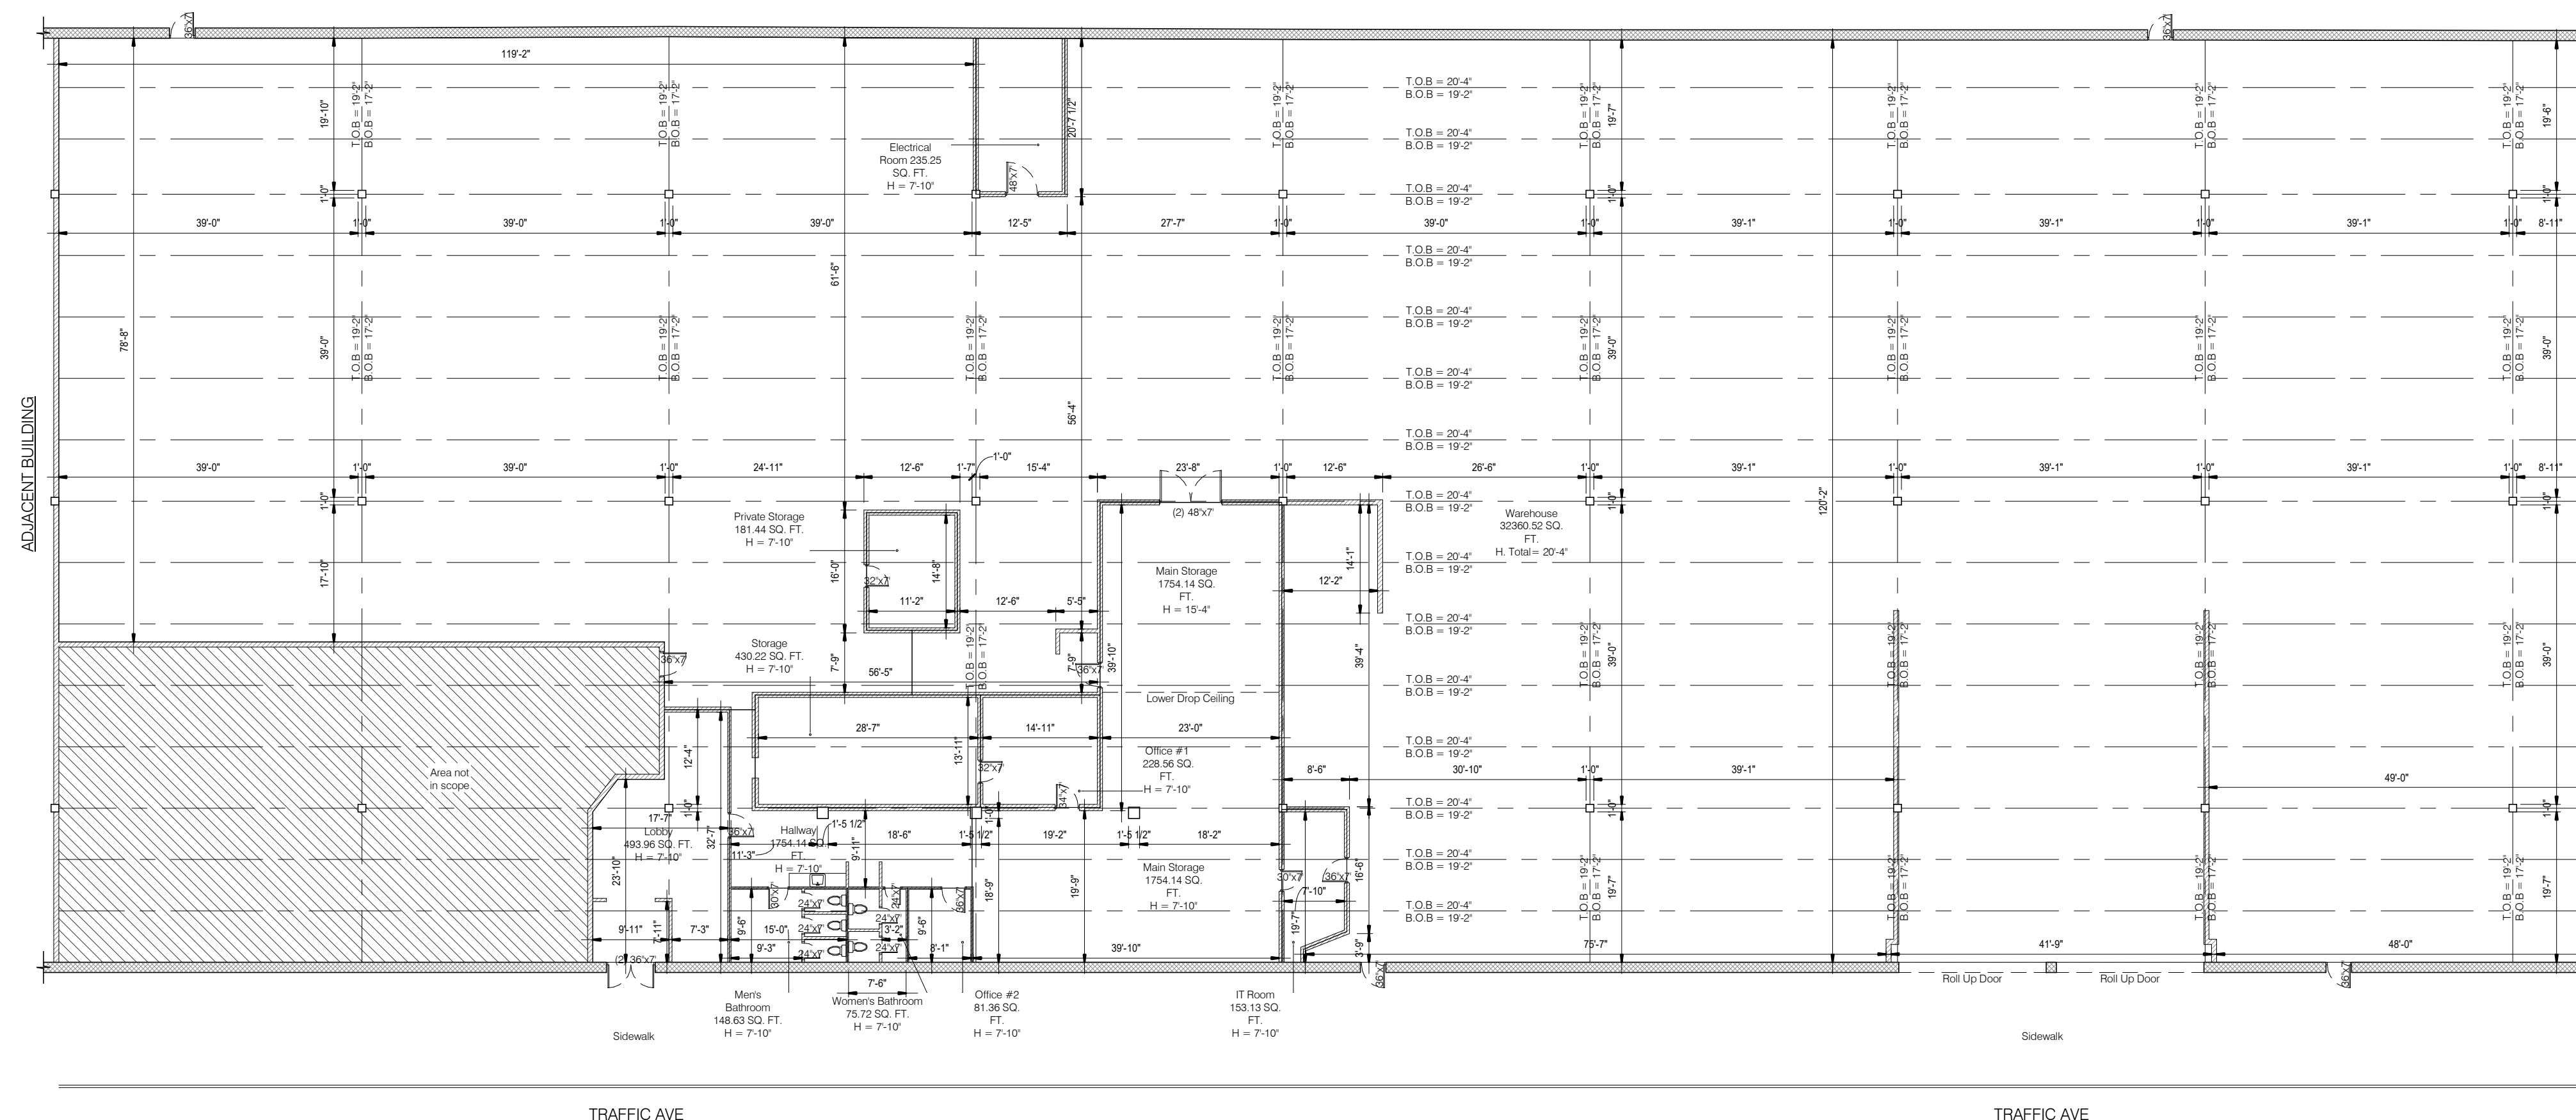

Address: 63-15 Traffic Ave, 11385
Block: 3608
Lot: 290
Zoning: M1-1
Zoning map: 13d

EXISTING GENERAL FIRST FLOOR PLAN
SCALE 3/32" = 1'-0"

Plan A Services Inc.
70 Gilbert St
Monroe NY 10950

718.219.4749

info@planaservices.com
planaservices.com

Project


63-15 Traffic Ave

Drawing

As-built Floor Plan

A - 002

Area	
Scale	1/16" = 1'-0"
Date	07/02/2025
Drawn By	O. P.
Notes	

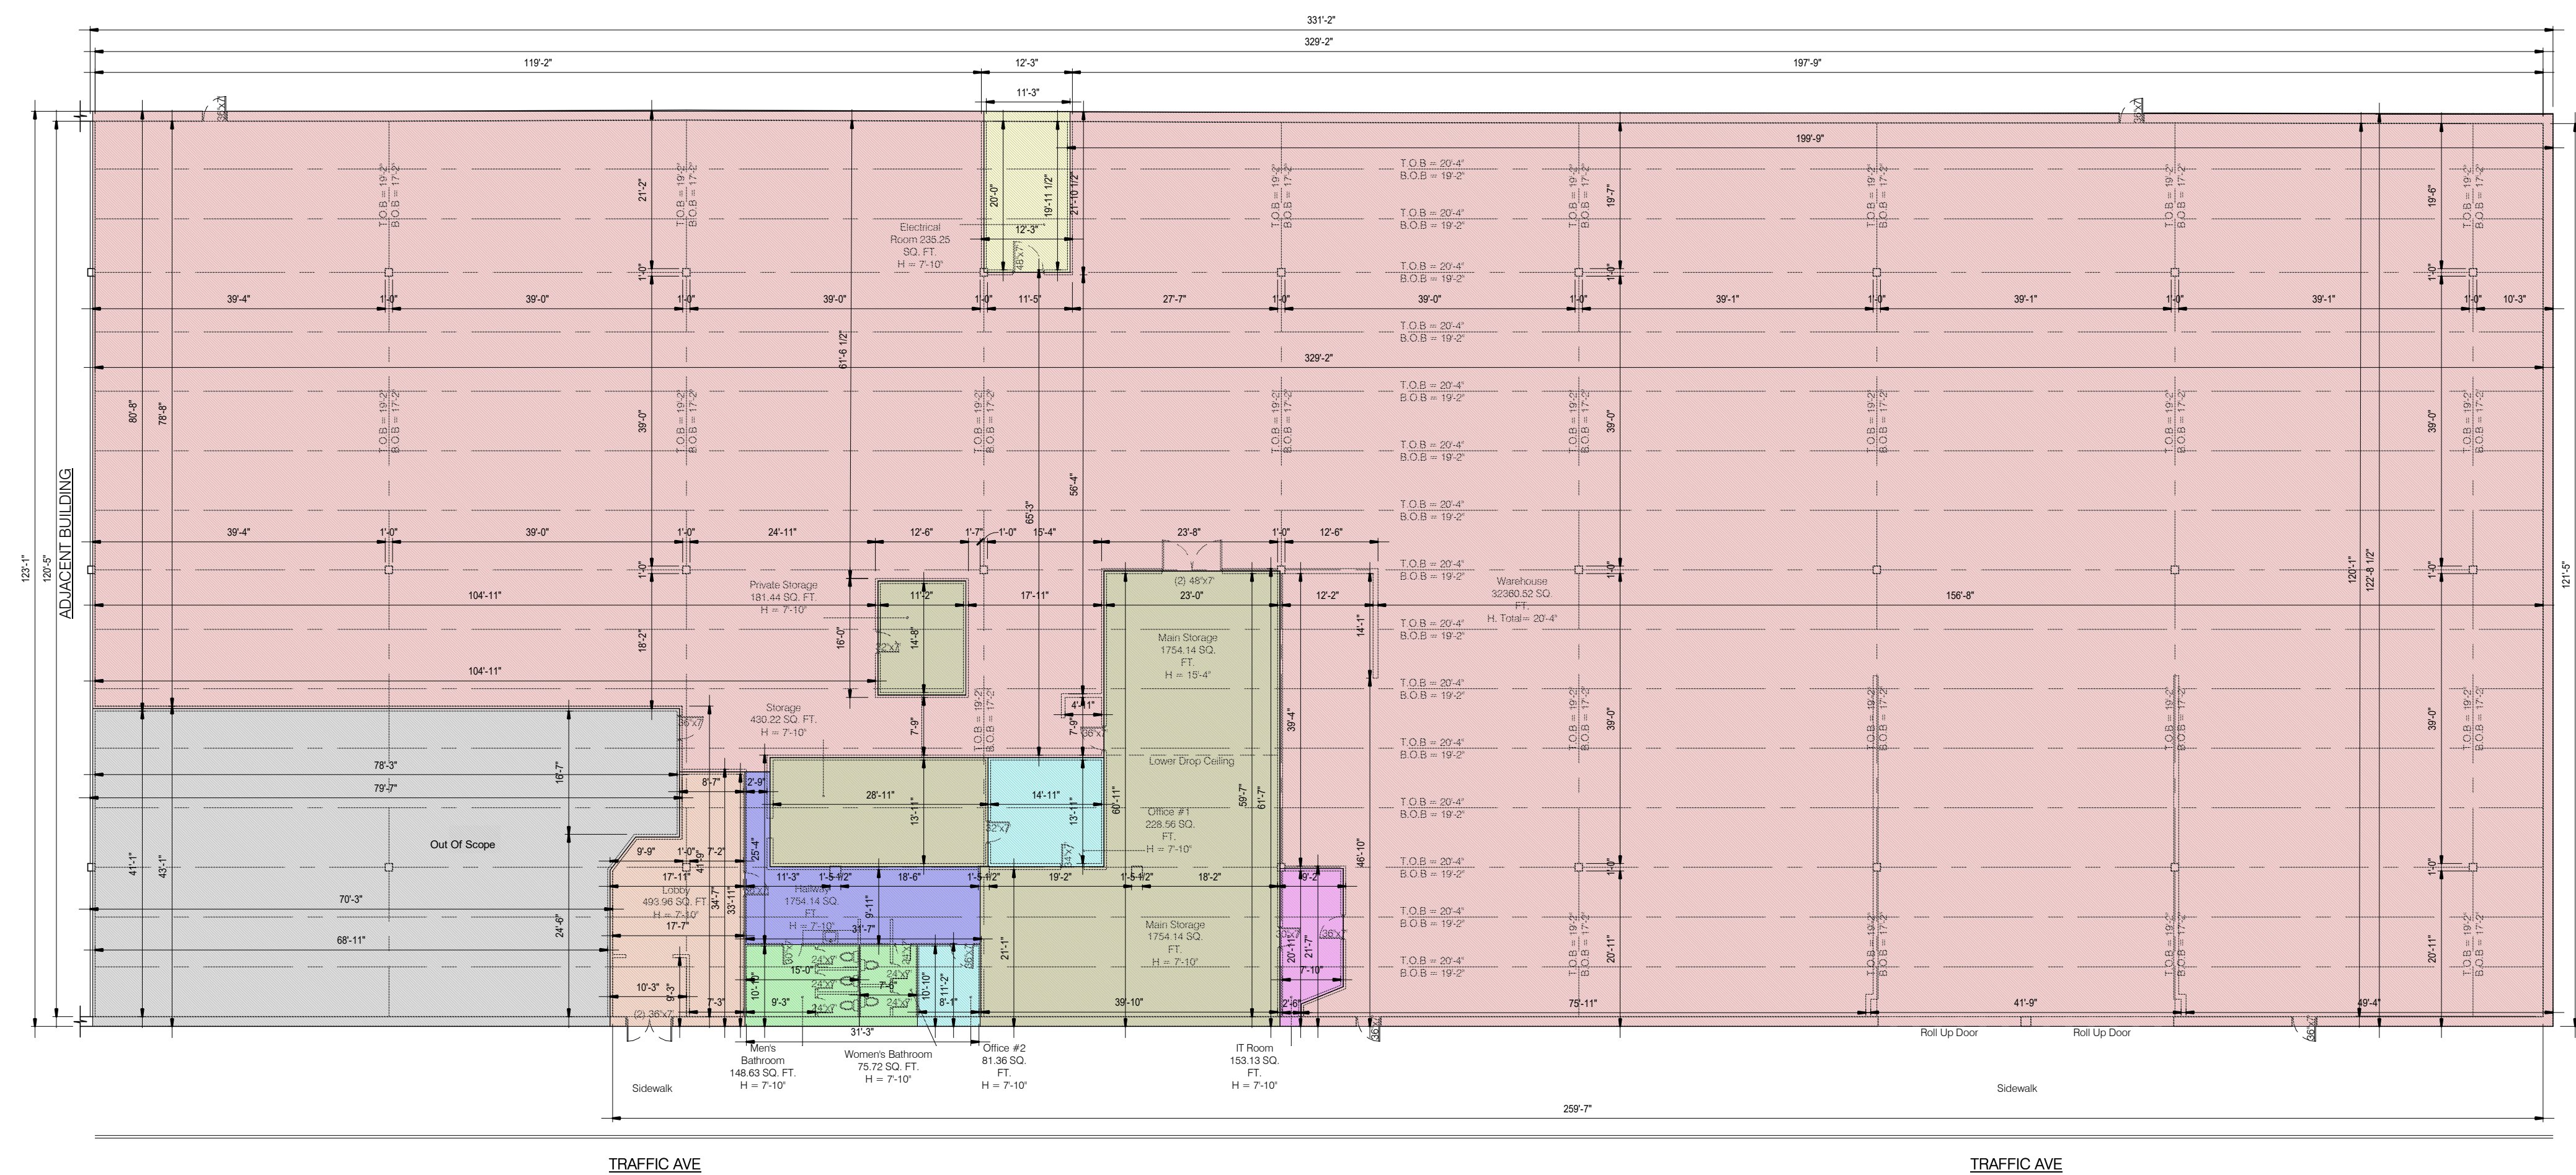

EXISTING GENERAL FIRST FLOOR PLAN
SCALE 3/32" = 1'-0"