


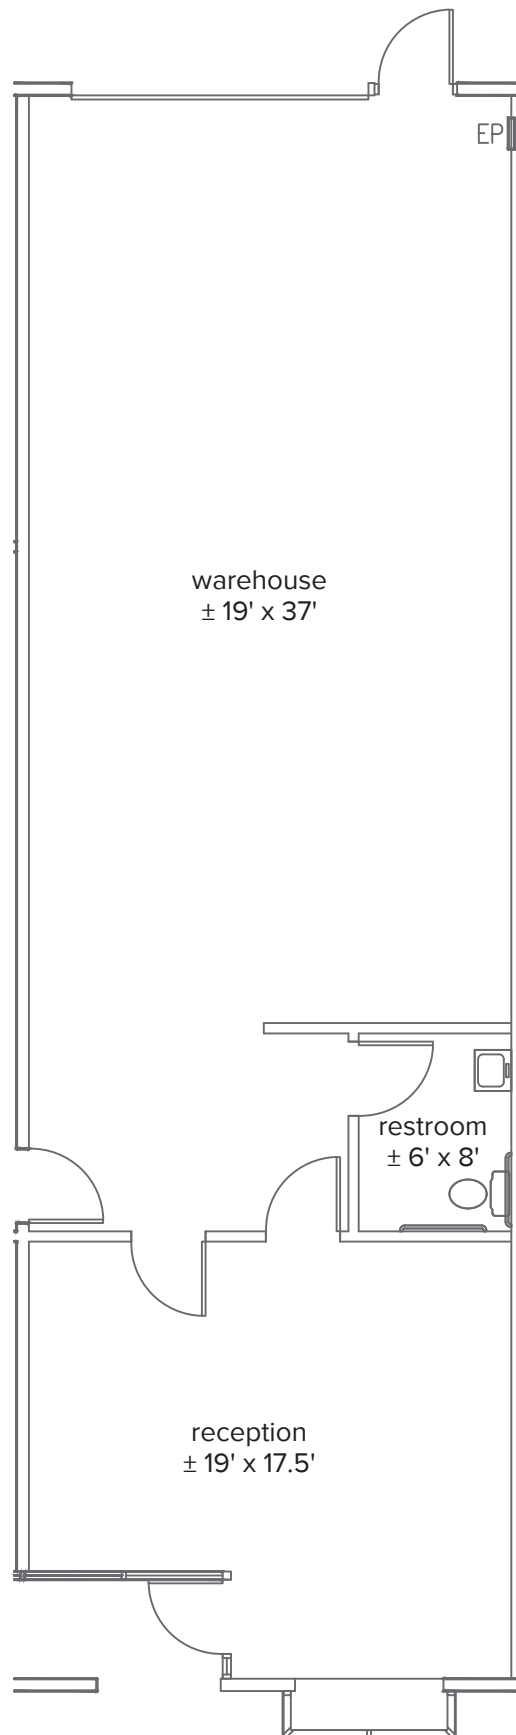

### Suite U

Sorrento Mesa Business Center  
9823 Pacific Heights Boulevard  
San Diego, CA 92121

### AS-BUILT PLAN

November 25, 2025  
Scaled to Fit  
1,333 RSF