

Property Key



Bryan Dairy As Built Marketing Package

7201 - 7281 Bryan Dairy Road, Largo, FL 33777

Building: East Building


Suite: 7235

Sheet: A-11

Scale: Not to Scale
Sheet Size: 8.5" x 11"
Not For Construction




BAY SPACE

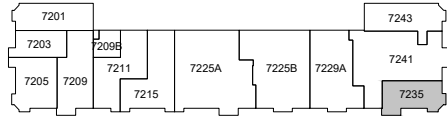

Total Area - 2,632 SF

Building Information

DECK HEIGHT:	N/A
CEILING HEIGHT:	8'-10"
CLEAR HEIGHT:	8'-10"
SPRINKLERED:	Yes

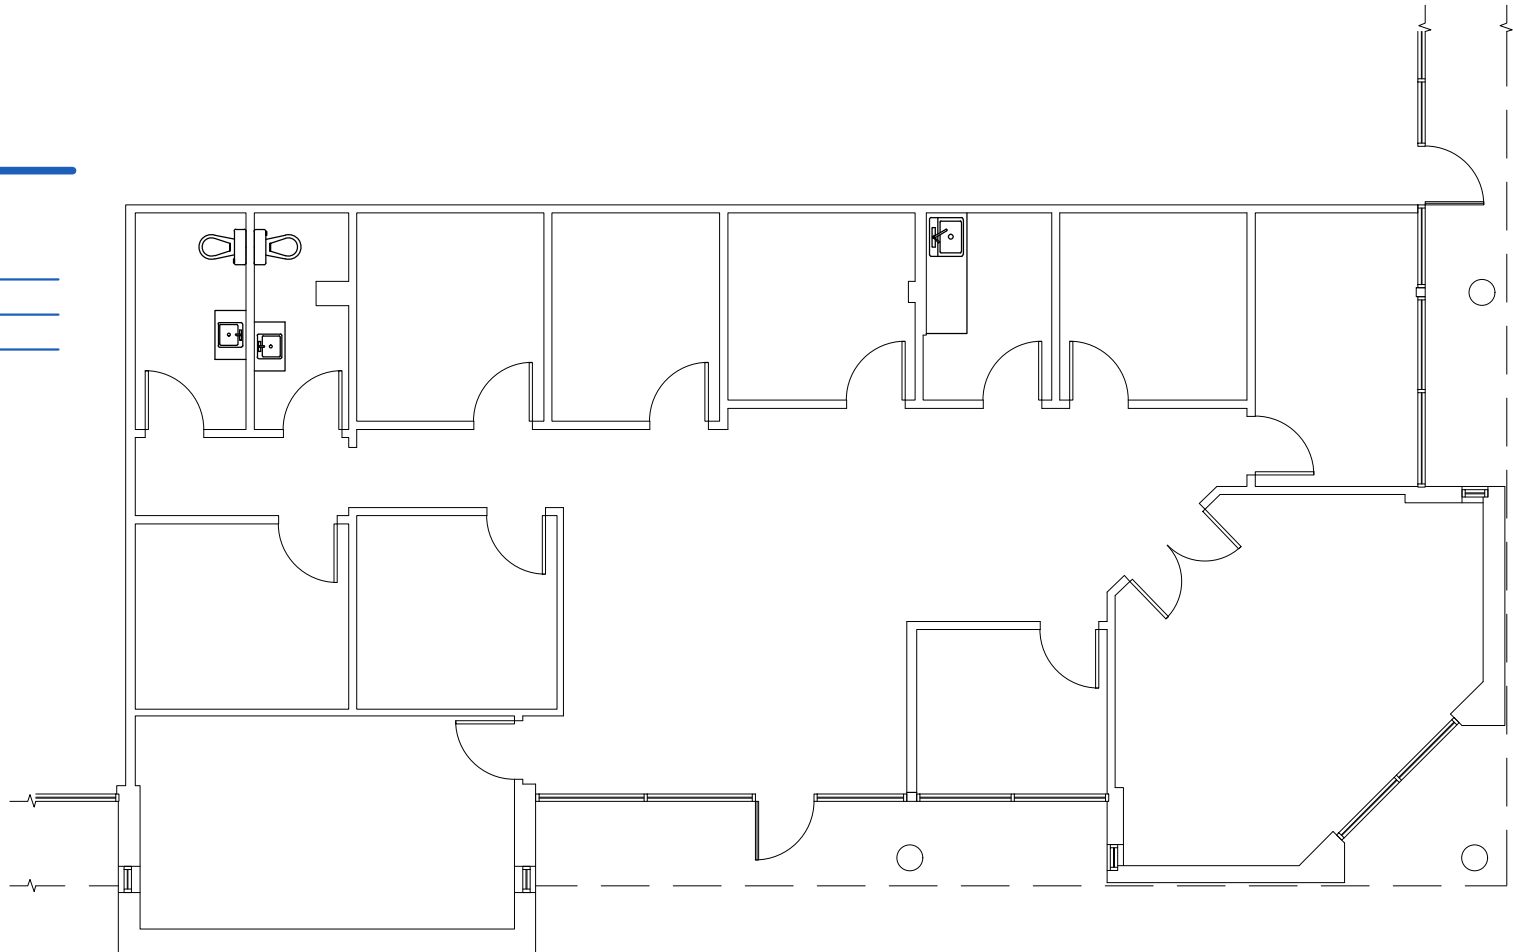

SUITE
7235

As Built Floor Plan for Marketing

