


S-2M	MEN'S 110	MEN RESTROOM SIGN	SEE GRAPHIC
S-3	CONFERENCE 103A	MAXIMUM OCCUPANCY SIGN	SEE GRAPHIC
S-4	CONFERENCE 121A	MAXIMUM OCCUPANCY SIGN	SEE GRAPHIC
S-5	CONFERENCE 135	MAXIMUM OCCUPANCY SIGN	SEE GRAPHIC
S-6	CONFERENCE 143C	MAXIMUM OCCUPANCY SIGN	SEE GRAPHIC
S-7	KITCHENETTE 122A	MAXIMUM OCCUPANCY SIGN	SEE GRAPHIC
S-8	CONFERENCE 134	MAXIMUM OCCUPANCY SIGN	SEE GRAPHIC

NOTE: ALL SIGNS TO BE MOUNTED 60" ABOVE THE FINISH FLOOR TO THE CENTERLINE OF THE SIGN.

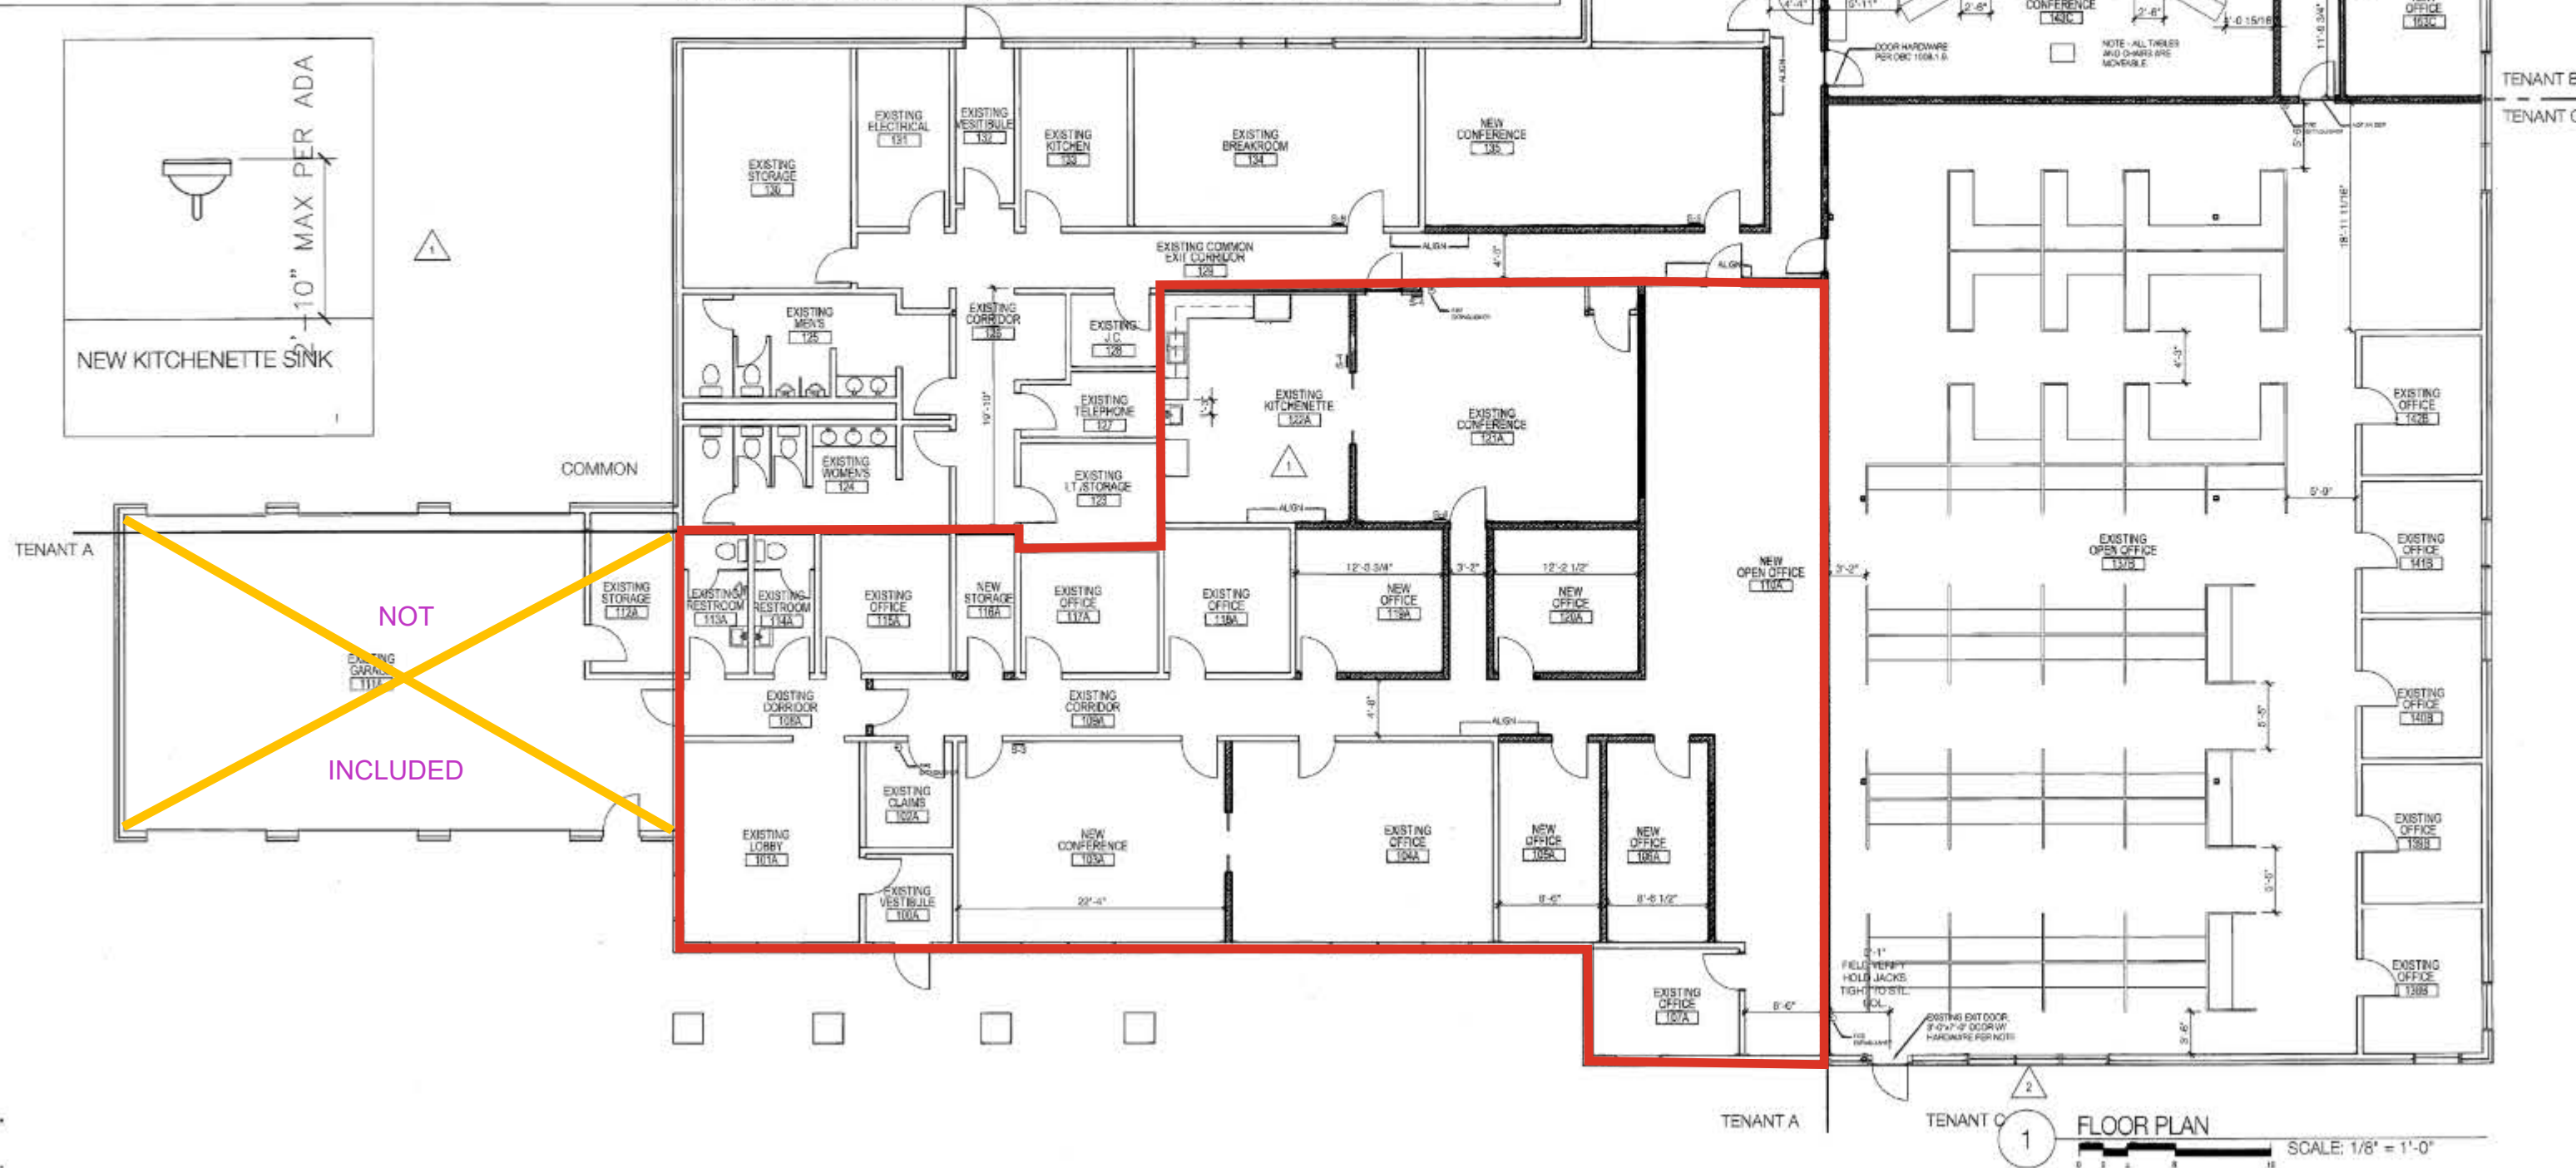


1. ALL NEW WALLS TO BY TYPE A1.
2. ALL NEW DOORS TO MATCH EXISTING.
3. 3'-0"x6'-8"x1 3/4" SOLID CORE VENEER.
4. TENANT SPACE A RECIEVES NEW CARPET.
5. ALL EXISTING BATHROOMS TO REMAIN AS IS.
6. G.C. TO BRACE ALL EXISTING CONSTRUCTION DURING ANY DEMOLITION.
7. PATCH AND REPAIR ALL DRYWALL AS REQUIRED.
8. FIELD VERIFY ALL EXISITING CONDITIONS PRIOR TO AN DEMOLITION. NOTIFY ARCHITECT/ENGINEER OF ANY CONFLICTS.

AREA BREAKDOWN USE GROUP B
COMMON AREA = 3,477 S.F.
TENANT A = 4,796 S.F.
TENANT B = 2,177 S.F.
TENANT C = 4,243 S.F.

WALL LEGEND

EXISTING WALL TO REMAIN

NEW WALL PER WALL TYPE A1

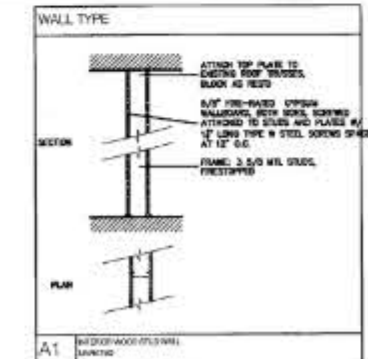

NEW EMERGENCY EXIT DOOR HARDWARE

EMERGENCY EXIT DOOR HARDWARE TO BE INSTALLED AT ALL EXISTING EXIT DOORS

AS BUILT INTERIOR ALTERATIONS

MASTERS INSURANCE

178 W. SCHROCK ROAD
WESTERVILLE, OH 43081

AS BUILT

SCALE: 1/4" = 1'-0"

PROJECT NO.: 14020

REVISION 1 - 17 NOV. 2014

REVISION 2 - 9 FEB. 2015

REVISION 4 - 28 FEB. 2017

DATE: 24 OCT. 2014

SHEET NO.

A100

FLOOR PLAN