





MIDTOWN PLAZA

ONE.TWO

ONE MIDTOWN PLAZA
1360 PEACHTREE ST

As Built | Suite 200 | 14,356 RSF

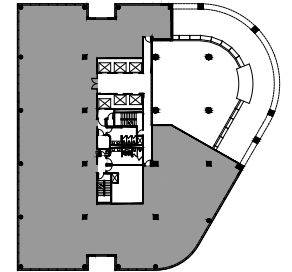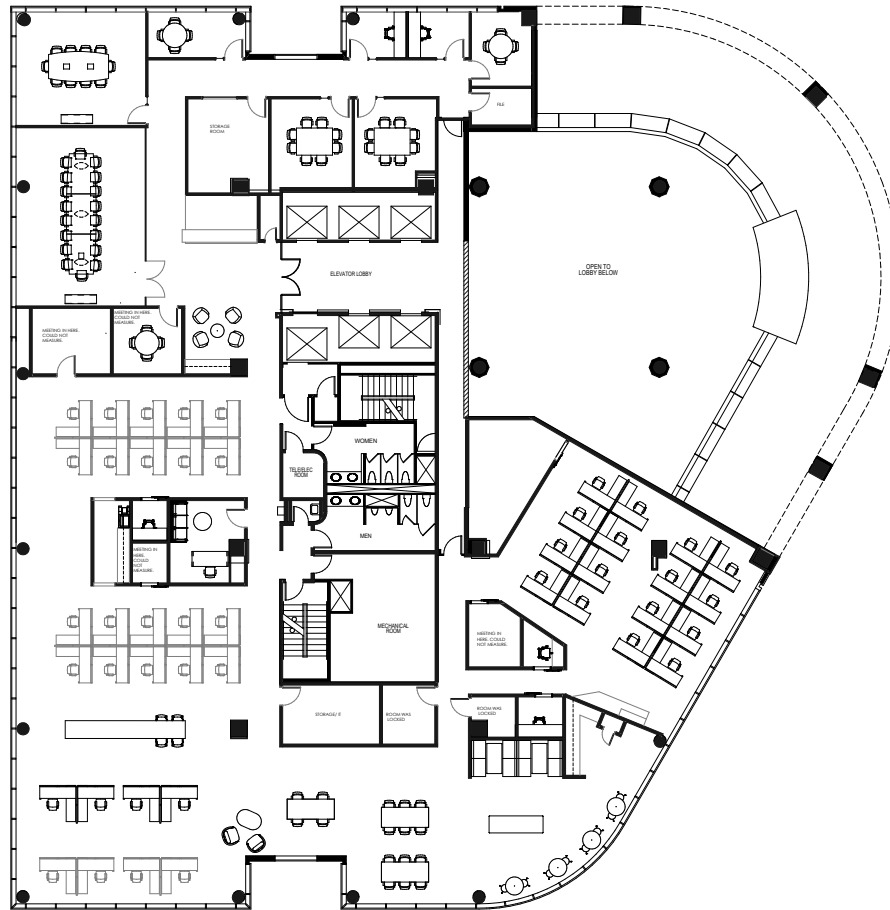

FOR LEASING
INFORMATION,
CONTACT:

CORI NUTTALL, CCIM
cnuttall@trinity-partners.com
843.475.8285

MARY-THOMPSON MILLER
mtmiller@trinity-partners.com
251.359.0973