


# Property Key

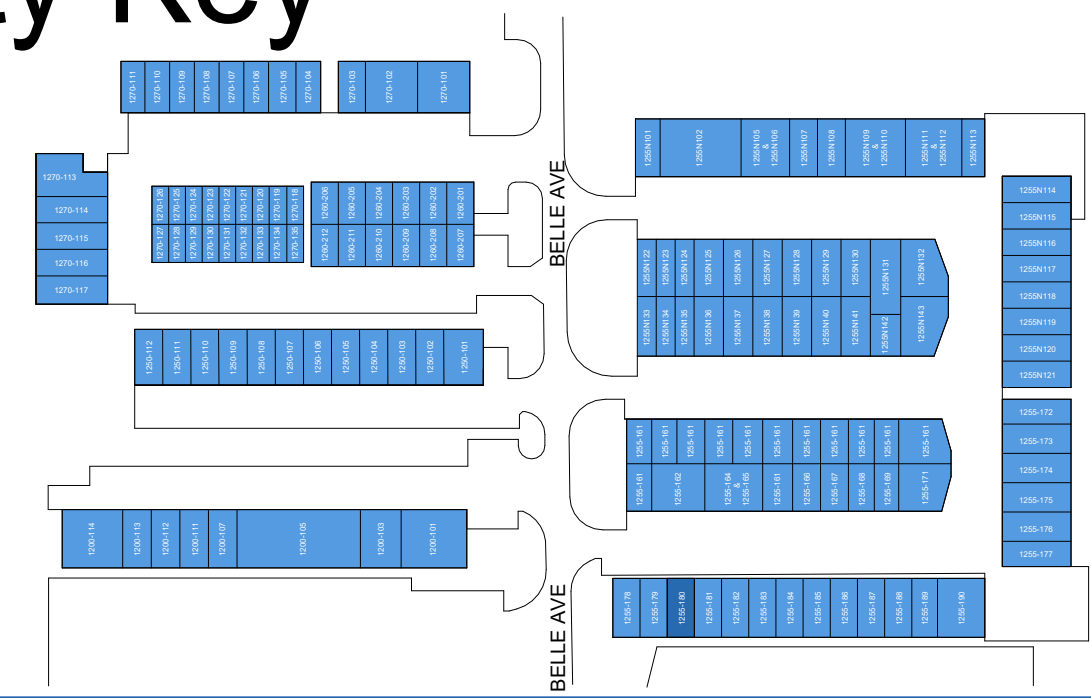

# Belle, Winter Springs As Built Marketing Package

1255 Belle Ave, Winter Springs, FL 32708, US

Building: 1255C

Suite: 180

Sheet **E1**

Scale: Not to Scale  
Sheet Size: 42" x 30"  
Not For Construction



# BAY SPACE

## Usable Square Foot Analysis

Office Area	1,474	100 %
Warehouse Area	0	0%
Total Area	1,474	

## Building Information

Deck Height:	15' - 4 1/2"
Clear Height:	11' - 11 1/2"
Ceiling Height:	7' - 8 1/2"
Sprinklered:	<input type="checkbox"/> Yes <input checked="" type="checkbox"/> No
Mechanical Area:	0 SQFT

