
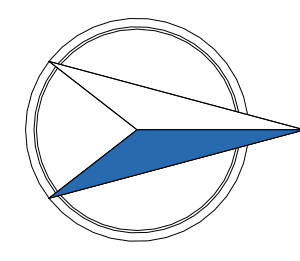


Property Key

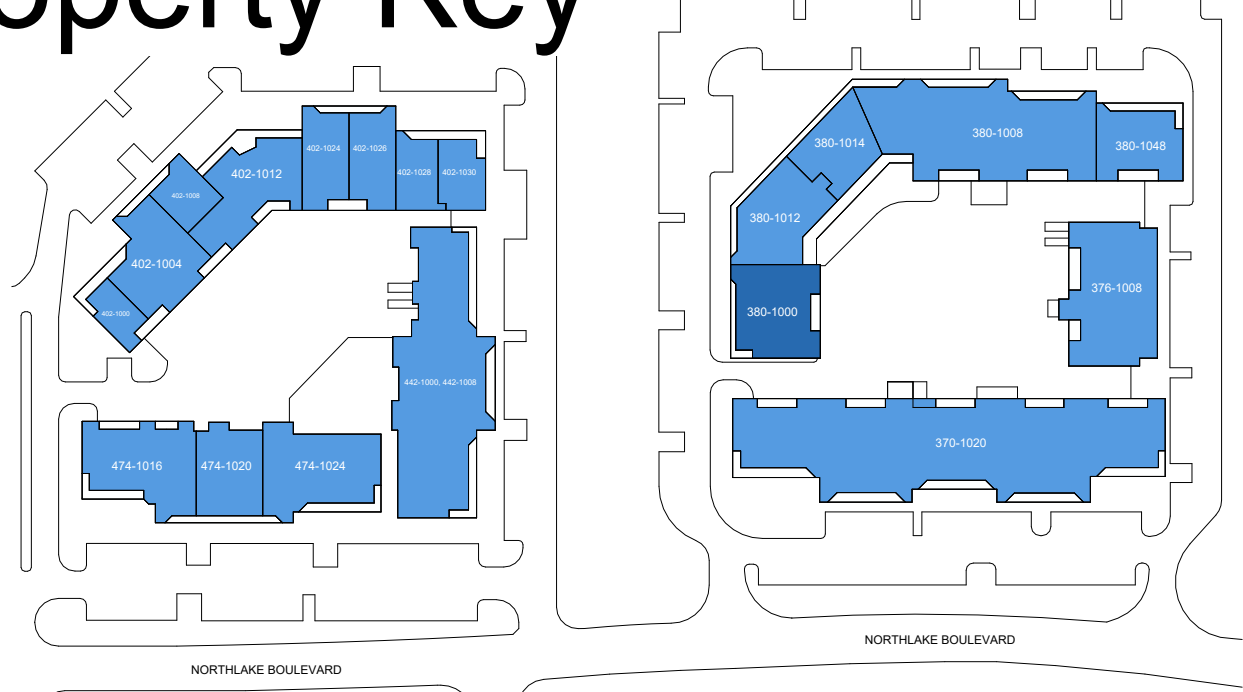

Alt Springs As Built Marketing Package

380 Northlake Blvd, Alt Springs, FL 32701, US

Building: 380

Suite: 1000

Sheet **E1**



BAY SPACE


Scale: Not to Scale
Sheet Size: 42" x 30"
Not For Construction

Usable Square Foot Analysis

Office Area	3,320	89%
Warehouse Area	428	11%
Total Area	3,748	

Building Information

Deck Height:	13' - 9 1/2"
Clear Height:	10' - 9"
Ceiling Height:	9' - 0 1/2"
Sprinklered:	<input checked="" type="checkbox"/> Yes <input type="checkbox"/> No
Mechanical Area:	0 SQFT

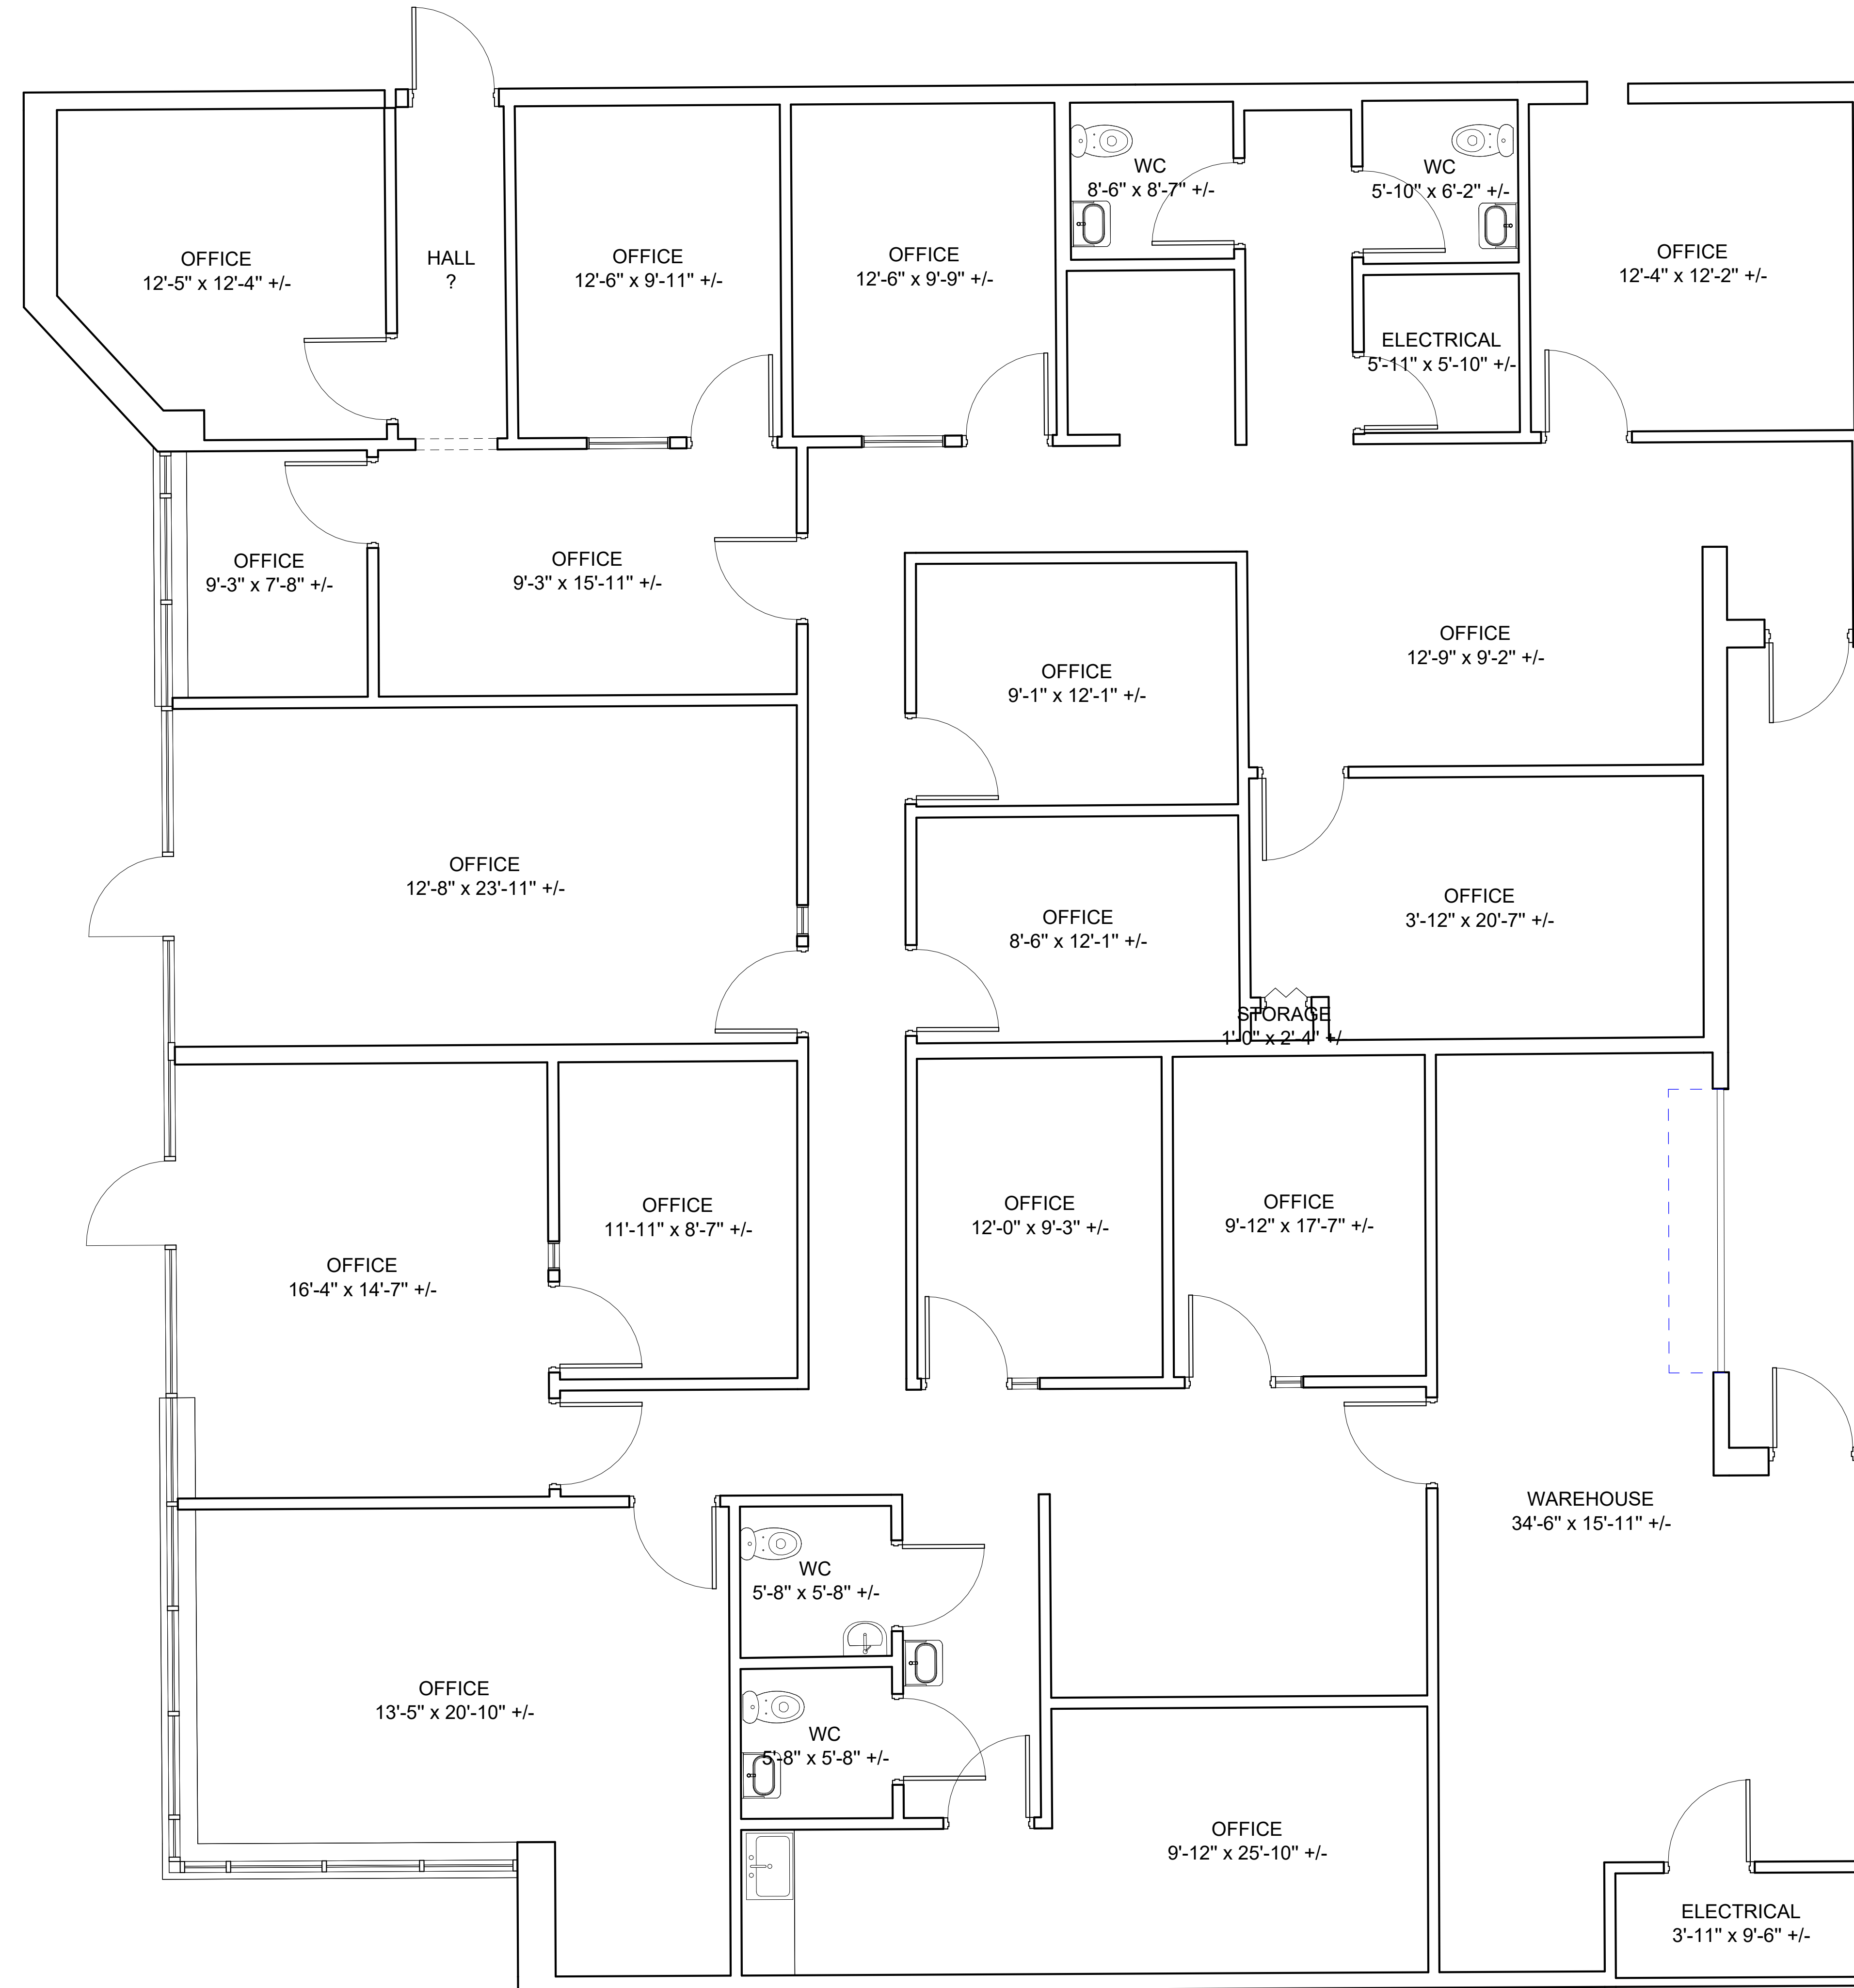

As Built Floor Plan for Marketing

