


Property Key

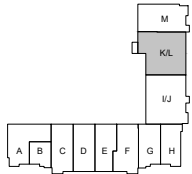

Turtle Creek As Built Marketing Package

4900 - 4914 Creekside Drive, Clearwater, FL 33760

Building: 4900

Suite: K / L

Sheet: A-10




BAY SPACE

Scale: Not to Scale
Sheet Size: 8.5" x 11"
Not For Construction

Total Area - 3,624 SF

Building Information

DECK HEIGHT:	N/A
CEILING HEIGHT:	8'-10"
CLEAR HEIGHT:	8'-10"
SPRINKLERED:	No
OVERHANG AREA:	157

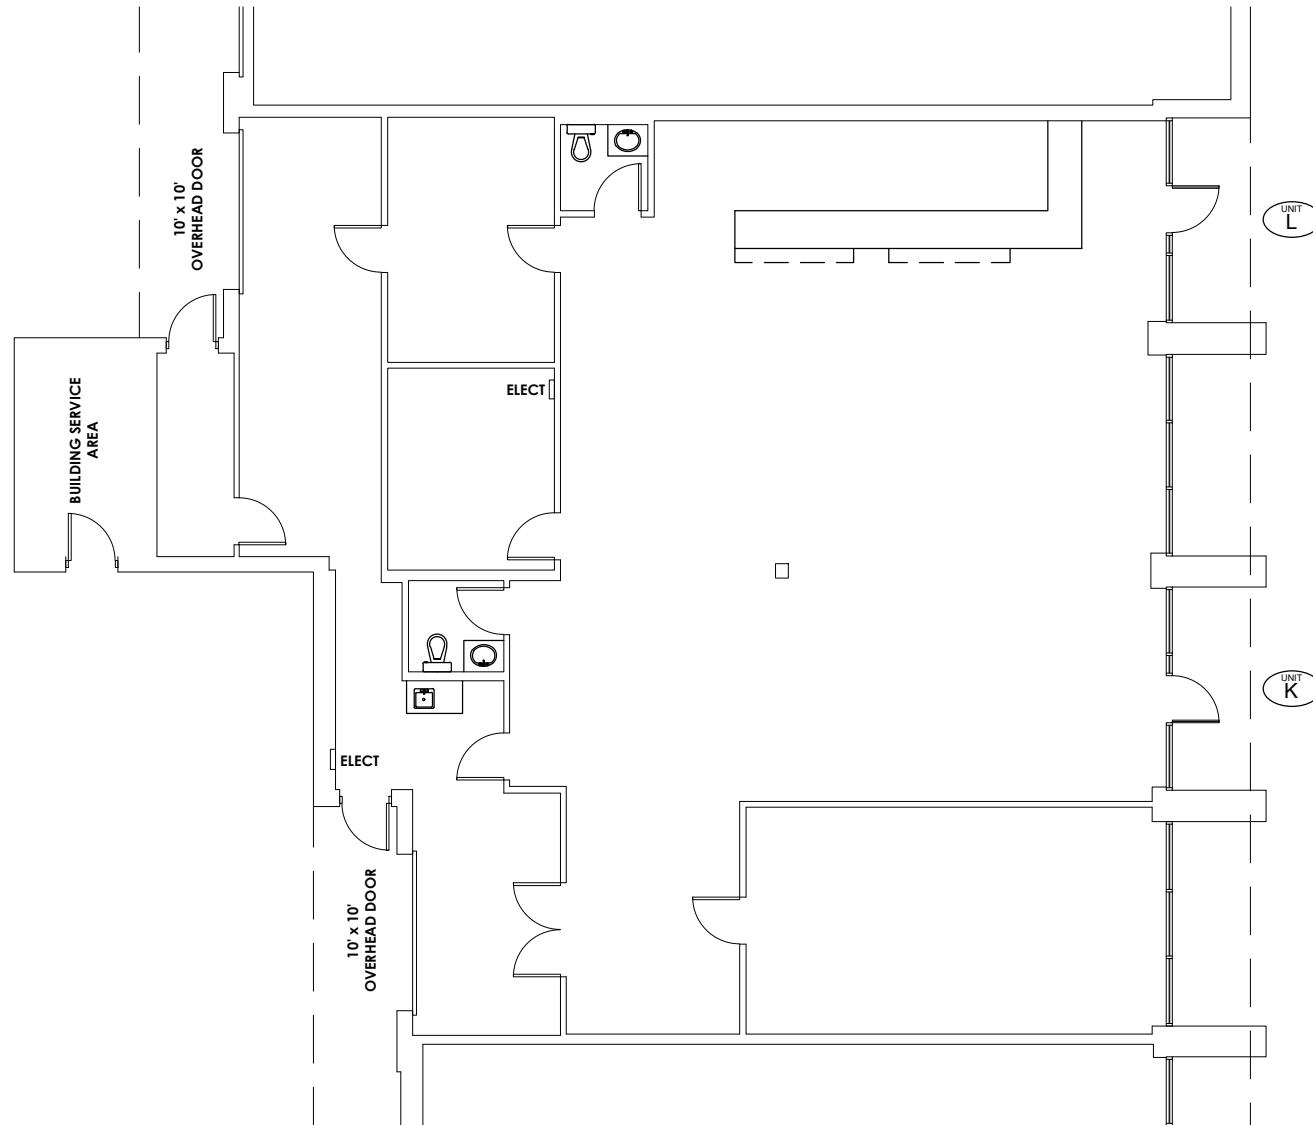

As Built Floor Plan for Marketing

