
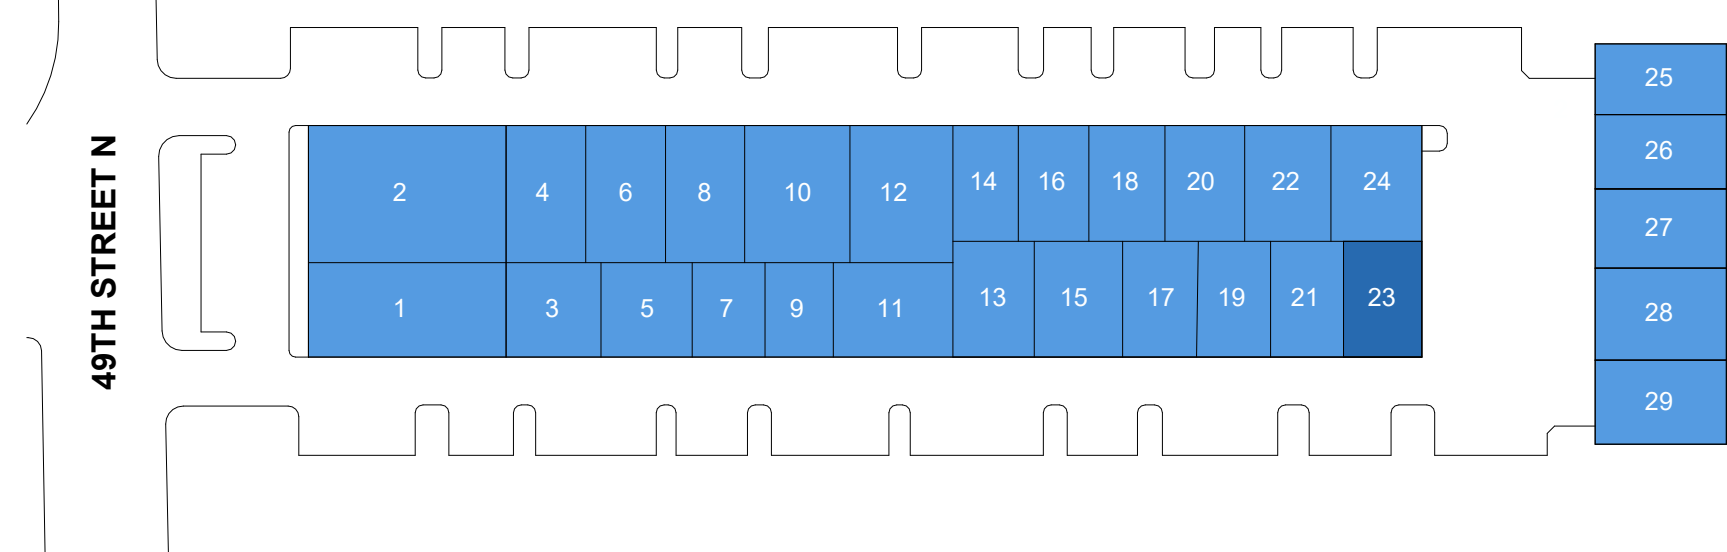


Property Key

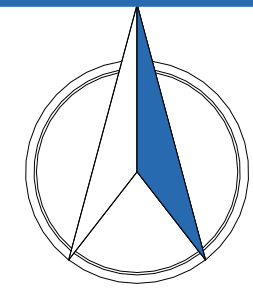


Clearwater As Built Marketing Package

14605, 49th Street N, Clearwater, FL 33762, US

Building: 1

Suite: 23

Sheet **E1**

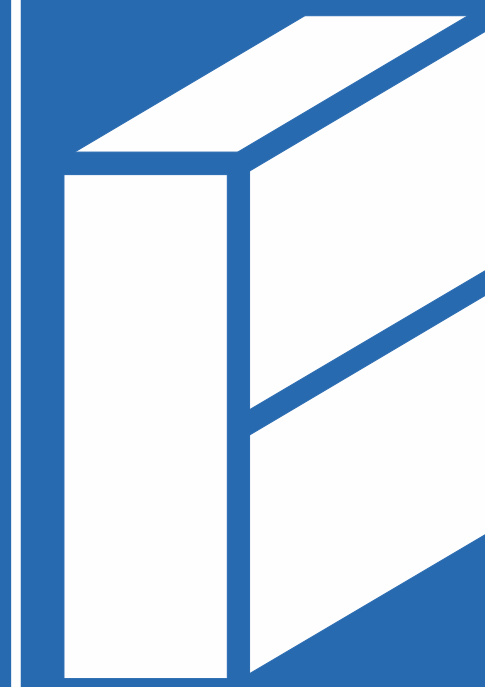

BAY SPACE


Scale: Not to Scale
Sheet Size: 42" x 30"
Not For Construction

Usable Square Foot Analysis

Office Area	1,250	100 %
Warehouse Area	0	0%
Total Area	1,250	

Building Information

Deck Height:	13' - 7 1/2"
Clear Height:	9' - 4"
Ceiling Height:	7' - 6 1/2"
Sprinklered:	<input type="checkbox"/> Yes <input checked="" type="checkbox"/> No
Mechanical Area:	0 SQFT

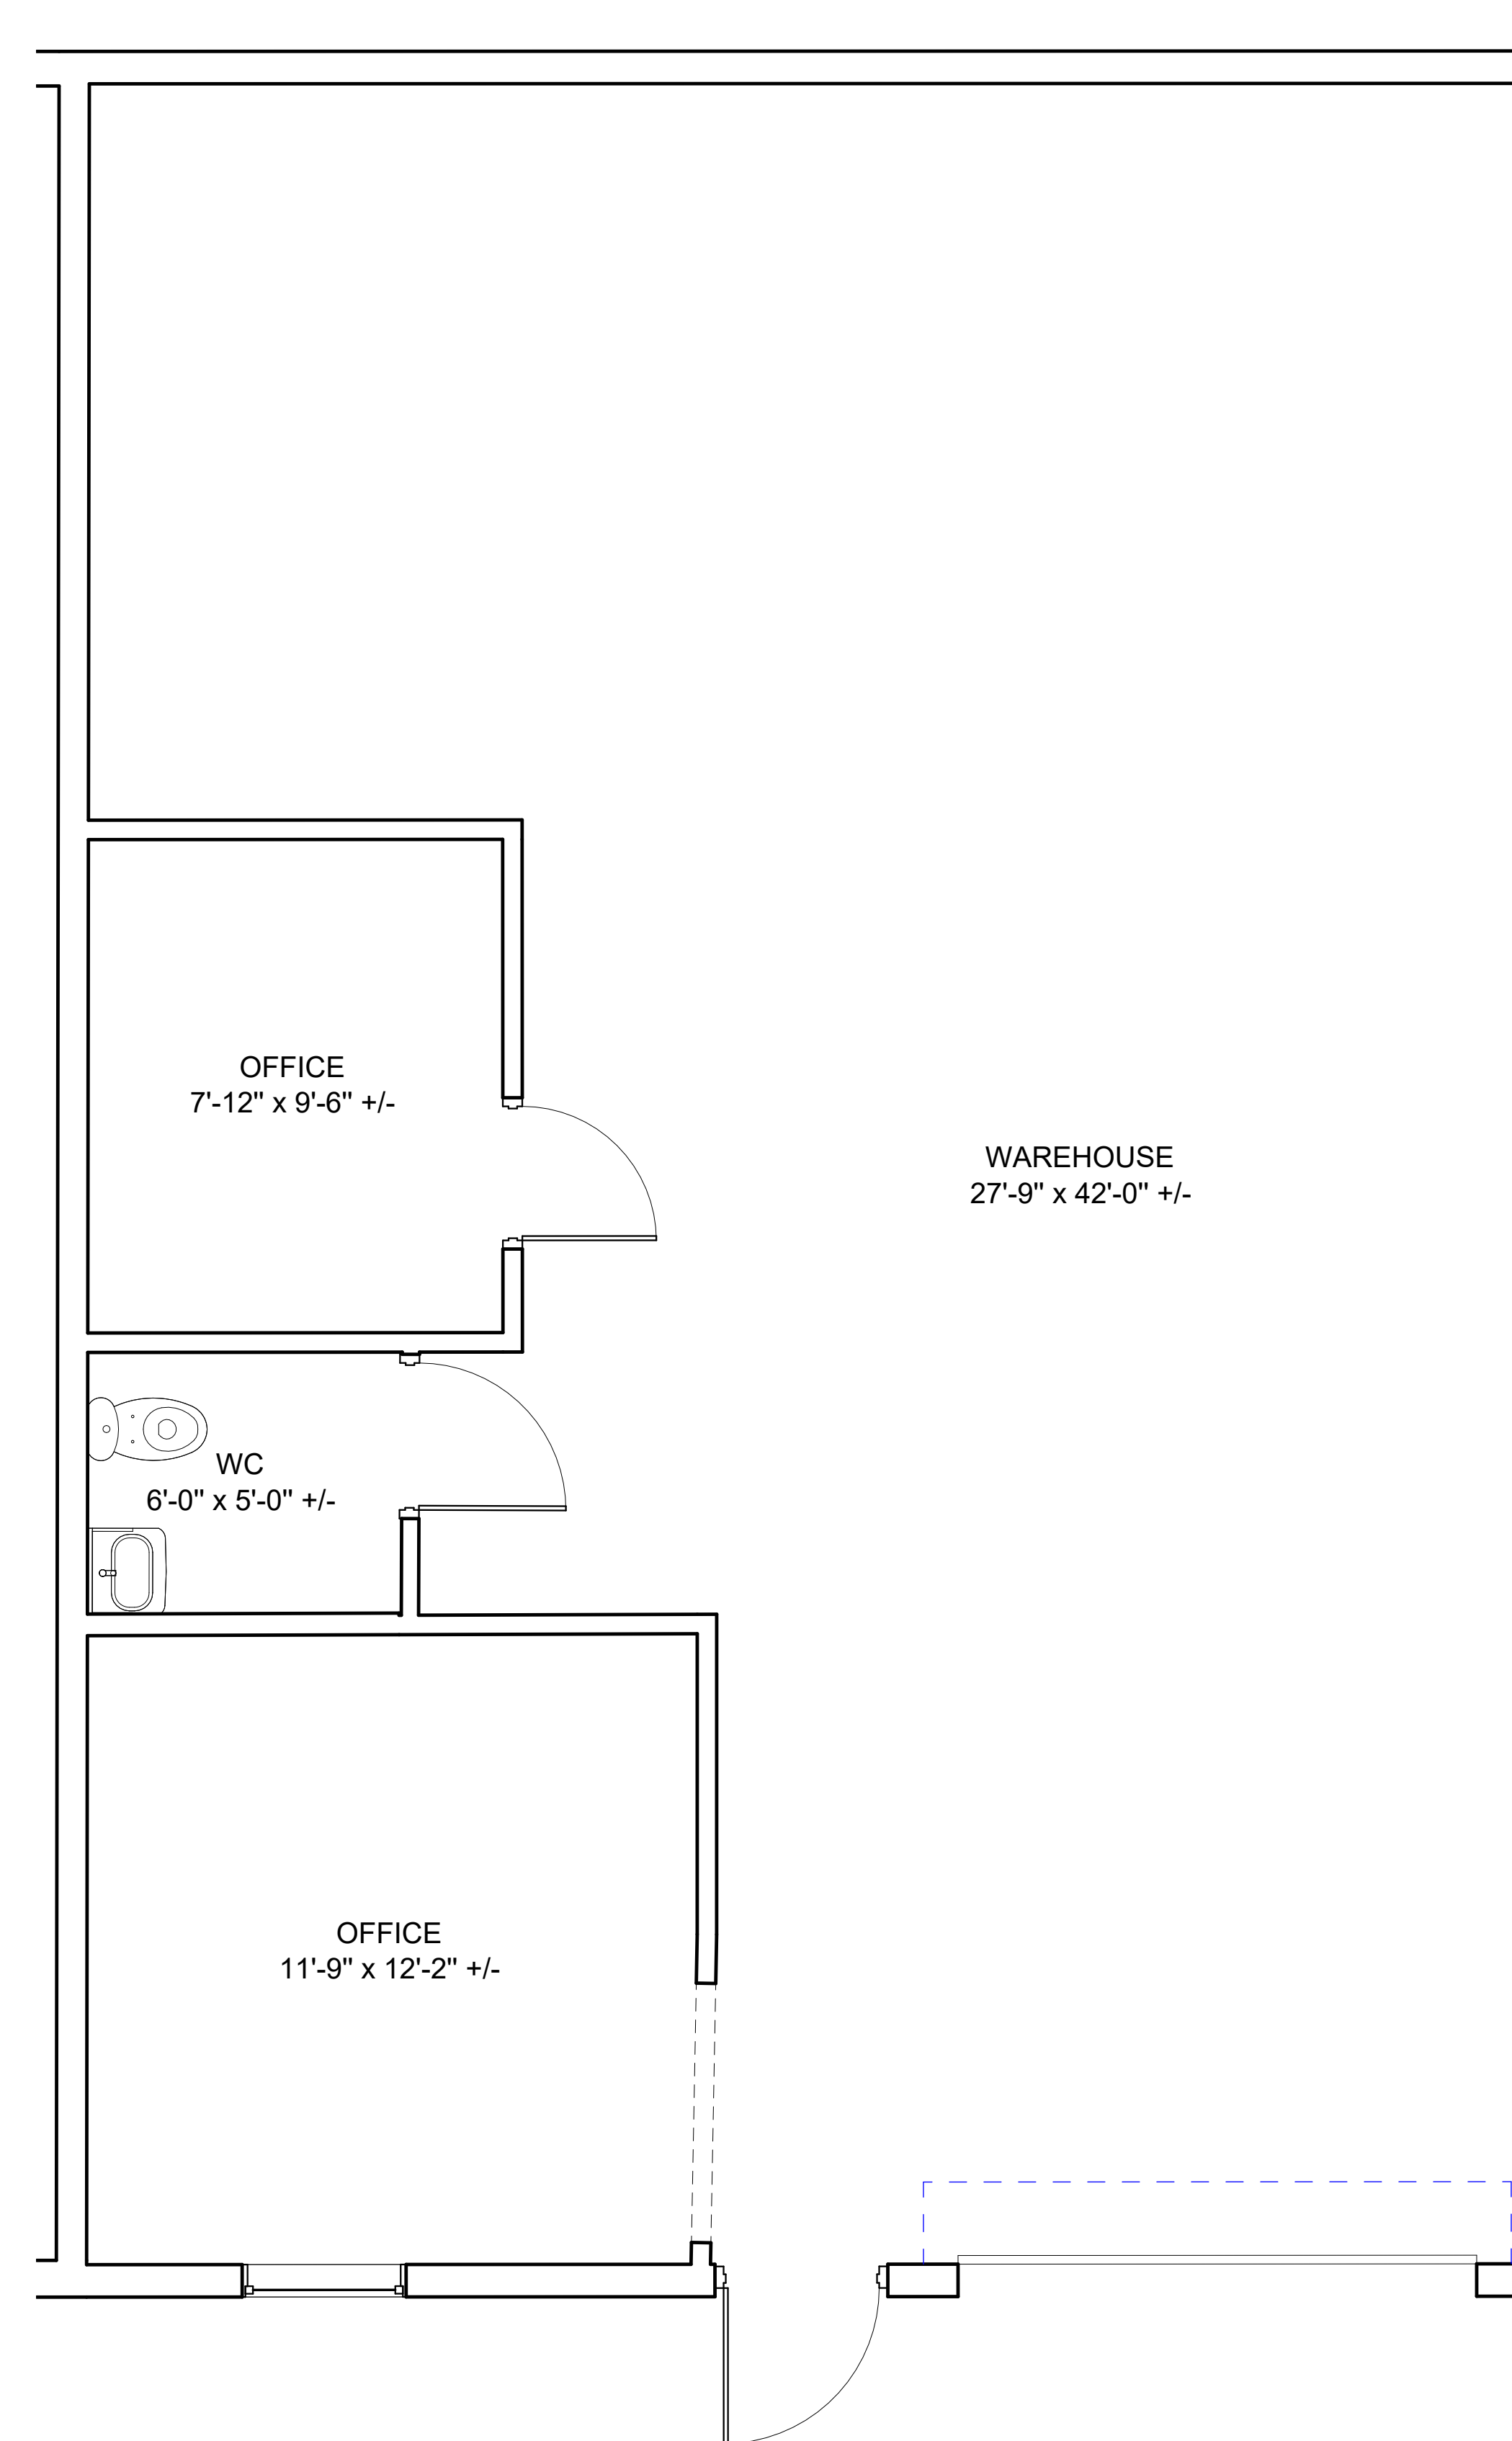

As Built Floor Plan for Marketing

