


THOMSON AVENUE (80' WIDE)


SEE MATCH LINE B-B (SEE SHIT. A-003)

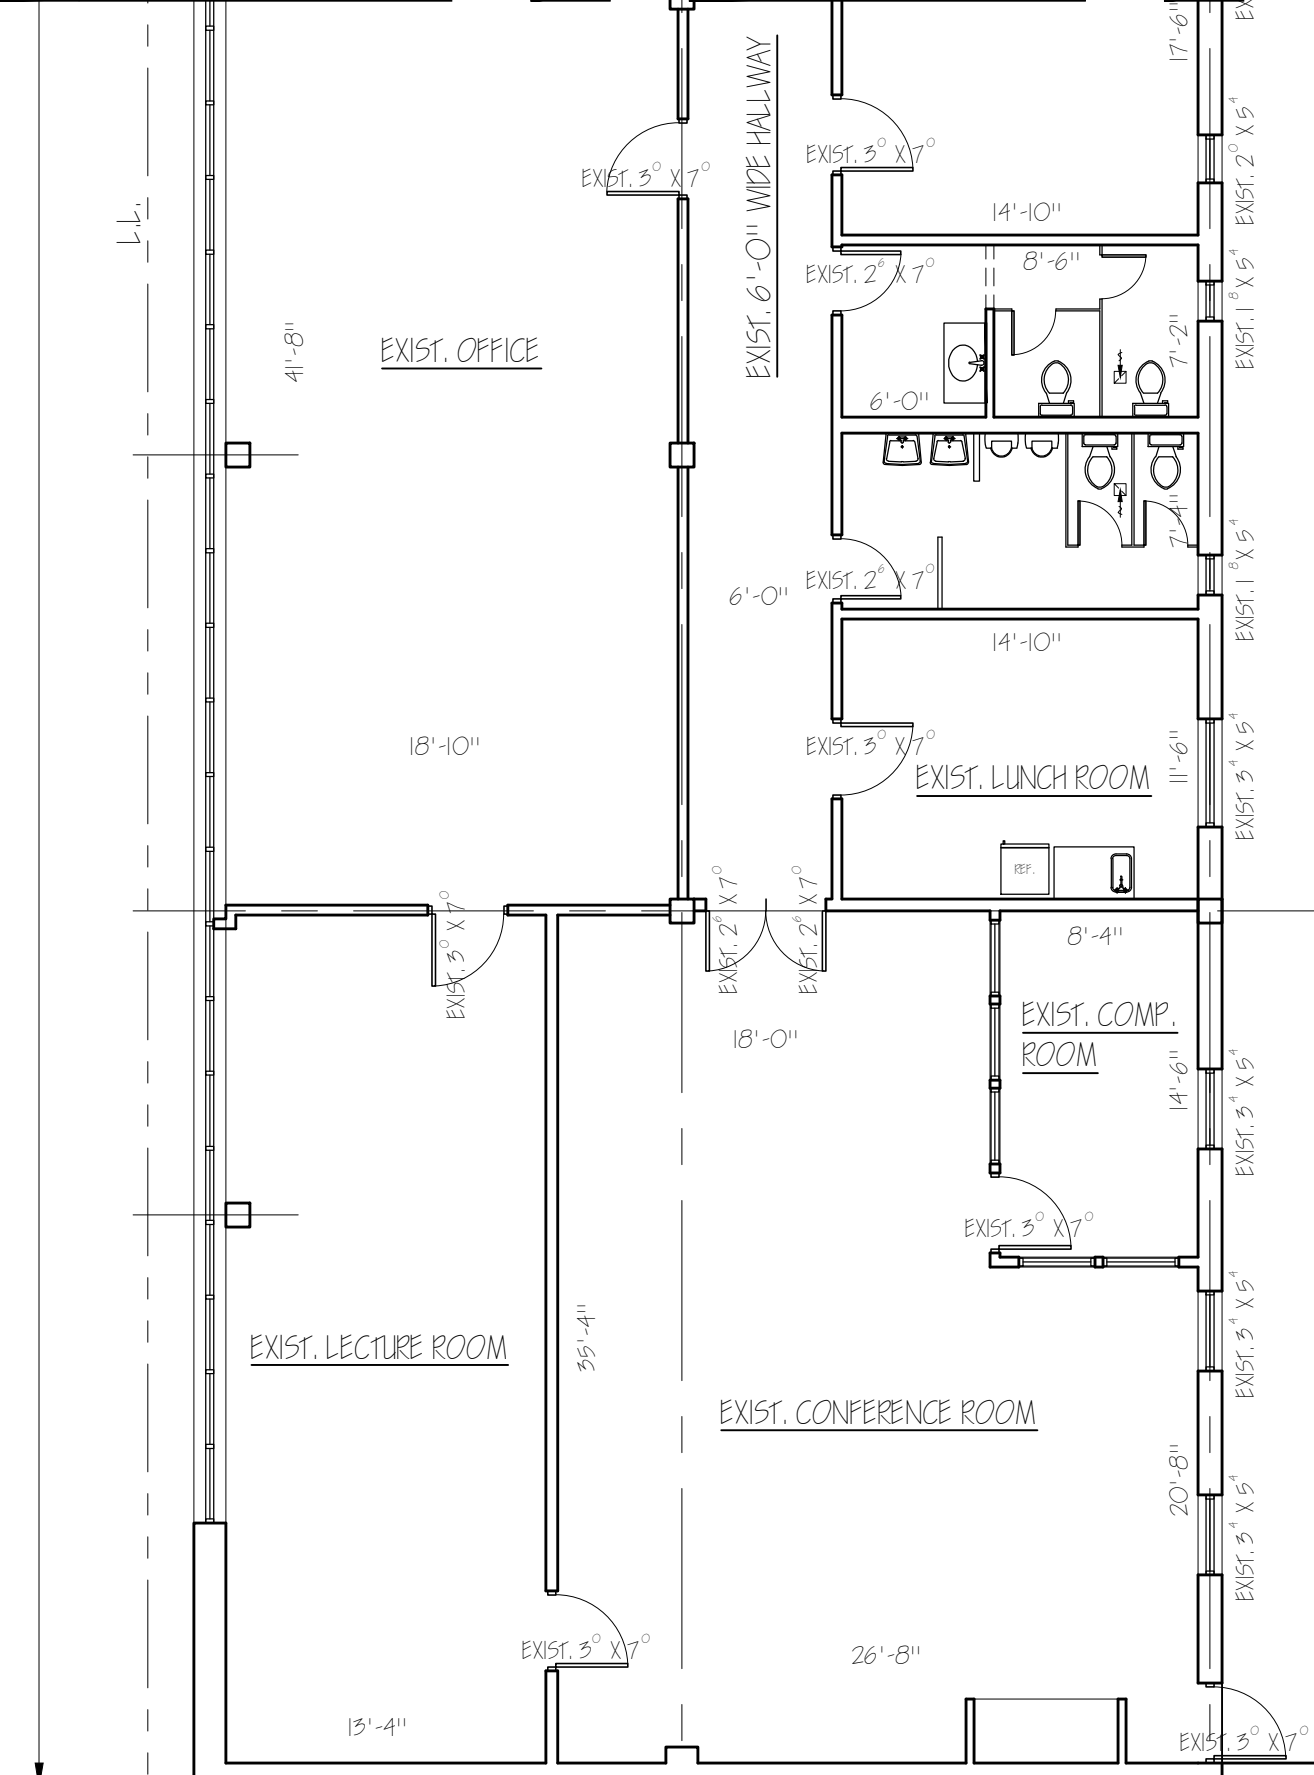


EXIST. 1ST FLOOR ROOF

EXIST. 1ST FLOOR ROOF

237'-8 3/8" ±

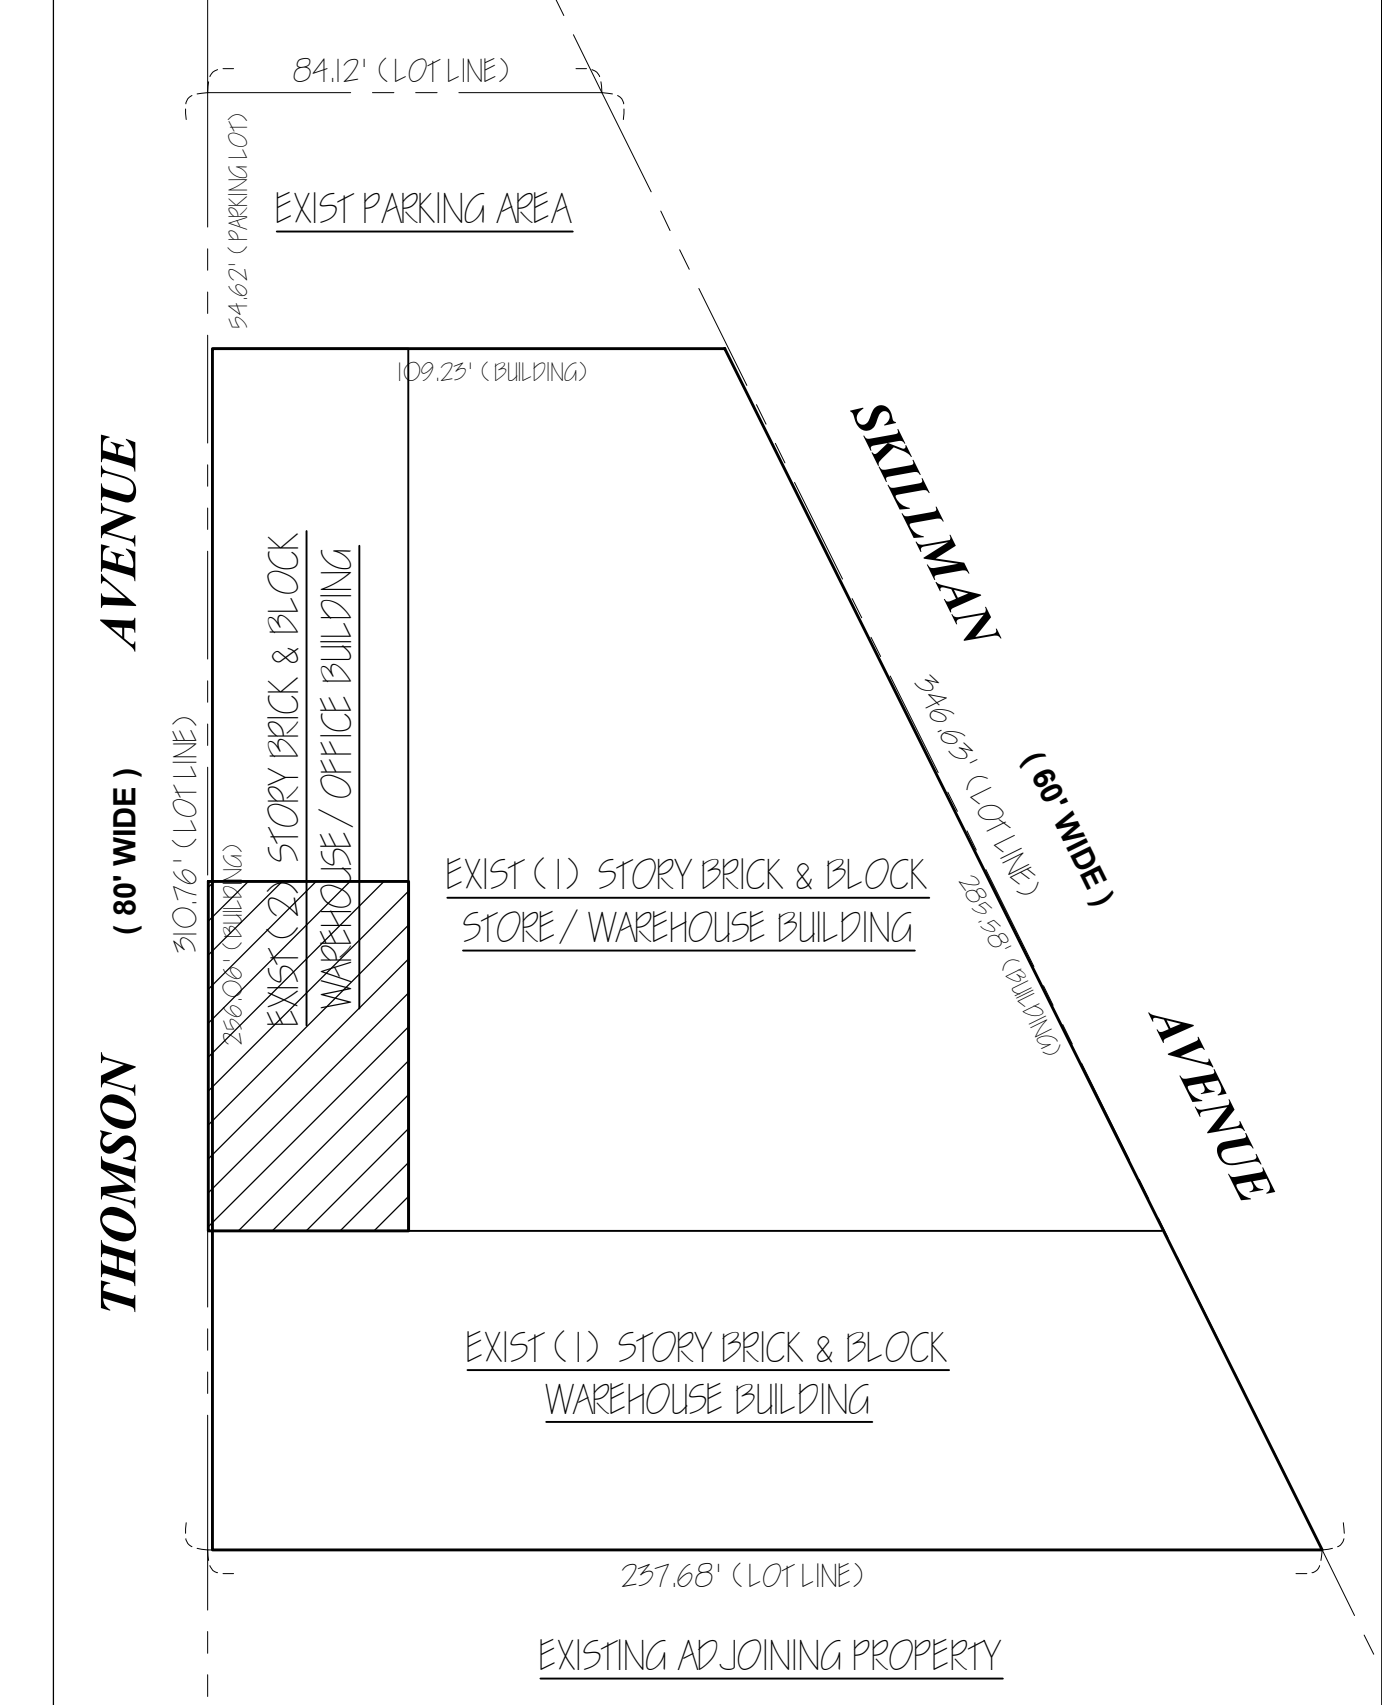


KEY PLAN

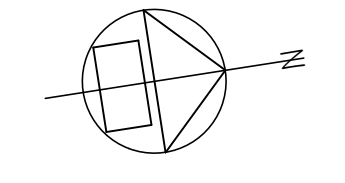

SKILLMAN AVENUE (60' WIDE)

**1** EXIST. PART 2ND FLOOR AS-BUILT PLAN  
**A-004** SCALE 1/8" = 1'-0"

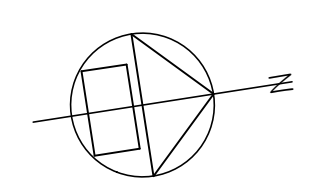

BUILDING LOCATION: <b>30-35 THOMSON AVENUE</b> L.I.C., NY 11101-3003 (CAPITOL DISTRIBUTORS, INC.)	DATE : 02/21/18 SHEET NO.: <b>A-004.00</b> SHEET 4 OF 4
--	--