


Property Key

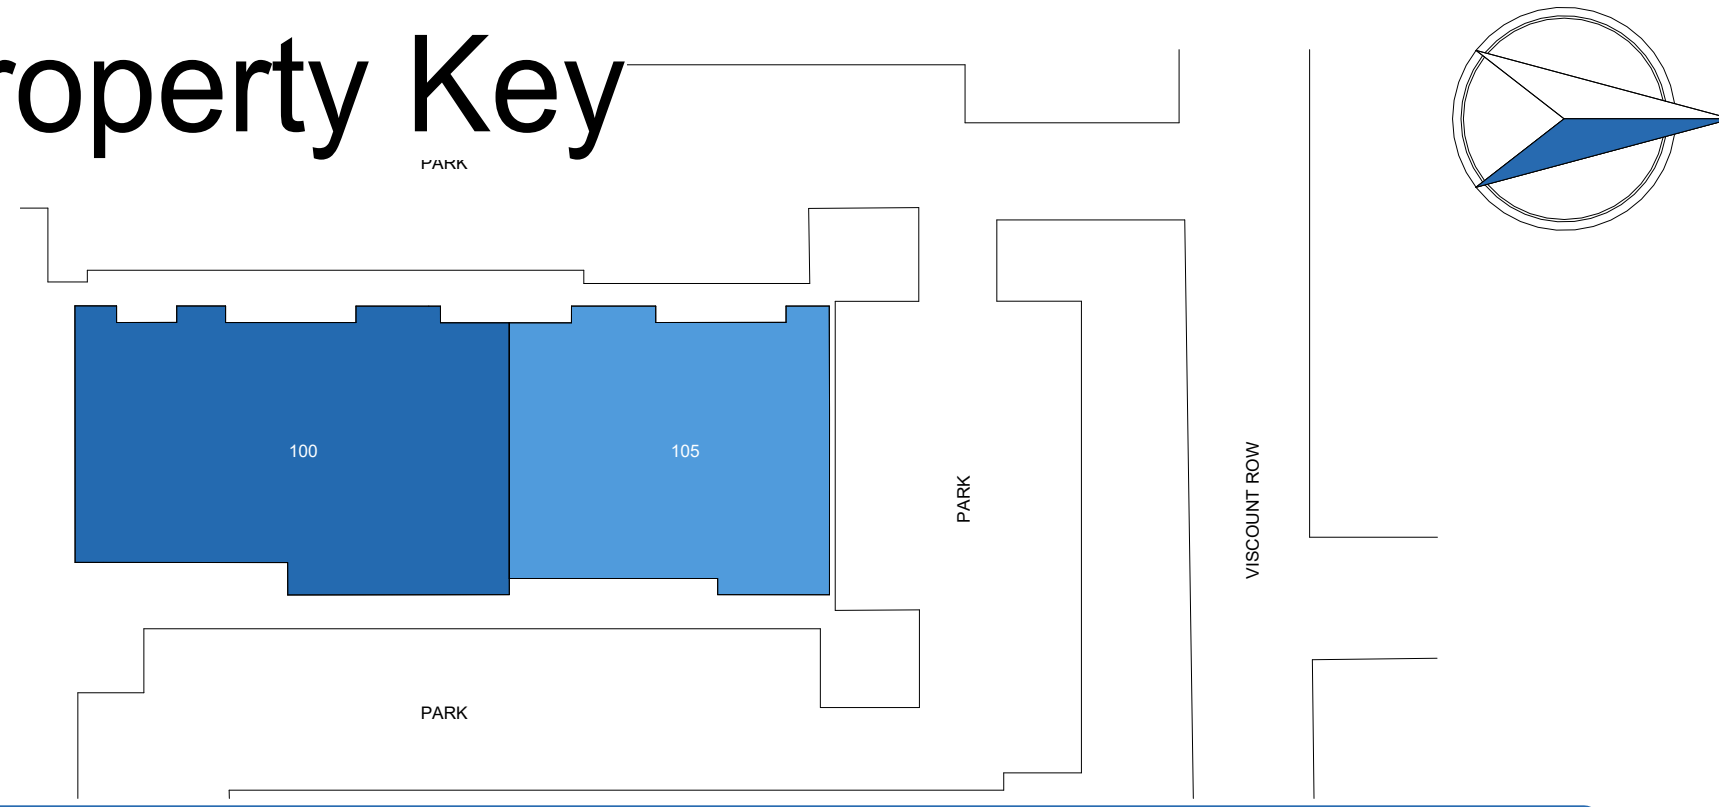

Southland As Built Marketing Package


7550 Southland Blvd, Orlando, FL 32809, US

Building: 7550

Suite: 100

Sheet **E1**

Scale: Not to Scale
Sheet Size: 42" x 30"
Not For Construction

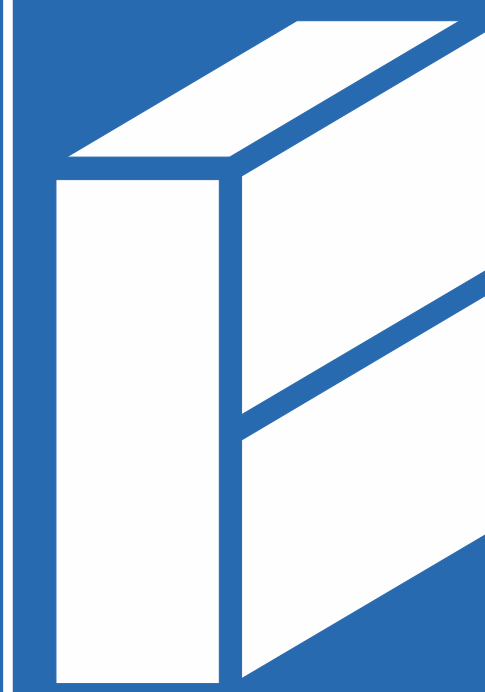


BAY SPACE

Usable Square Foot Analysis

Office Area	8,215	100 %
Warehouse Area	0	0%
Total Area	8,215	

Building Information

Deck Height:	N/A	
Clear Height:	8' - 6"	
Ceiling Height:	8' - 6"	
Sprinklered:	<input type="checkbox"/> Yes	<input checked="" type="checkbox"/> No
Mechanical Area:	0 SQFT	

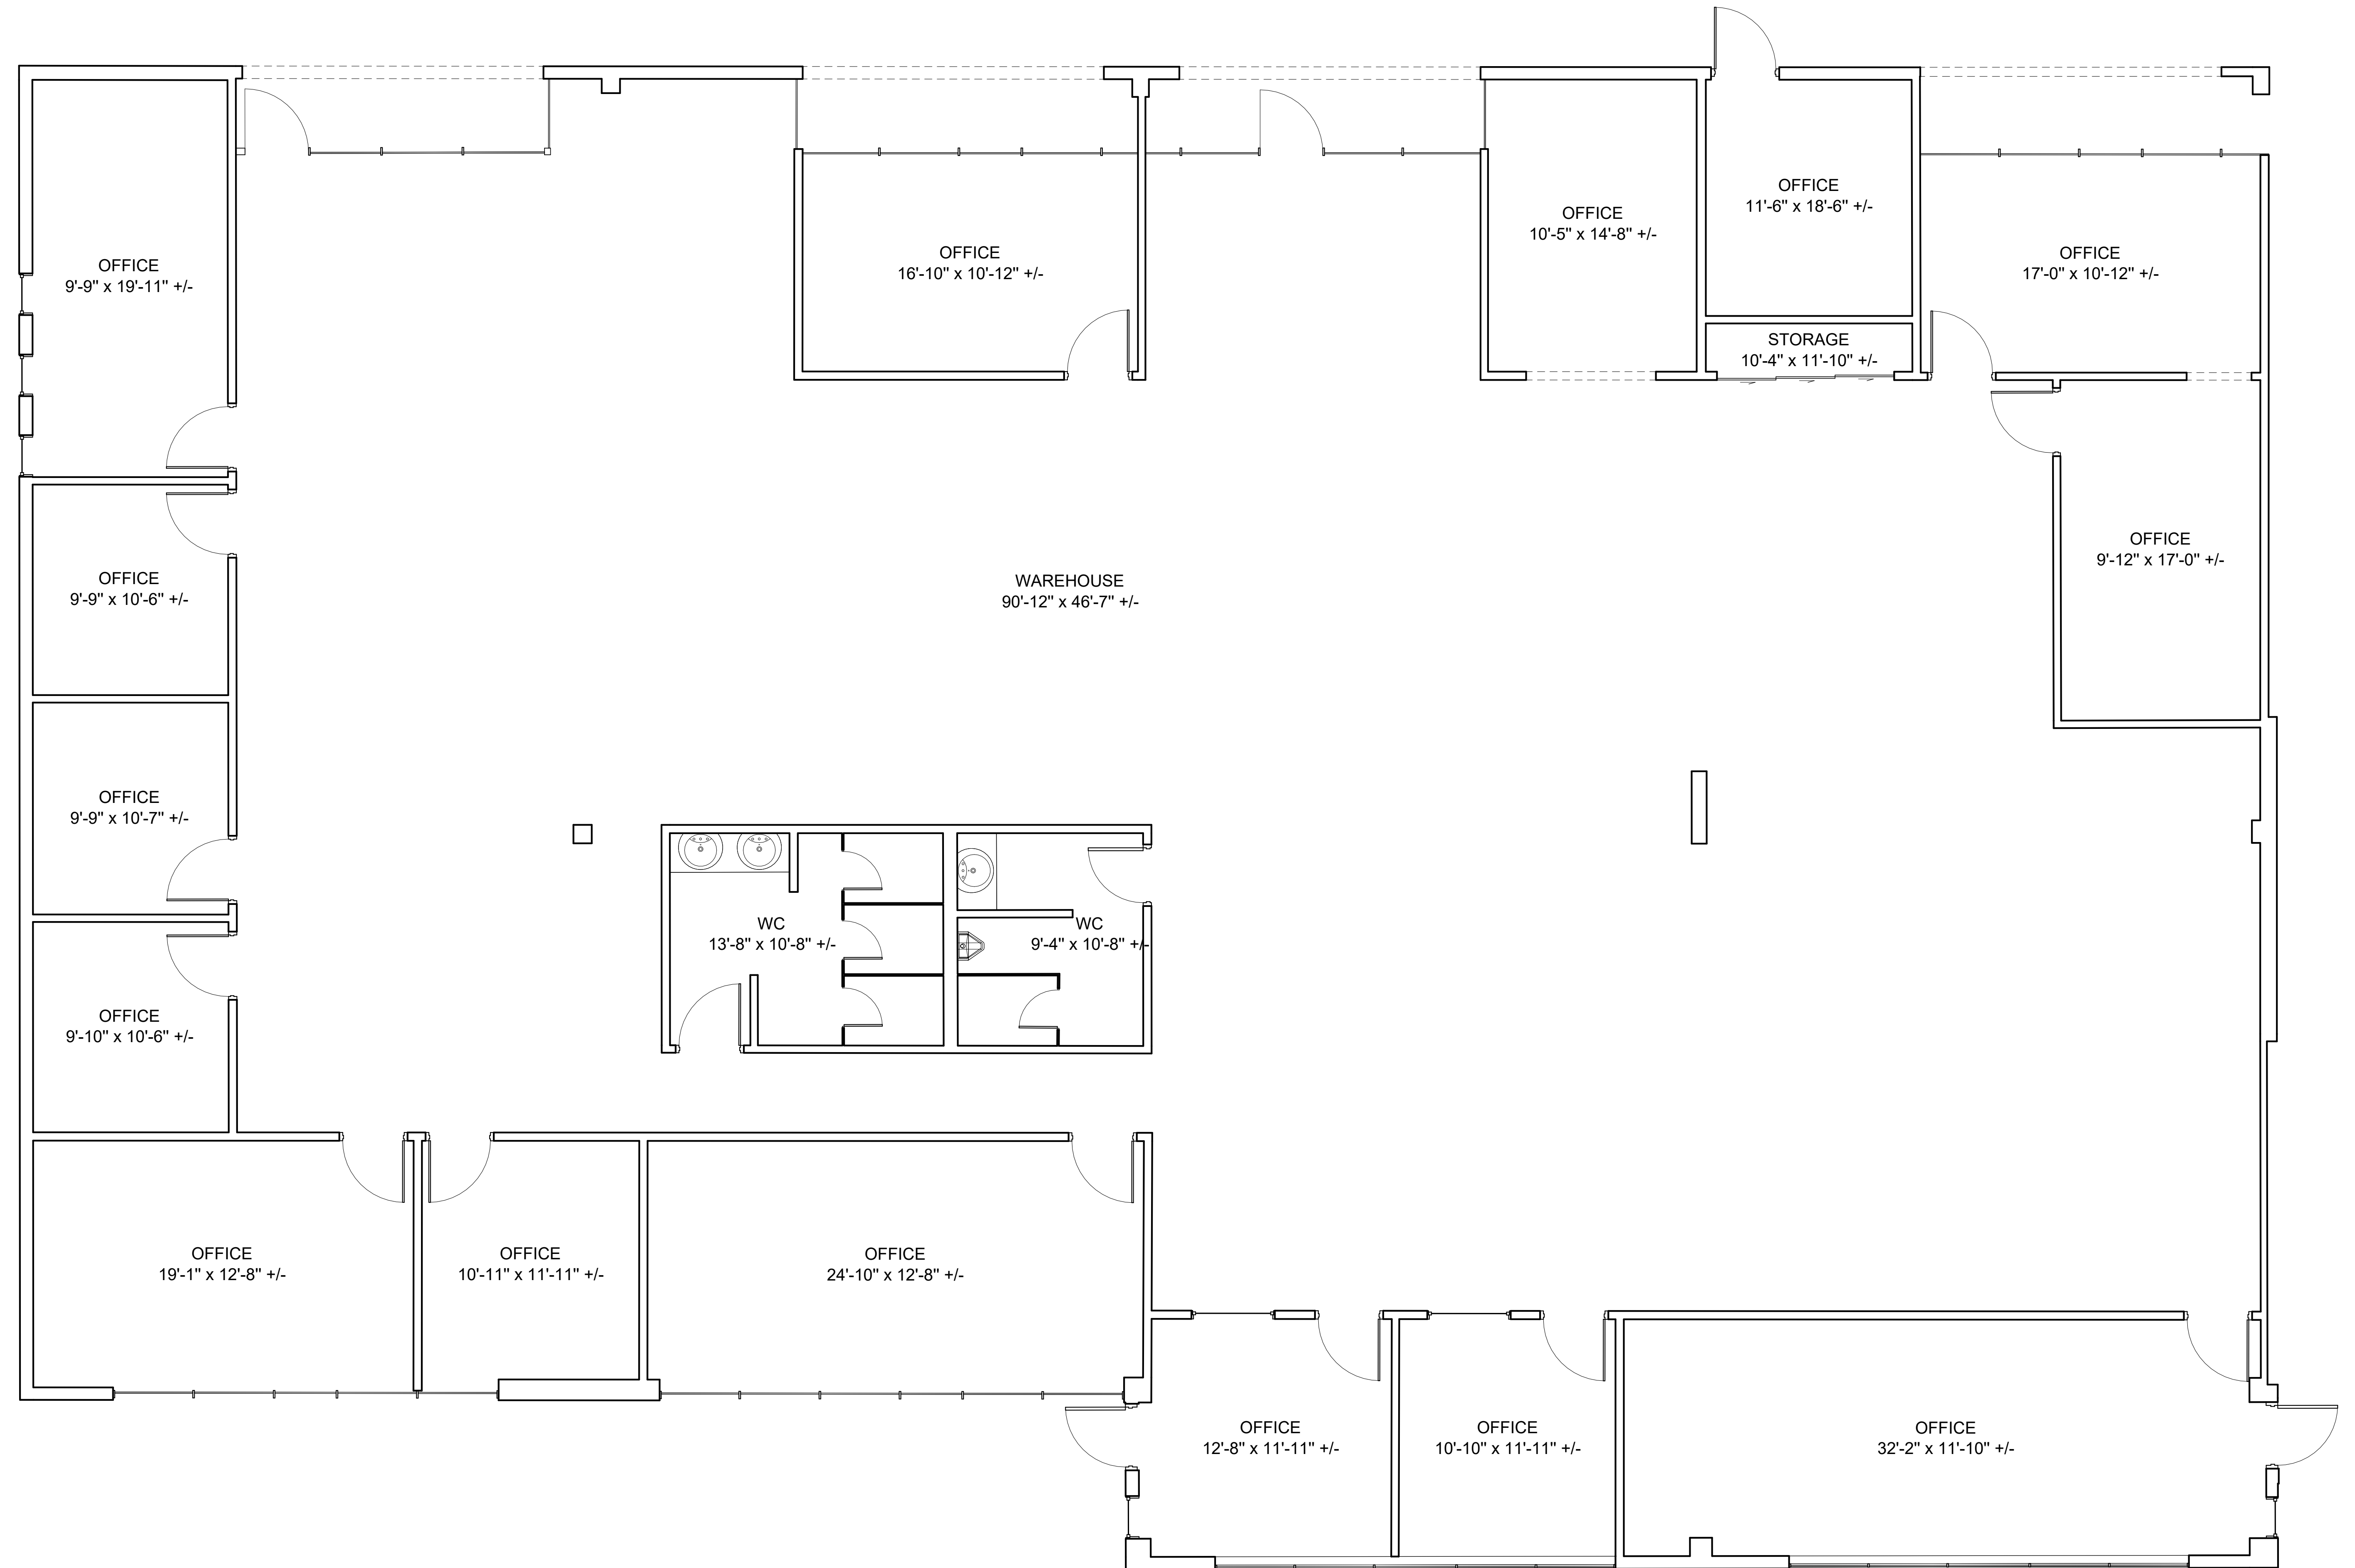

① 100
1/4" = 1'-0"

As Built Floor Plan for Marketing

