


1 TENANT PLAN  
A-3 1/8"=1'-0"

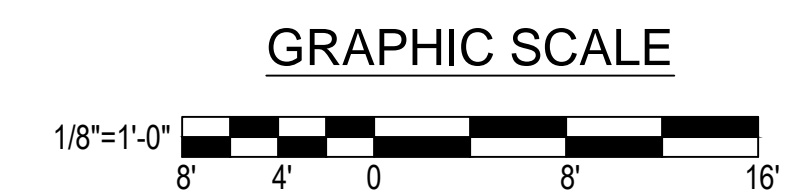

CAUTION: IF THIS DRAWING IS A REDUCTION,  
GRAPHIC SCALE MUST BE USED.

TENANT LAYOUT  
**THE TACK FACTORY**  
1300 BANK STREET  
THIRD FLOOR  
BALTIMORE, MD 21231

ISSUED  
DECEMBER 21, 2018

REVISED  
-

DRAWING TITLE  
TENANT PLAN

SHEET

**A-3**