


SAN PABLO AVE



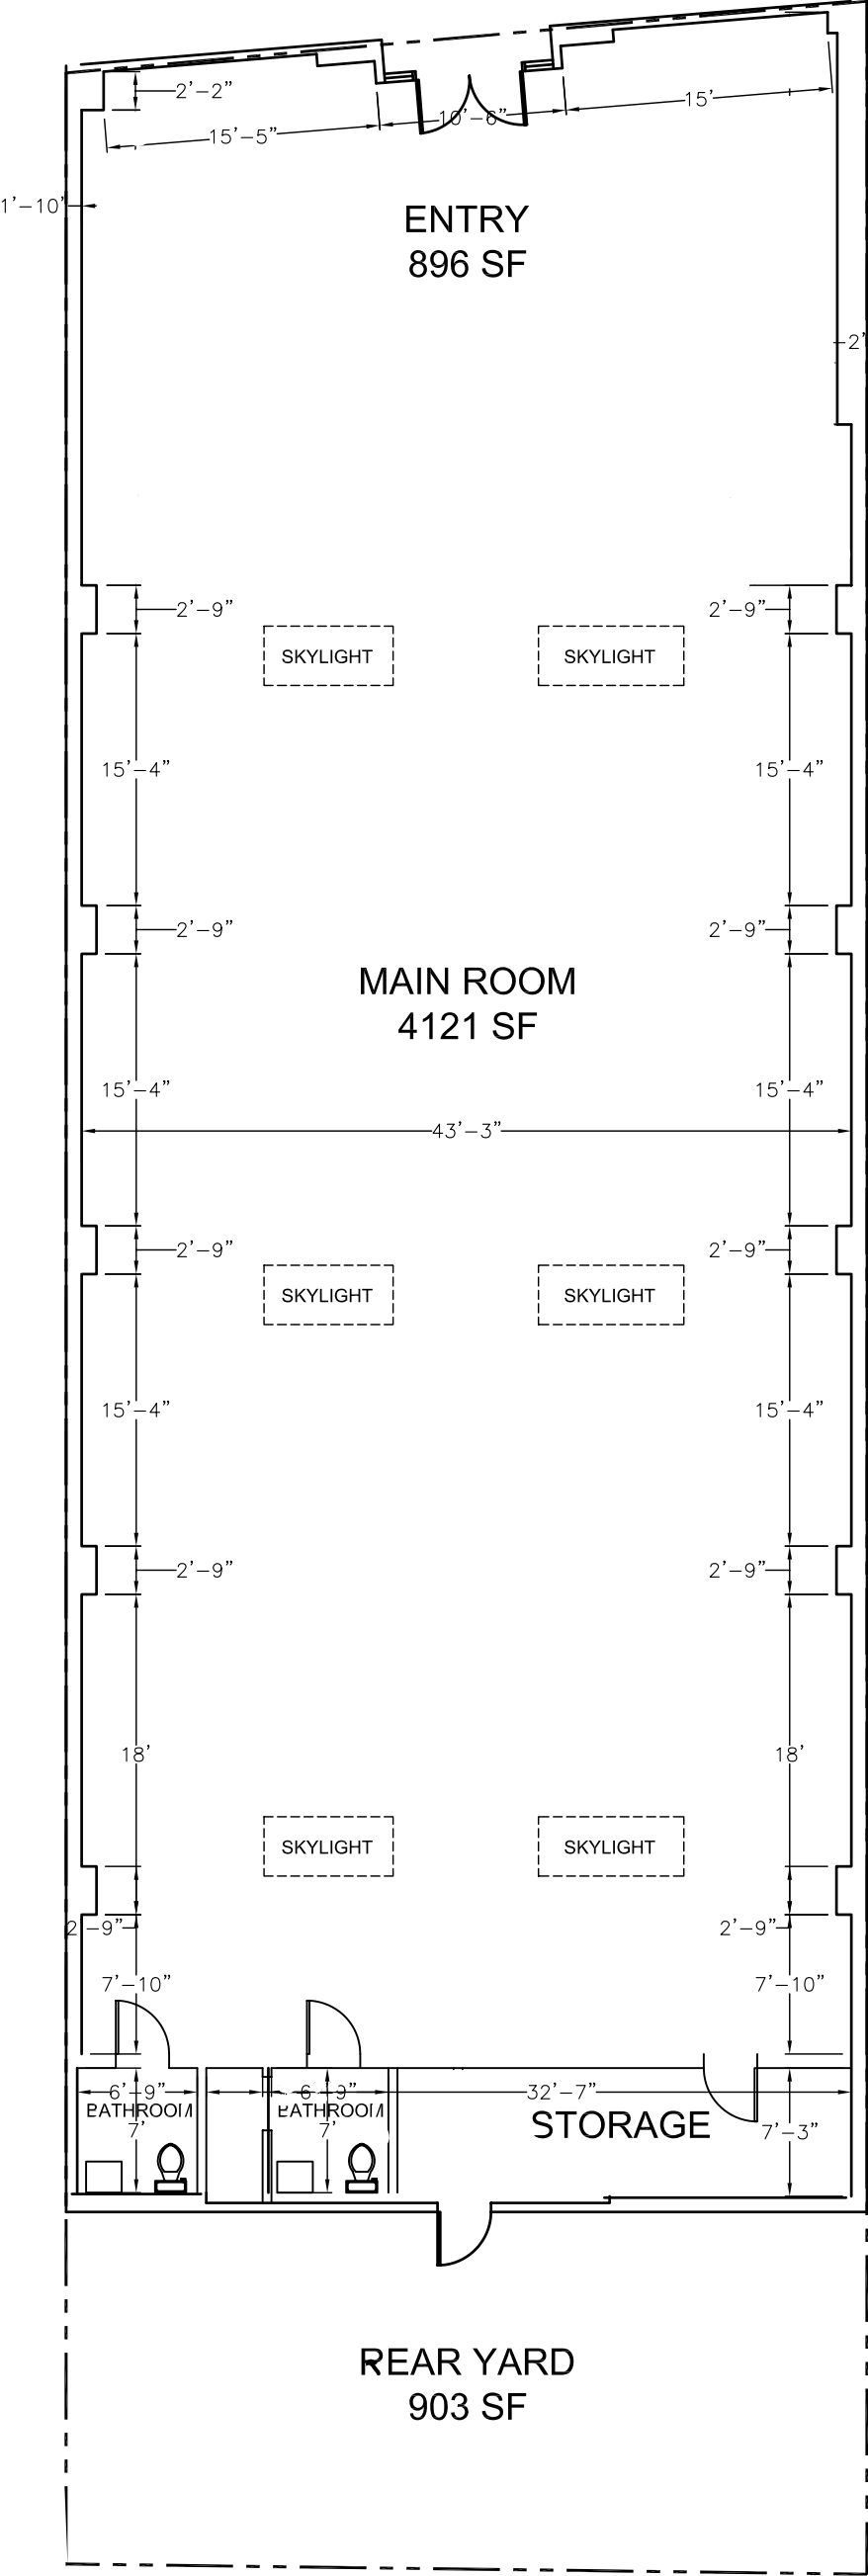

AMATO
ARCHITECTURE

1396 PARK AVENUE
EMERYVILLE CA, 94608

TELE 510.420.0210
CELL 510.499.2080

2009 SAN PABLO AVE COMMERCIAL SPACE

AS-BUILT EXISTING CONDITIONS
3/32"=1'-0"