


**TOTAL SF AVAILABLE - 9,305 SF**


OFFICE - 1,930 SF

WAREHOUSE SF - 7,375 SF

[Click to access CADD file](#)

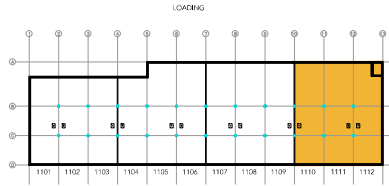

Key Plan

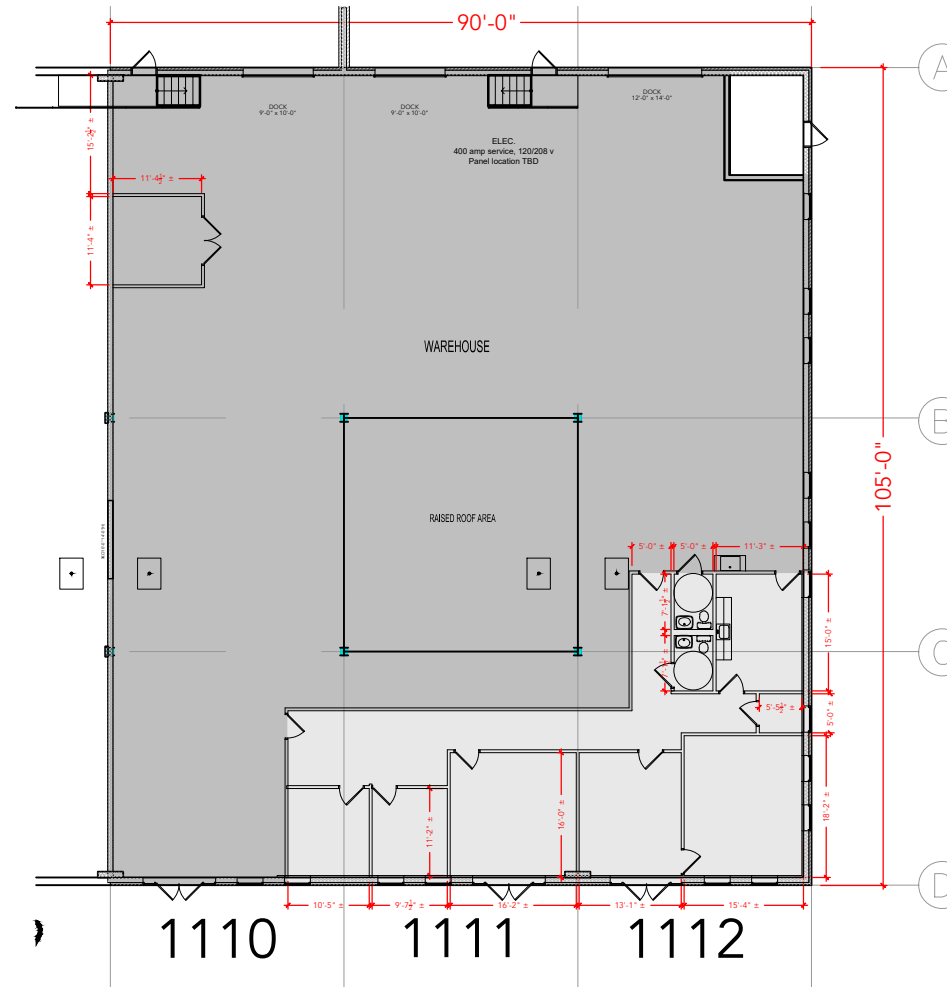

Floor Plan