



119 W. MAIN STREET
NORMAN, OK 73069
405.579.7800
FAX 405.292.0500

STRUCTURAL CONSULTANT:
Structural Engineer
Address (#1)
Address (#2)
PHONE: (000)000-0000
FAX: (000)000-0000

MECHANICAL CONSULTANT:
Mechanical Engineer
Address (#1)
Address (#2)
PHONE: (000)000-0000
FAX: (000)000-0000

ELECTRICAL CONSULTANT:
Electrical Engineer
Address (#1)
Address (#2)
PHONE: (000)000-0000
FAX: (000)000-0000

BLUESCAPE
500 E ROBINSON
NORMAN OK 73071
PROJTITLELINE#4

AS-BUILT
05.14.2026

[illegible]

PRIMARY ISSUE		
MARK	DATE	DESCRIPTION
#	00-00-00	PERMIT ISSU
#	00-00-00	BID ISSUE
#	00-00-00	CONST. ISSU

NOT FOR
CONSTRUCTION

THESE DRAWINGS ARE PROVIDED FOR APPROVAL OR REVIEW PURPOSES ONLY AND DO NOT IN ANY WAY CONSTITUTE A CONSTRUCTION DOCUMENT SET; AND SUCH, THESE DRAWINGS MAY NOT BE INCORPORATED INTO ANY SET OF DRAWINGS USED FOR CONSTRUCTION.



JOB NO.: K2023

DRAWN BY	CHECKED BY
CFC	MLK

SHEET TITLE:
FIRST
FLOOR PLAN
SUITE 1300

SHEET NO.:

A201

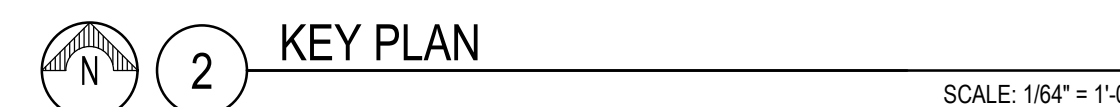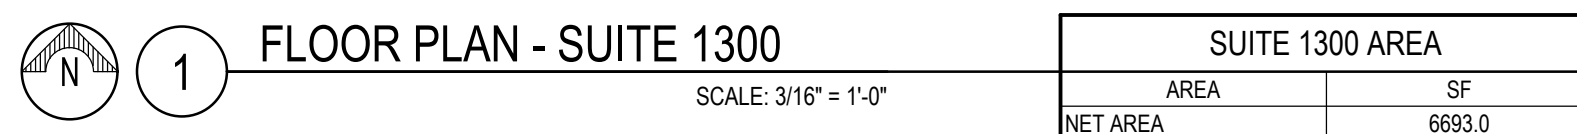

\\Z:\ARCHIVED PROJECTS\BLUESCAPE ALTERAN NORMAN-DOCTORS PARK_K\2023\DRAWING FLESS\SUITE 1300.DWG
Tuesday, May 14, 2026 4:23:58 PM