




E 2,870 SF
CHURCH

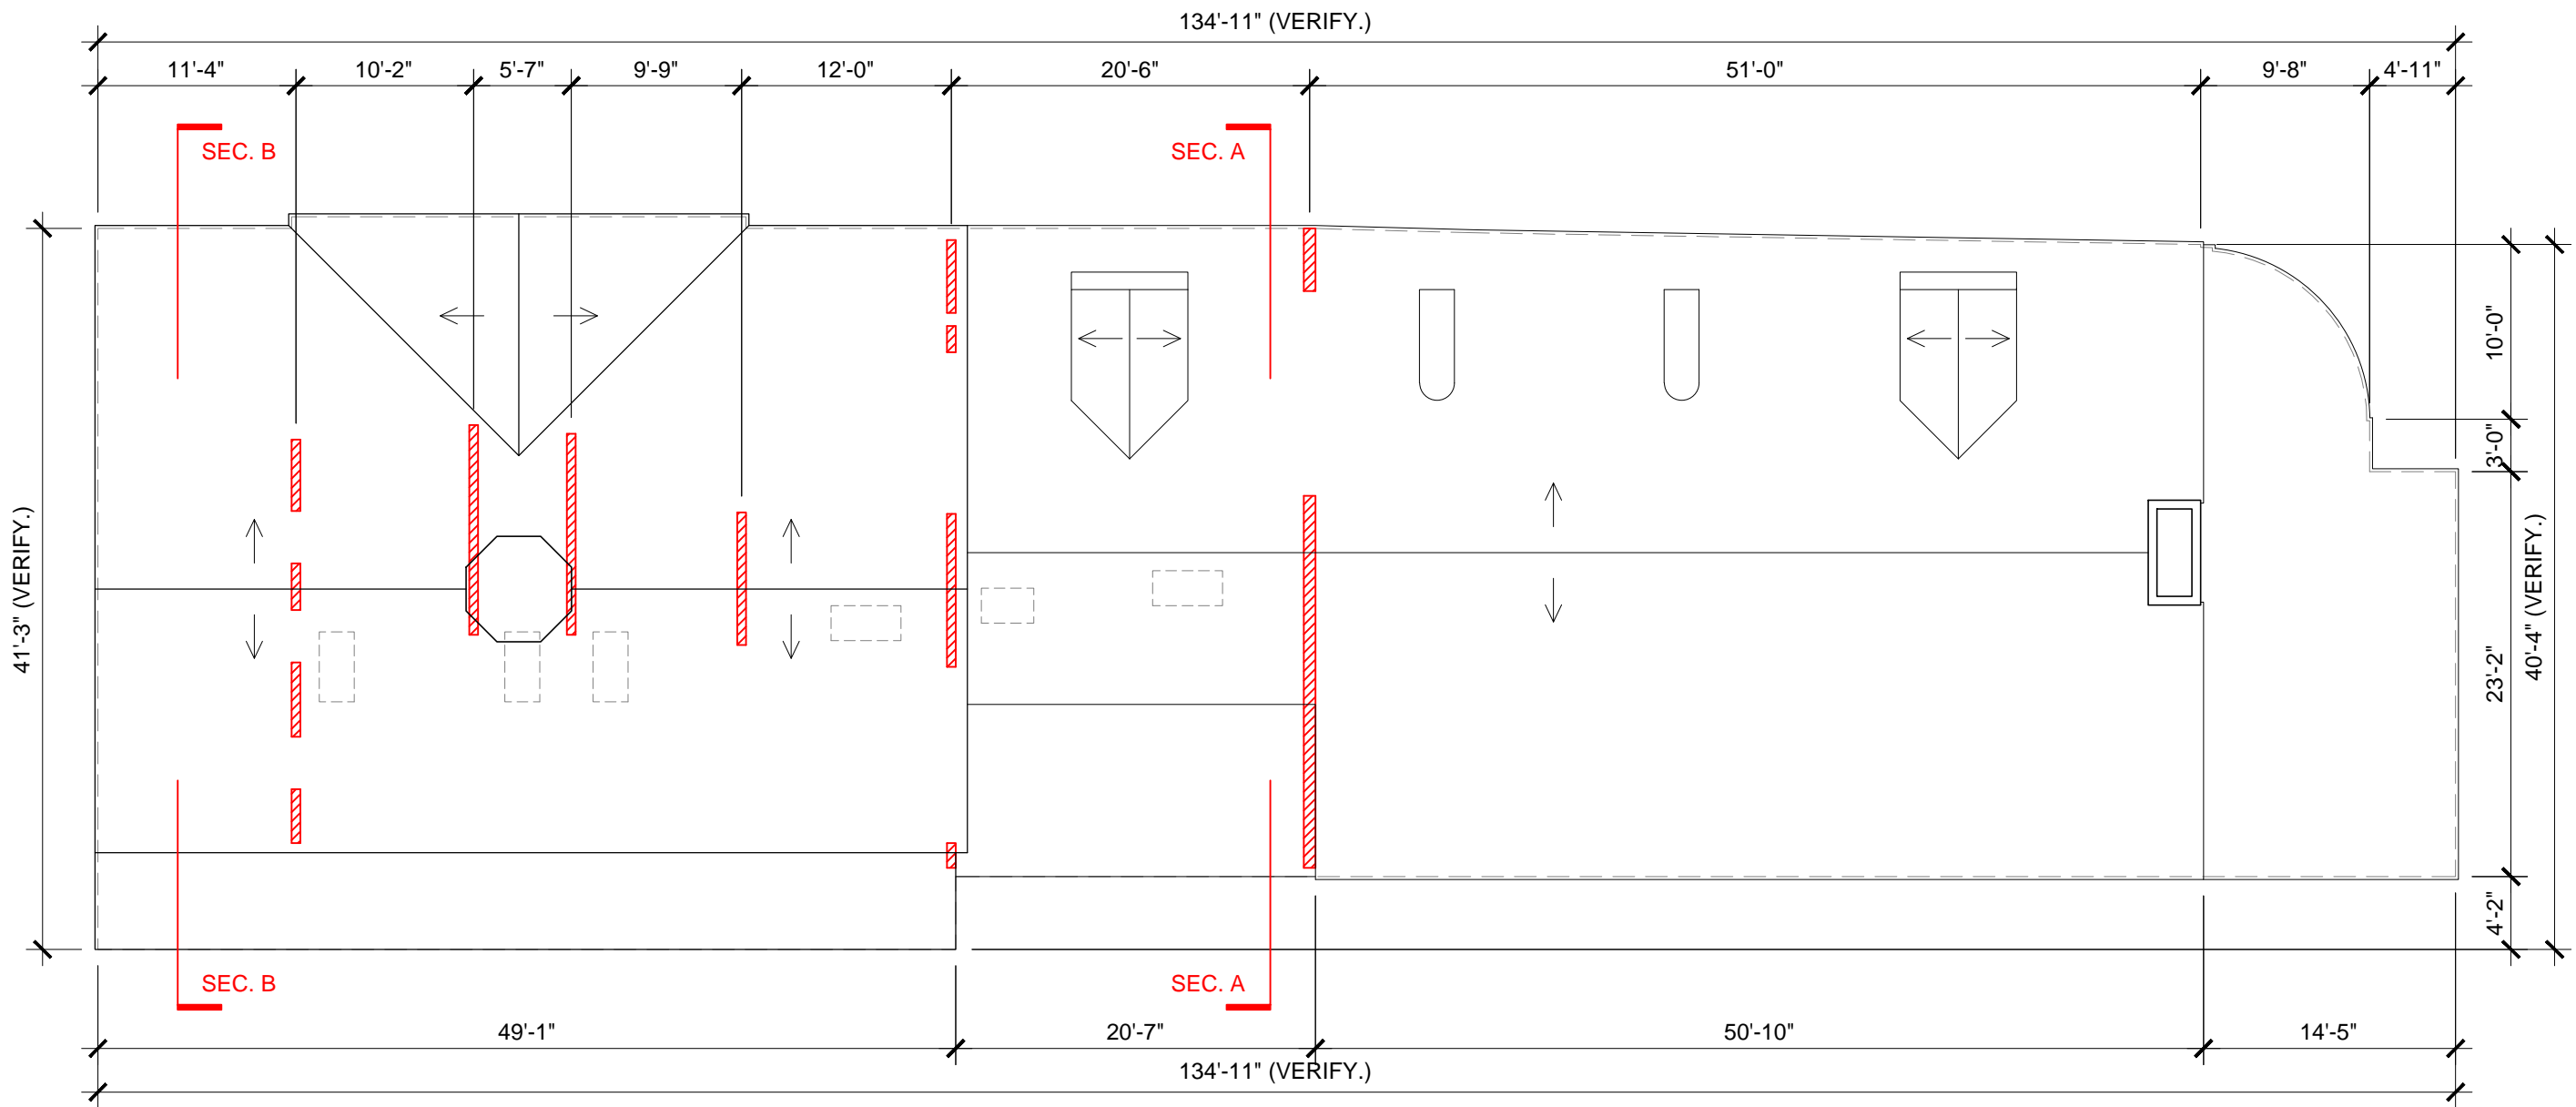

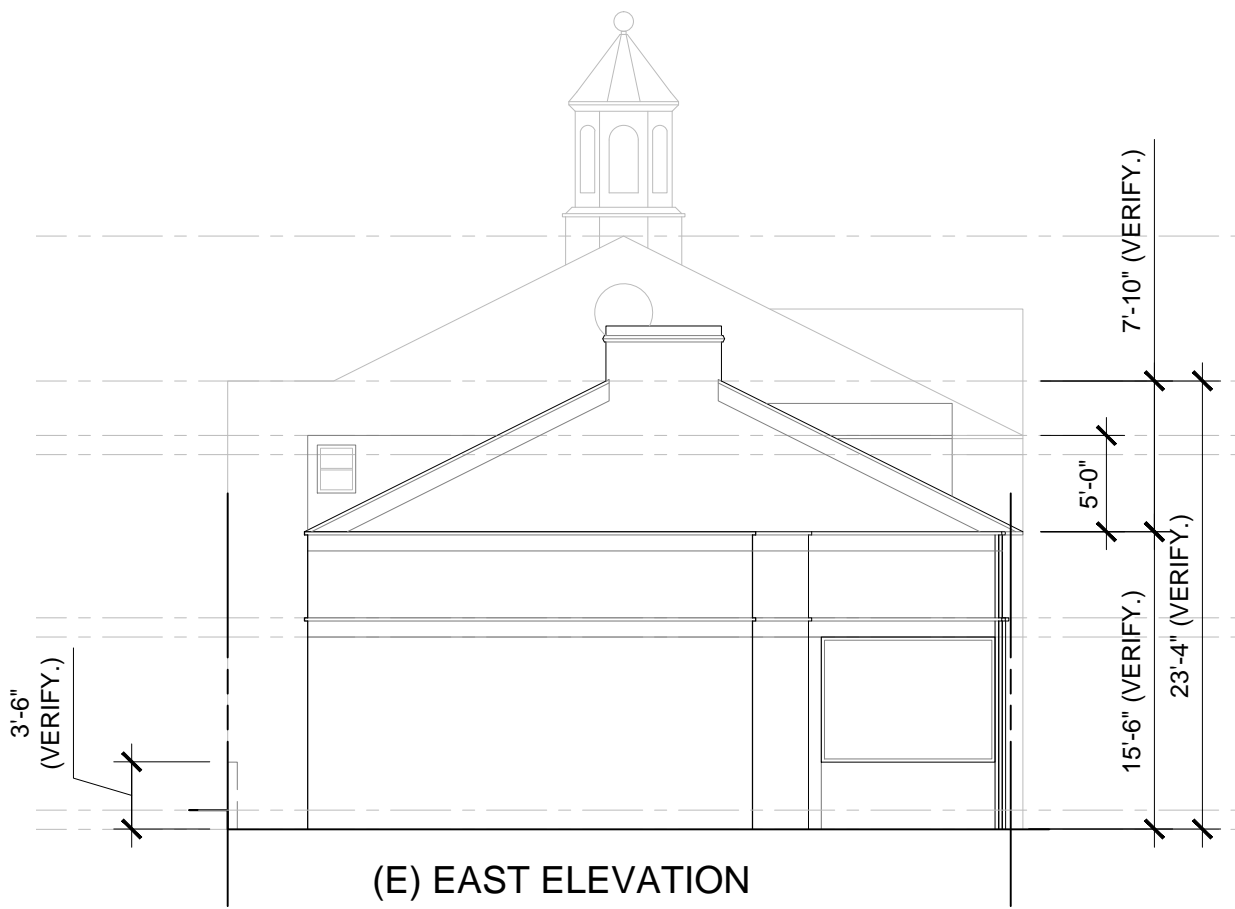

(E) EAST ELEVATION

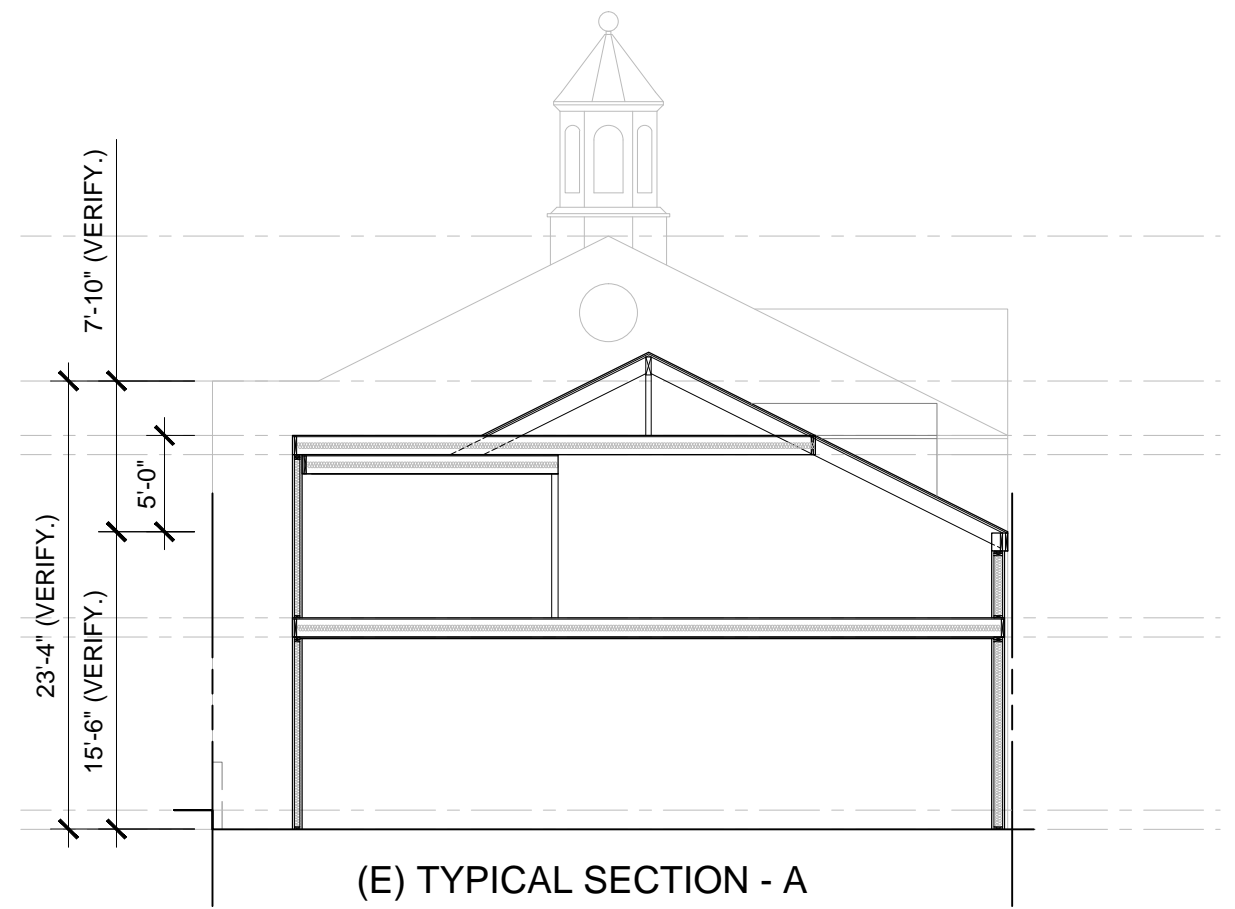


(E) TYPICAL SECTION - A




(E) NORTH ELEVATION



(E) WEST ELEVATION

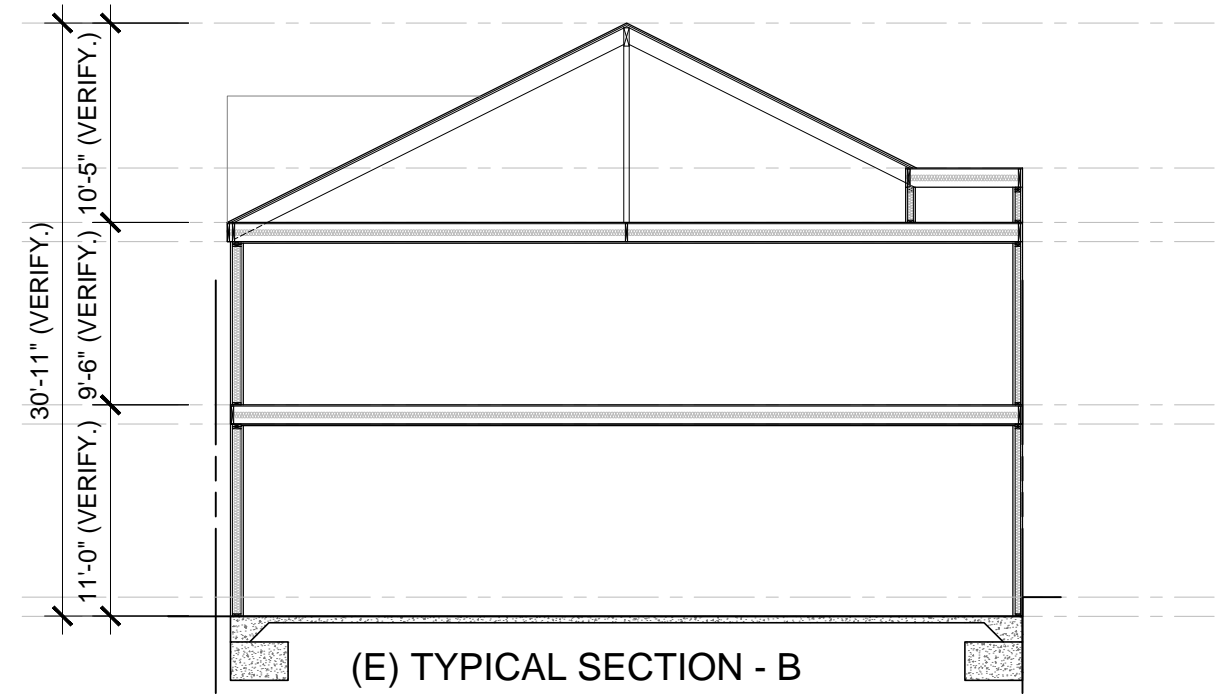

(E) TYPICAL SECTION - B

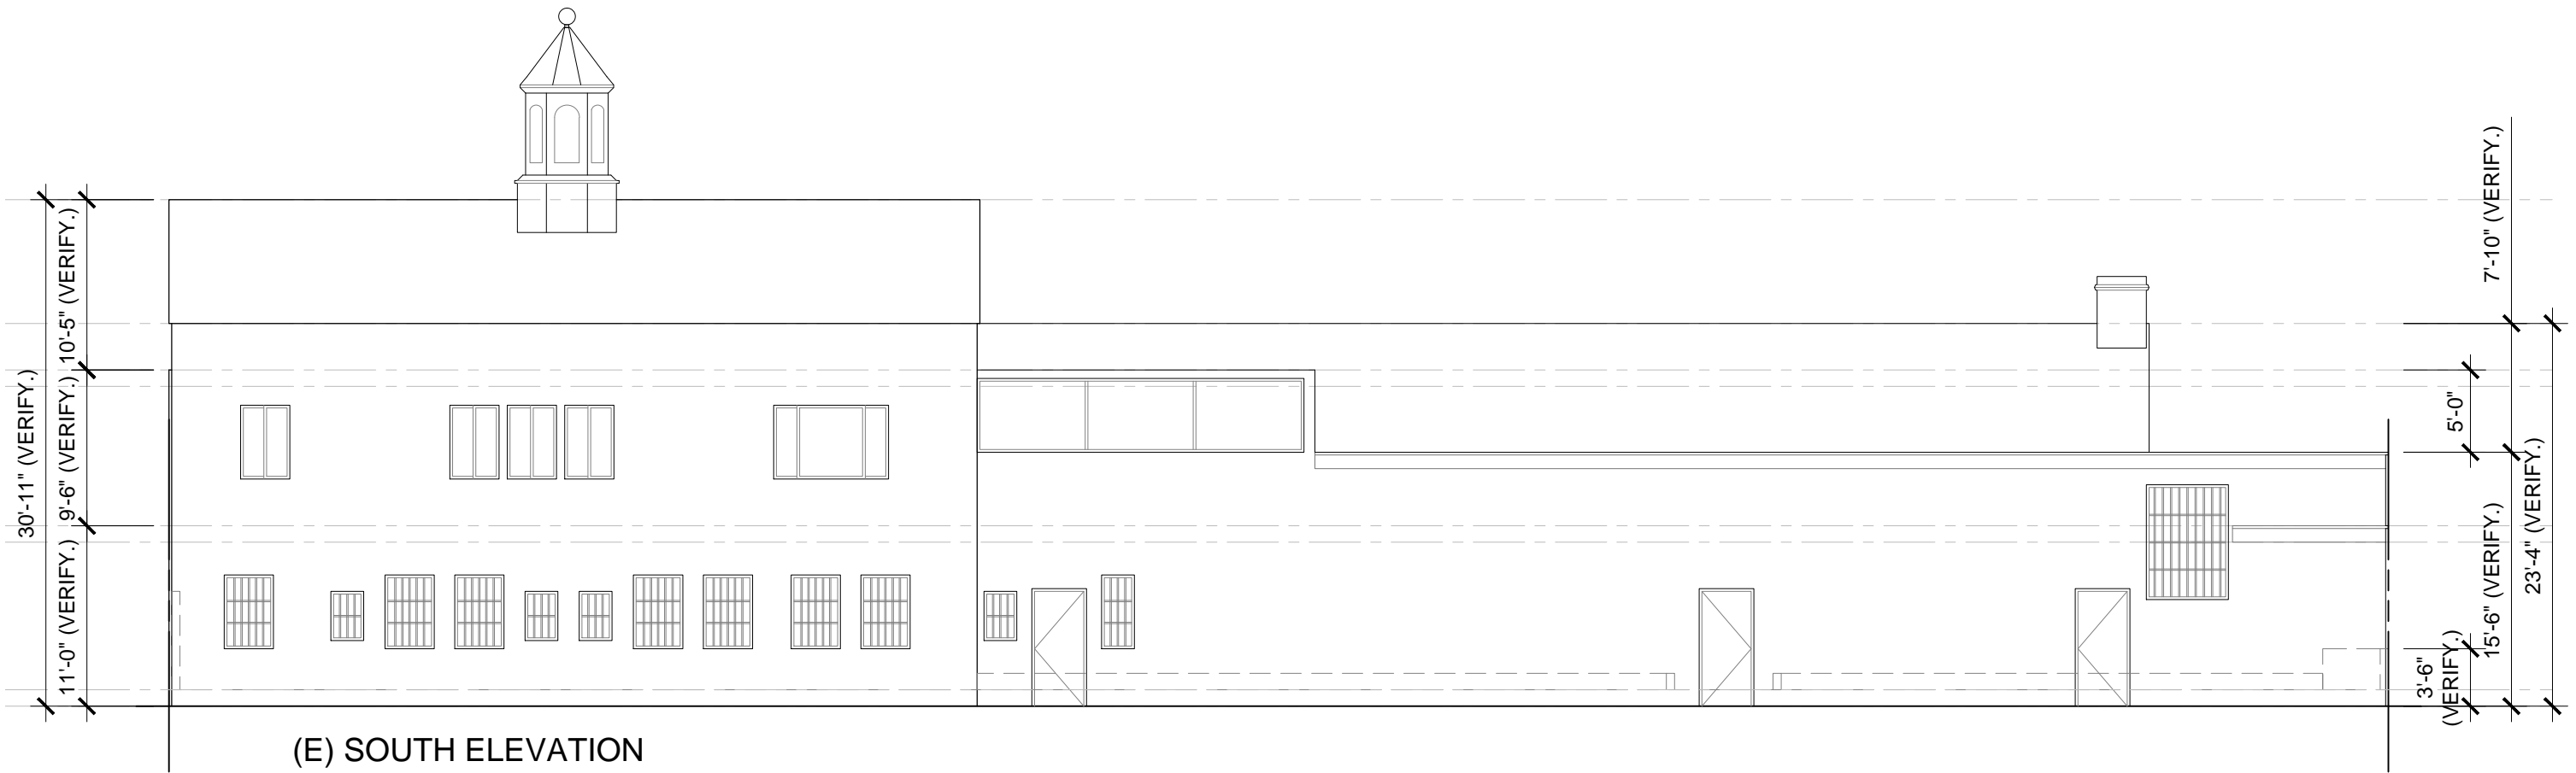

(E) SOUTH ELEVATION