



TOTAL SF AVAILABLE - 4,410 SF

OFFICE - 2,571 SF
WAREHOUSE - 1,839 SF

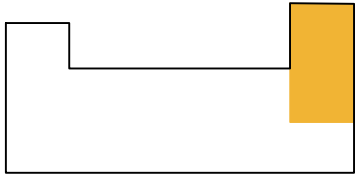

Key Plan

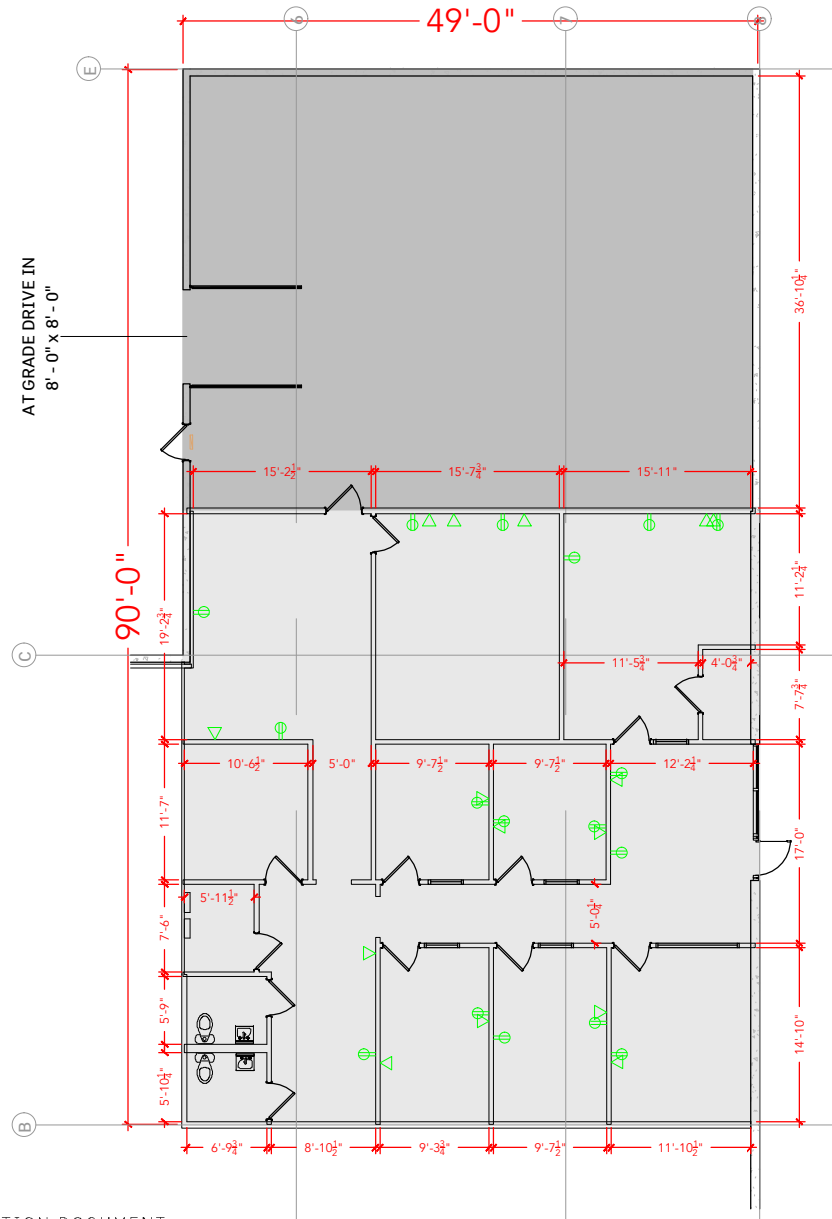

Floor Plan

PLAN NOT TO SCALE - THIS IS NOT A CONSTRUCTION DOCUMENT

DRAWING #: JAMP1-BLDG2-206 ASBUILT DATE: NEEDS TO BE